

Addendum No. 3

Date: 05.24.2023

Project: Missouri Western State University - CTAC Building

All Prospective Bidders:

All bidders furnishing necessary materials and/or labor, this addendum is hereby part of the Contract Documents as though it were originally therein. Refer to Proposal Form for acknowledgement of Addenda.

Clarification:

- 1. A 2,500# bridge crane shall be provided in Shop 105, as noted on sheet A211. Bridge crane shall be 35'-0" wide x 103'-4"long with an overhead clearance of 20'-0". Crane rail power shall be 480v, see electrical drawings for additional information. Contact James Smith-Vandergriff with Anchor Sales; 816-836-5900.
- 2. See ASD001 for clarification on location for excess spoils.
- 3. The owner will provide and install all low voltage cabling to voice/data locations, access points, and security cameras as shown on the plans. Security cameras will be provided and installed by the owner.
- 4. OMIT requirement for fire retardant treatment for all wood blocking and plywood sheathing. The plywood decking, under the metal roof panel over the shop area, shall be fire retardant treated.
- **5.** Contractors shall include the access control scope of work in their bid. Access control system will be an extension of the universities existing system. Contractors shall contact Bryan Cooper, American Direct 913-754-3738 ext. 370.

Bidding Requirements

1. Liquidated damages of \$500/day will be enforced if work is not substantially complete by July 1, 2024.

Changes to Project Manual:

1. Section 00 0110 - TABLE OF CONTENTS

- 1. OMIT section 09 6566 Resilient Athletic Flooring
- 2. OMIT Section 09 6700 Fluid-Applied Flooring.

2. Section 07 2500 - WEATHER BARRIER

- **1.** 2.01.A.7 Products:
 - 1. ADD: CCW Barrithane VP as an approved product.

3. Section 08 4229 - AUTOMATIC OPERATORS

1. See revised section.

4. Section 08 4313 - ALUMINUM-FRAMED STOREFRONTS

- **1.** 2.01.A Storefront:
 - 1. ADD: Manko Window Systems 2450 as an approved product.
- 2. 2.02.A Wide Stile Doors
 - 1. ADD: Manko Window Systems 150 as an approved product.

5. <u>Section 08 4500 – TRANSLUCENT WALL AND ROOF ASSEMBLIES</u>

- 1. 2.01.A MANFACTURERS:
 - 1. ADD: Majors Industries Guardian 275 as an approved manufacturer/product.
 - 2. 2.04.A Sandwich Panel Assemblies:
 - 1. ADD:
 - 3. Performance:
 - a. Glazing U-Value: 0.14 BTU/hr sq ft degrees F maximum
 - b. Overall Ligth Transmittance (LT): 9 percent, nominal

6. Section 08 7100 - DOOR HARDWARE

1. See revised section.

7. Section 09 6813 - TILE CARPETING

1. See added section.

8. Section 12 2400 - WINDOW SHADES

- 1. 2.01.A Manufacturers:
 - 1. ADD: Windowtex 12830 as an approved manufacturer/product.
- 2. 2.03. Shade Fabric:
 - **1.** ADD: Mermet Corporation; Sparta Twilight for blackout curtains. Color: as selected by Architect from manufacturer's full range of colors.

Changes to Drawings:

CIVIL

1. Sheet C400 - UTILITY PLAN

1. See revised sheet.

2. Sheet C500 - STORM SEWER PROFILES

1. See revised sheet.

3. Sheet C600 - LIFT STATION/FORCE MAIN PLAN AND PROFILE

1. See revised sheet.

4. Sheet C1300 - DETAILS

1. See revised sheet.

ARCHITECTURAL

1. Sheet A211 - LEVEL 1 - FLOOR PLAN

1. See revised sheet.

2. Sheet A311 - REFLECTED CEILING PLAN

1. See revised sheet.

3. Sheet A622 - INTERIOR ELEVATIONS

1. See revised sheet.

4. Sheet A623 - INTERIOR ELEVATIONS

1. See revised sheet.

5. Sheet A721 - WALL SECTIONS

1. See revised sheet.

6. Sheet A821 - PLAN DETAILS

1. See revised sheet.

7. Sheet A831 - SECTION DETAILS

1. See revised sheet.

8. Sheet A911 - SCHEDULES

1. See revised sheet.

STRUCTURAL

1. Sheet S101 -LOW ROOF FRAMING PLAN

1. See revised sheet.

2. Sheet S103 -FOUNDATION PLAN - ALTERNATE BID #1

1. See added sheet.

3. Sheet S301 -ROOF FRAMING SECTIONS

1. See revised sheet.

4. Sheet S302 -ROOF FRAMING SECTIONS

1. See revised sheet.

5. Sheet S400 -FOUNDATION PLAN - BRACE ELEVATIONS

1. See revised sheet.

MECHANICAL

1. Sheet M100 - LEVEL 1 - MECHANICAL

1. See revised sheet.

2. Sheet M300 - MECHANICAL SCHEDULES, GENERAL NOTED & SYMBOLS

1. See revised sheet.

ELECTRICAL

1. Sheet E001 - ELECTRICAL SITE PLAN

1. See revised sheet.

2. Sheet E100 - LEVEL 1 - POWER

1. See revised sheet.

3. Sheet E200 - LEVEL 1 - LIGHTING

1. See revised sheet.

4. Sheet E300 - LEVEL SYSTEMS

1. See revised sheet.

5. Sheet E301 - ROOF PLAN - SYSTEMS

1. See revised sheet.

6. Sheet E501 - ELECTRICAL SCHEDULES

1. See revised sheet.

7. Sheet E502 - ELECTRICAL SCHEDULES

1. See revised sheet.

8. Sheet E503 - ELECTRICAL SCHEDULES, GENERAL NOTES, SYMBOLS & RISER

1. See revised sheet.

PLUMBING

- 1. Sheet P100 LEVEL 1 WASTE/VENT
 - 1. See reviewed sheet.
- 2. Sheet P101 LEVEL 1 WATER
 - 1. See reviewed sheet.
- 3. Sheet P102 LEVEL 1 NATURAL GAS
 - 1. See reviewed sheet.
- 4. Sheet P400 PLUMBING SCHEDULES, GENERAL NOTES & SYMBOLS
 - 1. See reviewed sheet.

FIRE PROTECTION

1. No Revisions

END OF ADDENDUM

SECTION 08 4229 AUTOMATIC ENTRANCES

PART 1 GENERAL

1.01 SECTION INCLUDES

- A. Swinging type packaged power-operated door assemblies.
- B. Operators for doors provided in other sections.
- C. Controllers, actuators and safety devices.

1.02 RELATED REQUIREMENTS

1.03 REFERENCE STANDARDS

A. NFPA 101 - Life Safety Code Most Recent Edition Adopted by Authority Having Jurisdiction, Including All Applicable Amendments and Supplements.

1.04 SUBMITTALS

- A. See Section 01 3000 Administrative Requirements for submittal procedures.
- B. Shop Drawings:
 - Indicate layout and dimensions; head, jamb, and sill conditions; elevations; components, anchorage, recesses, materials, and finishes, electrical characteristics and connection requirements.
- C. Product Data: Include system components, sizes, features, and finishes.
- D. Manufacturer's Installation Instructions: Indicate special procedures, perimeter conditions requiring special attention, and manufacturer's hardware and component templates.
- E. Manufacturer's qualification statement.
- F. Installer's qualification statement.
- G. Maintenance Data: Include manufacturer's parts list and maintenance instructions for each type of hardware and operating component.
- H. Maintenance Materials: Furnish the following for Owner's use in maintenance of project.
 - 1. Wrenches and other tools required for maintenance of equipment.

1.05 QUALITY ASSURANCE

- A. Manufacturer Qualifications: Company specializing in manufacturing products specified in this section, with not less than three years of documented experience, and a member of AAADM.
- B. Installer Qualifications: Company specializing in performing work of the type specified and with at least three years documented experience and approved by manufacturer.

1.06 WARRANTY

- A. See Section 01 7800 Closeout Submittals for additional warranty requirements.
- B. Extended Correction Period: Correct defective work within five-year period commencing on Date of Substantial Completion.

PART 2 PRODUCTS

2.01 MANUFACTURERS

- A. Swinging Automatic Entrance Door Assemblies:
 - 1. ASSA ABLOY Entrance Solutions; Besam SW200i
 - 2. Horton Automatics; Series 4000LE: www.hortondoors.com/#sle.
 - 3. Detex A0-19
 - 4. Record HA-9
 - 5. Substitutions: See Section 01 6000 Product Requirements.

2.02 POWER OPERATED DOORS

- A. Power Operated Doors: Provide products that comply with NFPA 101 and requirements of authorities having jurisdiction; provide equipment selected for actual door weight and for light pedestrian traffic, unless otherwise indicated.
 - 1. Swinging Door Operators: Fully adjustable for opening and closing speeds, checking speeds, and hold-open time; in the event of power failure, disengage operator allowing door to function as a door with a spring closer.

2.03 CONTROLLERS, ACTUATORS, AND SAFETIES

- A. Push Plate Actuator: Standard jamb mounted, recessed momentary contact type; satin stainless steel plate; 4 inches diameter; labeled PUSH.
- B. Push Button Actuator: Standard momentary contact type, wall mounted, surface; stainless steel escutcheon plate.

PART 3 EXECUTION

3.01 EXAMINATION

- A. Verify that surfaces are ready to receive work and dimensions are as indicated on shop drawings.
- B. Verify that electric power is available and is of the correct characteristics.

3.02 INSTALLATION

A. Install equipment in accordance with manufacturer's instructions.

3.03 ADJUSTING

A. Adjust door equipment for correct function and smooth operation.

3.04 CLEANING

A. Remove temporary protection, clean exposed surfaces.

3.05 MAINTENANCE

A. Provide service and maintenance of operating equipment for one year from Date of Substantial Completion, at no extra charge to Owner.

END OF SECTION

HARDWARE SET # 1A

Access Control – Exterior Double Door w/ Operator 100

Qty		Description	Catalog Number	Finish	Mfr.
2	EA	CONT. HINGE	112HD/224HD EPT	628	IVE
2	EA	POWER TRANSFER	EPT 10	689	VON
1	EA	KEYED REMOVABLE MULLION	KR4954	689	VON
1	EA	ELEC PANIC HARDWARE	RX-LC-QEL+-99-EO - DT	626	VON
1	EA	ELEC PANIC HARDWARE	RX-LC-QEL+-99-996L-NL	626	VON
1	EA	LFIC RIM HOUSING	20-079	626	SCH
1	EA	LFIC MORTISE HOUSING	30-007	626	SCH
2	EA	LFIC CORE BY OWNER	LFIC CORE BY OWNER	626	SCH
1	EA	SURFACE CLOSER	4040XP SCUSH	689	LCN
1	EA	SURFACE AUTO OPERATOR	4642	689	LCN
1	EA	ACTUATOR PACKAGE JAMB MT.	8310-3822TW	630	LCN
1	EA	DRIP CAP	16A	CL	NGP
2	EA	DOOR SWEEP	C627A	CL	NGP
1	EA	THRESHOLD	425	AL	NGP
1	EA	MULTI-TECH READER	ACCESS CONTROL CONTR. PROVIDED	BLK	SCE
2	EA	DOOR CONTACT	7764	628	SCE
1	EA		WEATHERSTRIPING BY DOOR MANUF.		

HARDWARE SET # 1B

Access Control – Exterior Single Door

7100033	COTTETO	Exterior single	. 2001					
105B		105D	106B	112C	113C	117B		
Qty		Description		Catalog Nun	nber		Finish	Mfr.
1	EA	CONT. HINGE		112HD/224F	ID EPT		628	IVE
1	EA	POWER TRANS	SFER	EPT 10			689	VON
1	EA	ELEC PANIC HA	ARDWARE	RX-LC-QEL+-	·996L		626	VON
1	EA	LFIC RIM HOU	SING	20-079			626	SCH
1	EA	LFIC CORE BY	OWNER	LFIC CORE B	Y OWNER		626	SCH
1	EA	SURFACE CLOS	SER	4040XP SCU	SH		689	LCN
1	EA	DRIP CAP		16A			CL	NGP
1	EA	DOOR SWEEP		C627A			CL	NGP
1	EA	THRESHOLD		425			AL	NGP
1	EA	MULTI-TECH R	EADER	ACCESS CON	ITROL CONTR. PR	OVIDED	BLK	SCE
1	EA	DOOR CONTAC	CT	7764			628	SCE
1	EA			WEATHERST	RIPING BY DOOR	MANUF.		

HARDWARE SET # 1C

HARD	WAR	E SET # 1C						
Acces	s Con	trol – Interior S	ingle Door –	Entrance Locks	et			
102		106	108	110	112A	113A	116	;
117A		119	120					
Qty		Description		Catalog N	umber		Finish	Mfr.
3	EA	HW HINGE		55BB1HW	4.5 x 4.5		652	IVE
1	EA	STOREROOM	1 LOCK	L9080JD 0	06A		626	SCH
1	EA	LFIC CORE		LFIC CORE	BY OWNER		626	SCH
1	EA	ELECTRIC STI	RIKE	6210 FSE			630	VON

EA/ Missouri Western State University –

CTAC Building DOOR HARDWARE

1	EA	SURFACE CLOSER	40404XP SCUSH	689	LCN
3	EA	SILENCER	SR64	GRY	IVE
1	EA	MULTI-TECH READER	ACCESS CONTROL CONTR. PROVIDED	BLK	SCE
1	EA	DOOR CONTACT	7764	628	SCE

HARDWARE SET # 1D

Access Control – Interior Double Door **105A**

Qty		Description	Catalog Number	Finish	Mfr.
2	EA	CONT. HINGE	112HD/224HD EPT	628	IVE
2	EA	POWER TRANSFER	EPT 10	689	VON
1	EA	KEYED REMOVABLE MULLION	KR4954	689	VON
1	EA	ELEC PANIC HARDWARE	RX-LC-QEL+-99-EO -996L- DT	626	VON
1	EA	ELEC PANIC HARDWARE	RX-LC-QEL+-99L-996L	626	VON
1	EA	LFIC RIM HOUSING	20-079	626	SCH
1	EA	LFIC CORE BY OWNER	LFIC CORE BY OWNER	626	SCH
1	EA	SURFACE CLOSER	4040XP SCUSH	689	LCN
1	EA	MULTI-TECH READER	ACCESS CONTROL CONTR. PROVIDED	BLK	SCE
2	EA	DOOR CONTACT	7764	628	SCE

HARDWARE SET # 1E

Access Control – interior Double Door

		111 121			
Qty		Description	Catalog Number	Finish	Mfr.
2	EA	CONT. HINGE	112HD/224HD EPT (LHR ONLY)	628	IVE
1	EA	POWER TRANSFER	EPT 10	689	VON
1	EA	STOREROOM LOCKSET	L9080JD 06A 626	626	SCH
1	EA	LFIC CORE BY OWNER	LFIC CORE BY OWNER	626	SCH
1	EA	ELECTRIC STRIKE	6223 x 24VDC x FSE	630	VON
2	EA	SURFACE CLOSER	4040XP SCUSH	689	LCN
1	EA	COORDINATOR	COR52 FL MB AS REQUIRED	689	IVE
1	EA	CONSTANT LATCHING FB	FB51P	630	IVE
1	EA	MULTI-TECH READER	ACCESS CONTROL CONTR. PROVIDED	BLK	SCE
2	EA	DOOR CONTACT	7764	628	SCE

HARDWARE SET # 2

Interior Storefront Double Door w/ Operator 101A

Qty			Description	Catalog Number	Finish	Mfr.
	2	EA	CONT. HINGE	112HD/224HD EPT	628	IVE
	2	EA	90 DEG OFFSET PULL	8190HD 10" O	630	IVE
	1	EA	SURFACE AUTO OPERATOR	4642	689	LCN
	1	EA	ACTUATOR PACKAGE JAMB	8310-3822TW	630	LCN
			MT.			

HARDWARE SET # 3

Stora	age	Room [Doors - Single				
107			109	114	115		
Qty			Description		Catalog Number	Finish	Mfr.
	3	EA	HW HINGE		5BB1HW 4.5 x 4.5	652	IVE
	1	EA	STOREROOM LO	СК	L9080JD 06A	626	SCH
	1	EA	LFIC CORE BY O	WNER	LFIC CORE BY OWNER	626	SCH
	1	EA	SURFACE CLOSE	R	4040XP SCUSH	689	LCN
	1	EA	WALL STOP		WS406/407/CCV	630	IVE
	3	EA	SILENCER		SR64	GRY	IVE
		VARE SE	T # 4 s – Push/Pull 118				
Qty			Description		Catalog Number	Finish	Mfr.
٦٠,	3	EA	HW HINGE		5BB1HW 4.5 x 4.5	652	IVE
	1	EA	PUSH PLATE		8200 4" x 16"	626	IVE
	1	EA	PULL PLATE		8303 10" 4" x 16"	626	IVE
	1	EA	SURFACE CLOSE	R	4040XP	689	LCN
	1	EA	FLOOR STOP		FS444	626	IVE
	3	EA	SILENCER		SR64	GRY	IVE

SECTION 08 7100 DOOR HARDWARE

PART 1 GENERAL

1.01 SECTION INCLUDES

- A. Hardware for aluminum and hollow metal doors.
- B. Electrically operated and controlled hardware.
- C. Lock cylinders for doors that hardware is specified in other sections.
- D. Thresholds.
- E. Weatherstripping and gasketing.

1.02 RELATED REQUIREMENTS

- A. Section 08 1113 Hollow Metal Doors and Frames.
- B. Section 08 1416 Flush Wood Doors.
- C. Section 08 4313 Aluminum-Framed Storefronts: Door hardware, except as noted in section.

1.03 REFERENCE STANDARDS

- A. ADA Standards 2010 ADA Standards for Accessible Design 2010.
- B. BHMA A156.1 Standard for Butts and Hinges 2021.
- C. BHMA A156.3 Exit Devices 2020.
- D. BHMA A156.4 Door Controls Closers 2019.
- E. BHMA A156.5 Cylinders and Input Devices for Locks 2020.
- F. BHMA A156.6 Standard for Architectural Door Trim 2021.
- G. BHMA A156.8 Door Controls Overhead Stops and Holders 2021.
- H. BHMA A156.13 Mortise Locks & Latches Series 1000 2017.
- I. BHMA A156.16 Auxiliary Hardware 2018.
- J. BHMA A156,21 Thresholds 2019.
- K. BHMA A156.22 Standard for Gasketing 2021.
- L. BHMA A156.26 Standard for Continuous Hinges 2021.
- M. BHMA A156.31 Electric Strikes and Frame Mounted Actuators 2019.
- N. DHI (LOCS) Recommended Locations for Architectural Hardware for Standard Steel Doors and Frames 2004.
- O. ITS (DIR) Directory of Listed Products Current Edition.
- P. UL (DIR) Online Certifications Directory Current Edition.

1.04 SUBMITTALS

- A. See Section 01 3000 Administrative Requirements, for submittal procedures.
- B. Product Data: Manufacturer's catalog literature for each type of hardware, marked to clearly show products to be furnished for this project, and includes construction details, material descriptions, finishes, and dimensions and profiles of individual components.
- C. Shop Drawings Door Hardware Schedule: Submit detailed listing that includes each item of hardware to be installed on each door. Use door numbering scheme as included in Contract Documents.
 - 1. Provide complete description for each door listed.
- D. Shop Drawings Electrified Door Hardware: Submit diagrams for power, signal, and control wiring for electrified door hardware that include details of interface with building safety and security systems. Provide elevations and diagrams for each electrified door opening as follows:

- 1. Elevations: Submit front and back elevations of each door opening showing electrified devices with connections installed and an operations narrative describing how opening operates from either side at any given time.
- 2. Diagrams: Submit point-to-point wiring diagram that shows each device in door opening system with related colored wire connections to each device.

1.05 DELIVERY, STORAGE, AND HANDLING

 Package hardware items individually; label and identify each package with door opening code to match door hardware schedule.

1.06 WARRANTY

- A. See Section 01 7800 Closeout Submittals, for additional warranty requirements.
- B. Warranty against defects in material and workmanship for period indicated, from Date of Substantial Completion.

PART 2 PRODUCTS

2.01 DESIGN AND PERFORMANCE CRITERIA

- A. Provide specified door hardware as required to make doors fully functional, compliant with applicable codes, and secure to extent indicated.
- B. Provide individual items of single type, of same model, and by same manufacturer.
- C. Provide door hardware products that comply with the following requirements:
 - 1. Hardware on Fire-Rated Doors: Listed and classified by UL (DIR), ITS (DIR), or testing firm acceptable to authorities having jurisdiction as suitable for application indicated.

2.02 HINGES

- A. Manufacturers:
 - 1. Hager Companies
 - 2. Ives, an Allegion brand.
 - 3. Substitutions: See Section 01 6000 Product Requirements.
- B. Hinges: Comply with BHMA A156.1, Grade 1.
 - 1. Continuous Hinges at aluminum storefront doors: Comply with BHMA A156.26.
 - 2. Provide hinges on every swinging door.
 - 3. Provide five-knuckle full mortise butt hinges unless otherwise indicated.
 - 4. Provide ball-bearing hinges at each door with closer.
 - 5. Provide non-removable pins on exterior outswinging hollow metal doors.
 - 6. Provide non-removable pins on interior outswinging doors at locations as indicated.
 - 7. Provide power transfer hinges where electrified hardware is mounted in door leaf.
 - 8. Provide following quantity of butt hinges for each door:
 - a. Doors up to 60 inches High: Two hinges.
 - b. Doors From 60 inches High up to 90 inches High: Three hinges.

2.03 FLUSH BOLTS

- A. Manufacturers:
 - 1. Ives, an Allegion brand; FB458
 - 2. Substitutions: See Section 01 6000 Product Requirements.
- B. Flush Bolts: Comply with BHMA A156.16, Grade 1.
 - 1. Flush Bolt Throw: 3/4 inch, minimum.
 - 2. Provides extension bolts in leading edge of door, one bolt into floor, one bolt into top of frame.
 - a. Pairs of Swing Doors: At inactive leaves, provide flush bolts of type as required to comply with code.
 - 3. Provide dustproof floor strike for bolt into floor, except at metal thresholds.
 - 4. Manual Flush Bolts: Provide lever extensions for top bolt at over-sized doors.

2.04 EXIT DEVICES

- A. Manufacturers:
 - 1. Von Duprin, an Allegion brand; 99 Series
 - 2. Substitutions: Not permitted.
- B. Exit Devices: Comply with BHMA A156.3, Grade 1.
 - Lever design to match lockset trim.
 - Provide cylinder with cylinder dogging or locking trim.
 - 3. Provide exit devices properly sized for door width and height.
 - 4. Provide strike as recommended by manufacturer for application indicated.
 - 5. Provide UL (DIR) listed exit device assemblies for fire-rated doors and panic device assemblies for non-fire-rated doors.

2.05 ELECTRIC STRIKES

- A. Manufacturers:
 - 1. Von Duprin 6200 Series.
 - 2. Substitutions: See Section 01 6000 Product Requirements.
- B. Electric Strikes: Comply with BHMA A156.31, Grade 1.
 - 1. Provide UL (DIR) listed burglary-resistant electric strike; style to suit locks.
 - 2. Provide non-handed 24 VDC electric strike suitable for door frame material and scheduled lock configuration.

2.06 LOCK CYLINDERS

- A. Lock Cylinders: Provide key access on outside of each lock, unless otherwise indicated.
 - 1. Provide large format interchangeable cores type cylinders, Grade 1, with seven-pin core in compliance with BHMA A156.5 at locations indicated.
 - 2. Provide cylinders from same manufacturer as locking device.
 - 3. Provide cams and/or tailpieces as required for locking devices.
 - 4. Permanent cores provided by owner.

2.07 MORTISE LOCKS

- A. Manufacturers:
 - 1. Schlage, an Allegion brand; L Series:
 - 2. Substitutions: Not permitted.
- B. Mortise Locks: Comply with BHMA A156.13, Grade 1.
 - 1. Latchbolt Throw: 3/4 inch, minimum.
 - 2. Deadbolt Throw: 1 inch. minimum.
 - 3. Backset: 2-3/4 inch unless otherwise indicated.
 - 4. Strikes: Provide manufacturer's standard strike for each latchset or lockset with strike box and curved lip extending to protect frame in compliance with indicated requirements.
 - a. Finish: To match lock or latch.

2.08 DOOR PULLS AND PUSH PLATES

- A. Manufacturers:
 - 1. IVES.
 - 2. Substitutions: See Section 01 6000 Product Requirements.
- B. Door Pulls and Push Plates: Comply with BHMA A156.6.
 - 1. Pull Type: Straight, unless otherwise indicated.
 - 2. Push Plate Type: Flat, with square corners, unless otherwise indicated.
 - a. Edges: Beveled, unless otherwise indicated.
 - 3. Material: Aluminum, unless otherwise indicated.

2.09 CLOSERS

A. Manufacturers; Surface Mounted:

- 1. LCN, an Allegion brand; 4040XP Series
- 2. Substitutions: Not permitted.
- B. Closers: Comply with BHMA A156.4, Grade 1.
 - 1. Type: Surface mounted to door.
 - 2. Provide door closer on each exterior door.
 - 3. Provide door closer on each fire-rated and smoke-rated door.
 - 4. At outswinging exterior doors, mount closer on interior side of door.

2.10 OVERHEAD STOPS AND HOLDERS

- A. Manufacturers:
 - Glynn-Johnson, an Allegion brand; 90 Series
- B. Overhead Stops and Holders (Door Checks): Comply with BHMA A156.8, Grade 1.
 - 1. Provide stop for every swinging door, unless otherwise indicated.

2.11 WALL STOPS

- A. Wall Stops: Comply with BHMA A156.16, Grade 1 and Resilient Material Retention Test as described in this standard.
 - 1. Type: Bumper, concave, wall stop.
 - 2. Material: Aluminum housing with rubber insert.

2.12 THRESHOLDS

- A. Manufacturers:
 - 1. Pemko; an Assa Abloy Group company
 - 2. National Guard Products, Inc.
 - 3. Substitutions: See Section 01 6000 Product Requirements.
- B. Thresholds: Comply with BHMA A156.21.
 - 1. Provide threshold at each exterior door, unless otherwise indicated.
 - 2. Type: Flat surface.
 - 3. Material: Aluminum.
 - 4. Threshold Surface: Fluted horizontal grooves across full width.
 - 5. Field cut threshold to profile of frame and width of door sill for tight fit.
 - 6. Provide non-corroding fasteners at exterior locations.

2.13 WEATHERSTRIPPING AND GASKETING

- A. Manufacturers:
 - 1. Pemko; an Assa Abloy Group company
 - 2. National Guard Products, Inc.
 - 3. Substitutions: See Section 01 6000 Product Requirements.
- B. Weatherstripping and Gasketing: Comply with BHMA A156.22.
 - 1. Head and Jamb Type: Adjustable.
 - 2. Door Sweep Type: Encased in retainer.
 - 3. Material: Aluminum, with brush weatherstripping.
 - 4. Provide weatherstripping on each exterior door at head, jambs, and meeting stiles of door pairs, unless otherwise indicated; .

2.14 SILENCERS

- A. Silencers: Provide at equal locations on door frame to mute sound of door's impact upon closing.
 - 1. Single Door: Provide three on strike jamb of frame.
 - 2. Pair of Doors: Provide two on head of frame, one for each door at latch side.
 - 3. Material: Rubber, gray color.

2.15 POWER SUPPLY

- A. Power Supply: Hard wired, with multiple zones providing eight (8) breakers for each output panel with individual control switches and LED's; UL (DIR) Class 2 listed.
 - 1. Power: 24 VAC, 10 Amp; with 120 VAC power supply.
 - 2. Operating Temperature: 32 to 110 degrees F.
 - Provide with emergency release terminals that release devices upon activation of fire alarm system.

2.16 FINISHES

A. Finishes: Identified in Door Hardware Schedule.

PART 3 EXECUTION

3.01 EXAMINATION

A. Verify that doors and frames are ready to receive this work; labeled, fire-rated doors and frames are properly installed, and dimensions are as indicated on shop drawings.

3.02 INSTALLATION

- A. Install hardware in accordance with manufacturer's instructions and applicable codes.
- B. Use templates provided by hardware item manufacturer.
- C. Do not install surface mounted items until application of finishes to substrate are fully completed.
- D. Door Hardware Mounting Heights: Distance from finished floor to center line of hardware item. As indicated in following list; unless noted otherwise in Door Hardware Schedule or on drawings.
 - 1. For Steel Doors and Frames: Install in compliance with DHI (LOCS) recommendations.
 - 2. For Steel Doors and Frames: Refer to Section 08 1113.
 - 3. For Aluminum-Framed Storefront Doors and Frames: Refer to Section 08 4313.
 - 4. Mounting heights in compliance with ADA Standards:
 - a. Locksets: 40-5/16 inch.
 - b. Push Plates/Pull Bars: 42 inch.
 - c. Deadlocks (Deadbolts): 48 inch.
 - d. Exit Devices: 40-5/16 inch.
 - e. Door Viewer: 43 inch; standard height 60 inch.
- E. Set exterior door thresholds with full-width bead of elastomeric sealant at each point of contact with floor providing a continuous weather seal; anchor thresholds with stainless steel countersunk screws.

3.03 ADJUSTING

- A. Adjust work under provisions of Section 01 7000 Execution and Closeout Requirements.
- B. Adjust hardware for smooth operation.
- Adjust gasketing for complete, continuous seal; replace if unable to make complete seal.

3.04 CLEANING

- A. Clean finished hardware in accordance with manufacturer's written instructions after final adjustments have been made.
- B. Clean adjacent surfaces soiled by hardware installation.
- Replace items that cannot be cleaned to manufacturer's level of finish quality at no additional cost.

END OF SECTION

SECTION 09 6813 TILE CARPETING

PART 1 GENERAL

1.01 SECTION INCLUDES

A. Carpet tile, fully adhered.

1.02 RELATED REQUIREMENTS

1.03 REFERENCE STANDARDS

- A. ASTM F710 Standard Practice for Preparing Concrete Floors to Receive Resilient Flooring 2022.
- B. ASTM F1869 Standard Test Method for Measuring Moisture Vapor Emission Rate of Concrete Subfloor Using Anhydrous Calcium Chloride 2022.
- C. ASTM F2170 Standard Test Method for Determining Relative Humidity in Concrete Floor Slabs Using in situ Probes 2019a.

1.04 SUBMITTALS

- A. See Section 01 3000 Administrative Requirements, for submittal procedures.
- B. Product Data: Provide data on specified products, describing physical and performance characteristics; sizes, patterns, colors available, and method of installation.
- Samples: Submit two carpet tiles illustrating color and pattern design for each carpet color selected.
- D. Manufacturer's Installation Instructions: Indicate special procedures and perimeter conditions requiring special attention.
- E. Manufacturer's Qualification Statement.
- F. Installer's Qualification Statement.
- G. Operation and Maintenance Data: Include maintenance procedures, recommended maintenance materials, and suggested schedule for cleaning.
- H. Maintenance Materials: Furnish the following for Owner's use in maintenance of project.
 - 1. See Section 01 6000 Product Requirements, for additional provisions.
 - 2. Extra Carpet Tiles: Quantity equal to 5 percent of total installed of each color and pattern installed.

1.05 QUALITY ASSURANCE

- A. Manufacturer Qualifications: Company specializing in manufacturing specified carpet tile with minimum three years documented experience.
- B. Installer Qualifications: Company specializing in installing carpet tile with minimum three years documented experience and approved by carpet tile manufacturer.

PART 2 PRODUCTS

2.01 MANUFACTURERS

- A. Tile Carpeting:
 - J&J Fllooring Group, LLC; Joe Dineen (785) 550-5300.

2.02 MATERIALS

- A. Tile Carpeting, Type C1: Tufted, manufactured in one color dye lot.
 - 1. Product: Incognito manufactured by J&J Flooring Group, LLC.
 - 2. Tile Size: 24 by 24 inch, nominal.
 - 3. Color: as indicated on the drawings.
 - 4. Pattern: as indicated on the drawings.
- B. Tile Carpeting: Type C2: Tufted, manufactured in one color dye lot.
 - Product: kinetix Foundry manufactured by J&J Flooring Group, LLC

- 2. Tile Size: 24 by 24 inch nominal
- Color: as indicated on the drawings.
- pattern: as indicated on the drawings.

2.03 ACCESSORIES

- A. Subfloor Filler: White premix latex; type recommended by flooring material manufacturer.
- B. Edge Strips: Embossed aluminum, clear color.
- C. Carpet Tile Adhesive: Recommended by carpet tile manufacturer; releasable type, for high moisture levels up to 99% RH

PART 3 EXECUTION

3.01 EXAMINATION

- A. Verify that subfloor surfaces are smooth and flat within tolerances specified for that type of work and are ready to receive carpet tile.
- B. Verify that subfloor surfaces are dust-free and free of substances that could impair bonding of adhesive materials to subfloor surfaces.
- C. Cementitious Subfloor Surfaces: Verify that substrates are ready for flooring installation by testing for moisture and alkalinity (pH).
 - 1. Test as Follows:
 - a. Alkalinity (pH): ASTM F710.
 - b. Internal Relative Humidity: ASTM F2170.
 - c. Moisture Vapor Emission: ASTM F1869.
 - 2. Obtain instructions if test results are not within limits recommended by flooring material manufacturer and adhesive materials manufacturer.


3.02 PREPARATION

- A. Prepare floor substrates as recommended by flooring and adhesive manufacturers.
- B. Remove subfloor ridges and bumps. Fill minor or local low spots, cracks, joints, holes, and other defects with subfloor filler.
- C. Apply, trowel, and float filler to achieve smooth, flat, hard surface. Prohibit traffic until filler is cured.
- D. Vacuum clean substrate.

3.03 INSTALLATION

- A. Starting installation constitutes acceptance of subfloor conditions.
- B. Install carpet tile in accordance with manufacturer's instructions.
- C. Blend carpet from different cartons to ensure minimal variation in color match.
- D. Cut carpet tile clean. Fit carpet tight to intersection with vertical surfaces without gaps.
- E. Lay carpet tile in square pattern, with pile direction parallel to next unit, set parallel to building lines
- F. Locate change of color or pattern between rooms under door centerline.
- G. Fully adhere carpet tile to substrate.
- H. Trim carpet tile neatly at walls and around interruptions.
- I. Complete installation of edge strips, concealing exposed edges.

END OF SECTION

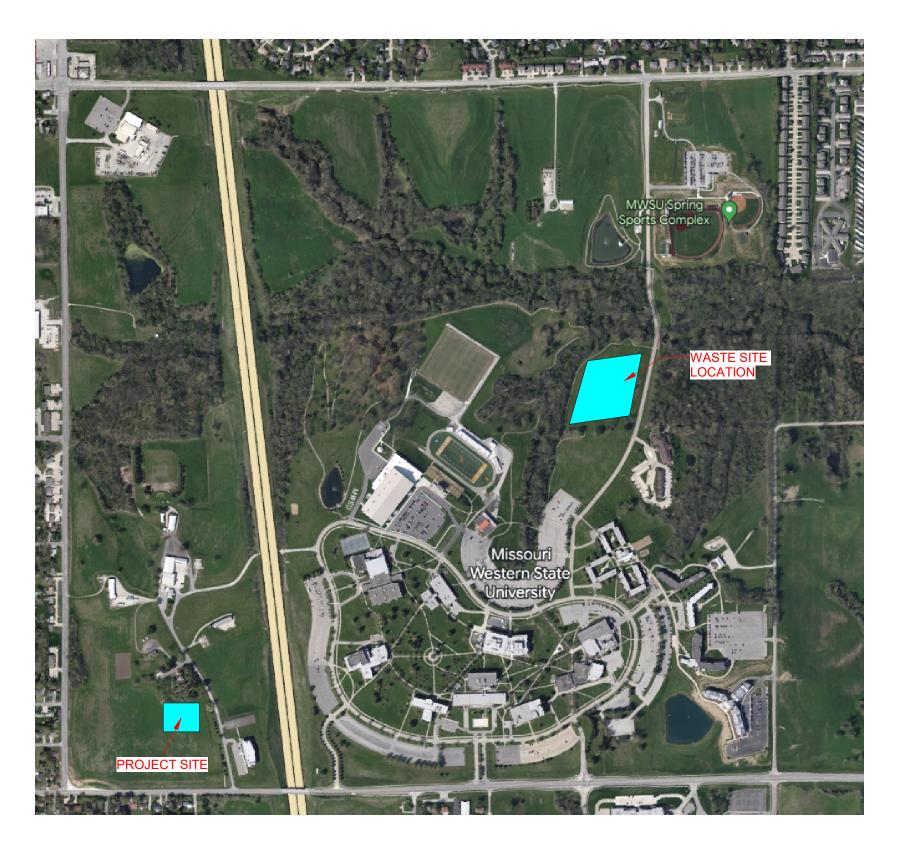


UNIVERSITY
4525 DOWNS DRIVE
ST. JOSEPH, MO 64507

DETAIL REF: DATE:

EXCESS SPOILS CLARIFICATION

ASD 001

CAMPUS PLAN - EXCESS SPOILS SITE CLARIFICATION

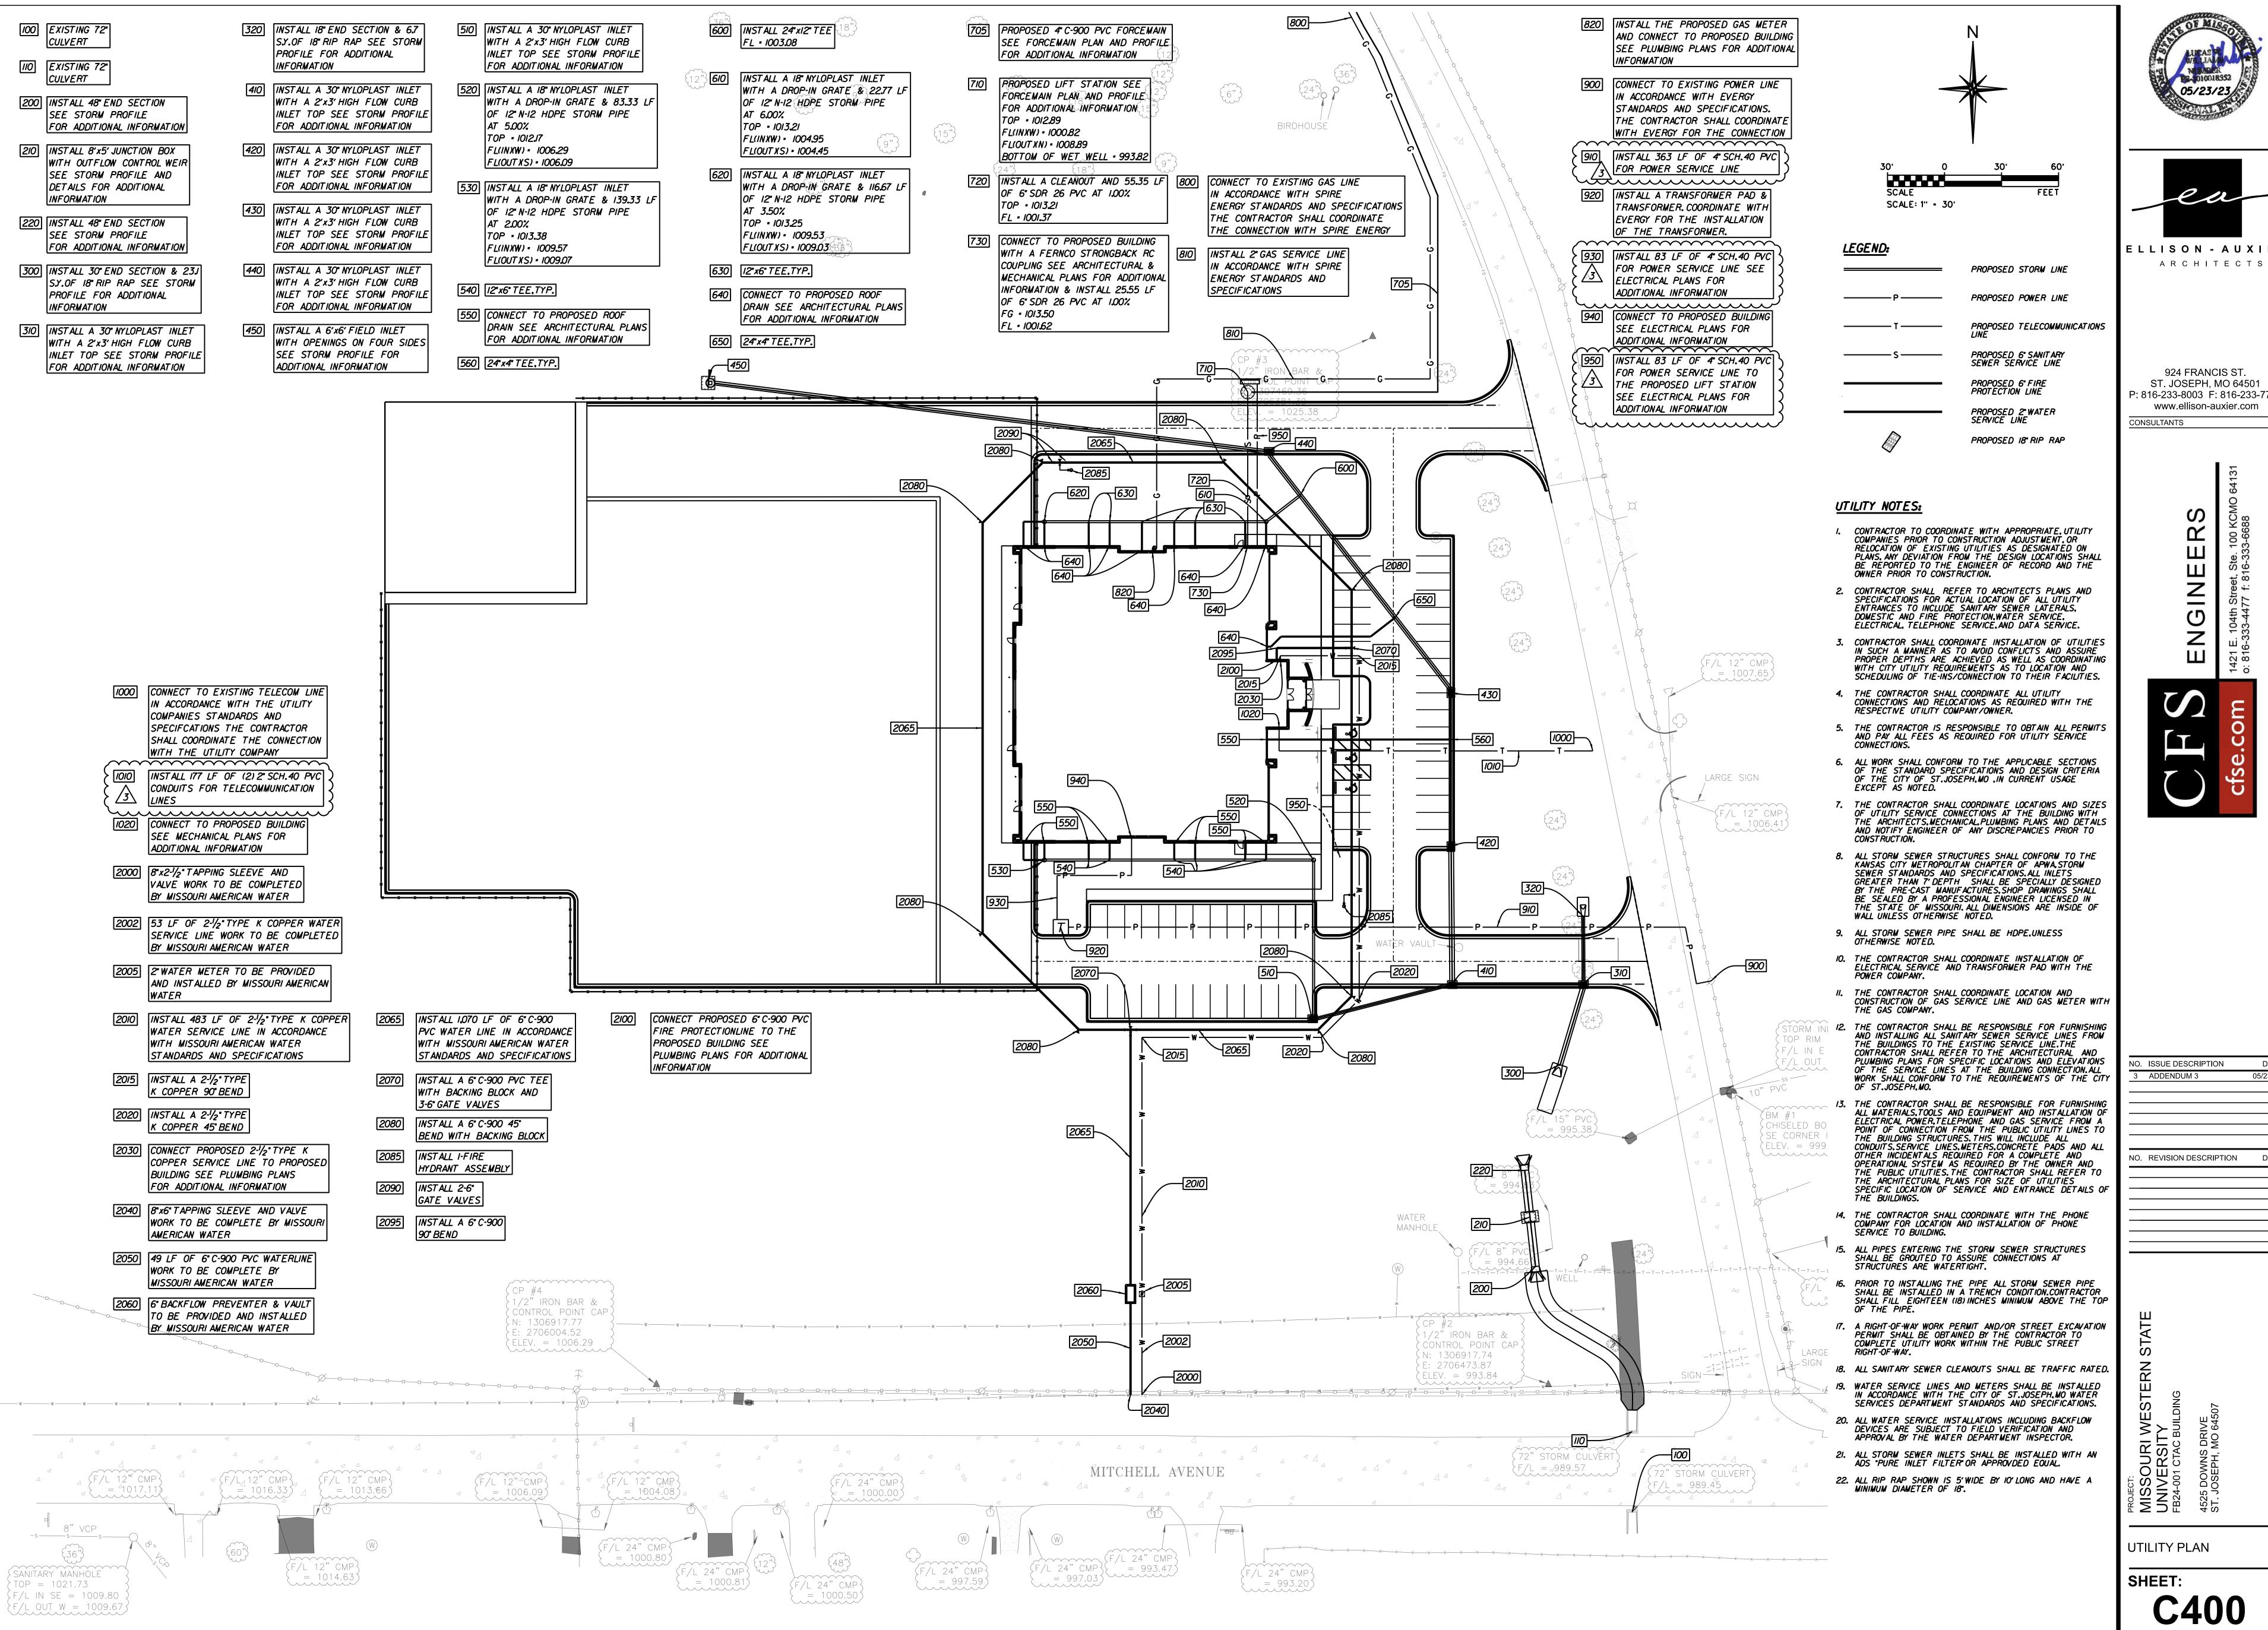





924 FRANCIS ST. ST. JOSEPH. MO 64501 P: 816-233-8003 F: 816-233-7793 www.ellison-auxier.com

Ш Ш \mathbf{Z} (1) Ш

NO. ISSUE DESCRIPTION ADDENDUM 3

NO. REVISION DESCRIPTION

UTILITY PLAN



ELLISON - AUXIER ARCHITECTS


924 FRANCIS ST. ST. JOSEPH, MO 64501 P: 816-233-8003 F: 816-233-7793 www.ellison-auxier.com CONSULTANTS


DATE 05/23/23

STORM SEWER PROFILES

SHEET:

235126-ST-SH-Storm-Profile.dgn 5/24/2023 1:44:07 PM

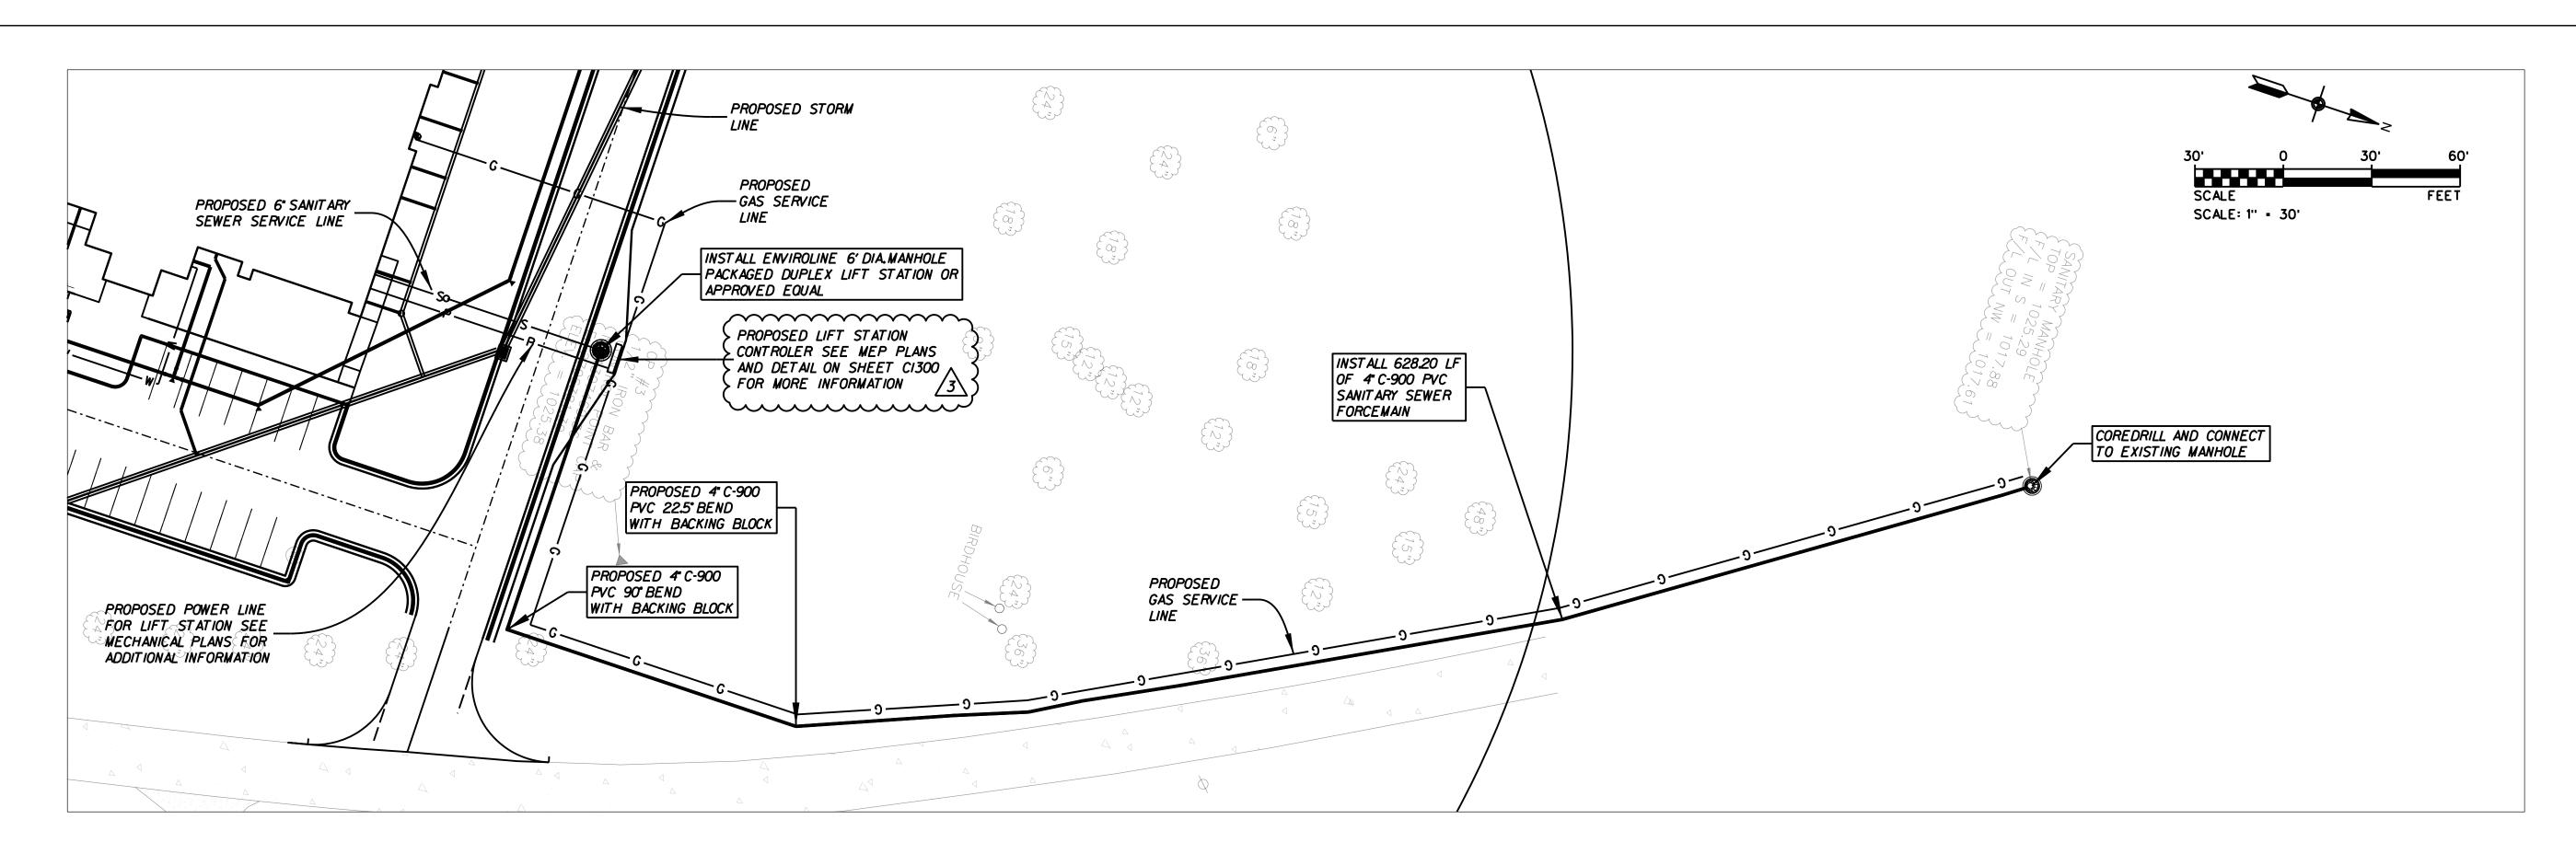

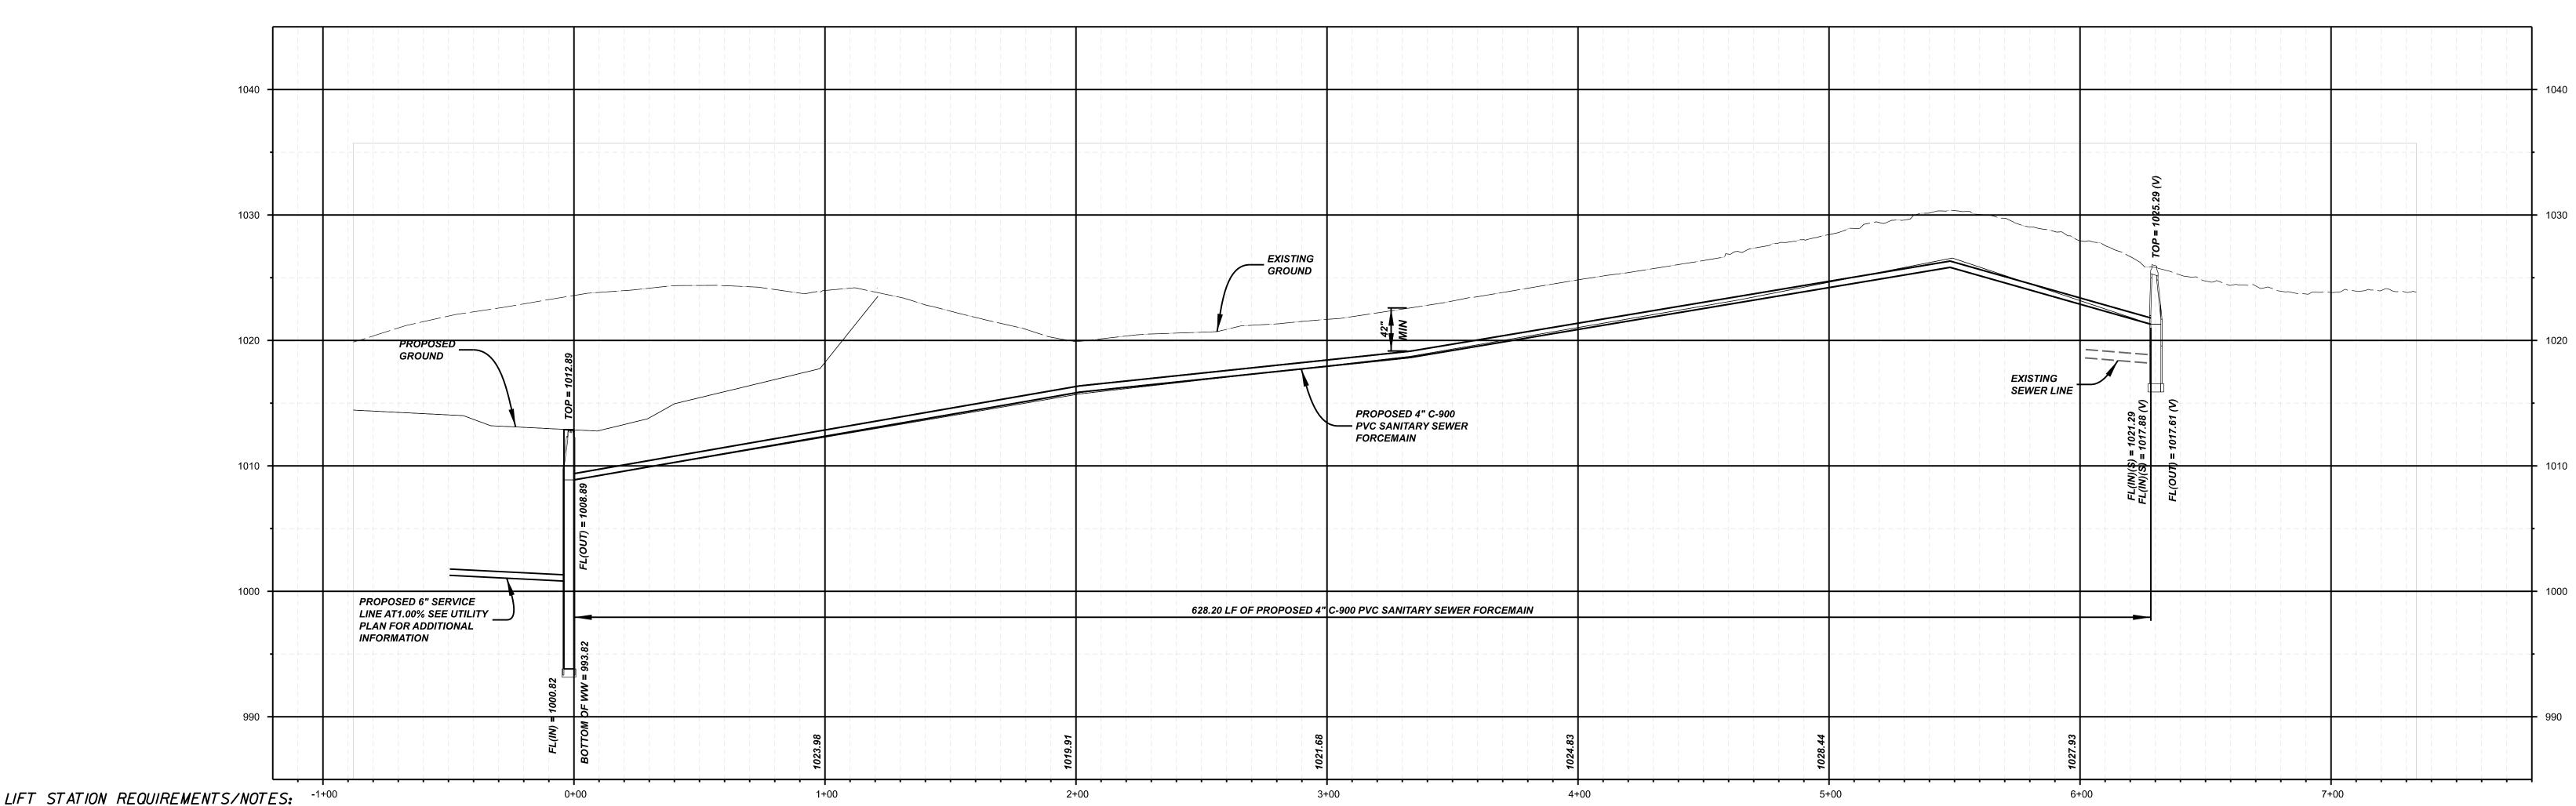

Each station will be complete with all needed equipment, factory installed on a welded steel base plate with a hinged, insulated, fiberglass cover on a 6' diameter wet well with a concrete cap. The standard items of equipment for each station shall include two 4' KRT F 100-215/44XEG-S 1E3 Recessed impeller solids handling, motor driven, non-clog sewage pumps; valves, internal piping, ventilating blower, priming pumps with all appurtenances, and all internal wiring. **OPERATING CONDITIONS**

Each pump shall be capable of delivering 94 GPM of row unscreened sewage against a total dynamic head of 22 feet. The minimum motor speed shall be 1750 RPM. The maximum rated horsepower of the pump motor shall be 5 HP. Pump hydraulic efficiency shall be approximately 55%. The maximum static suction lift capacity is 20 feet (including station piping) from pump centerline to the "Off" elevation float switch.

All openings and passages shall be large enough to permit the passage of three-inch spherical solids and any trash or three-inch stringy material which will pass through a four-inch house collection system. The initial anticipated operating head range is from 19.0 feet minimum to 22.0 feet maximum. Friction losses of the packaged pump system shall be included in the calculation of brake horsepower, impeller trims, and total system efficiency. **CONSTRUCTION:**

Each station shall be constructed in one complete factory-built assembly. It shall be sized to rest on top of a 6-foot diameter wet well as detailed in construction drawings with suction and discharge pipe penetrations as detailed in the mechanical drawings. The supporting floor plate shall be 3/8-inch-thick, ASTM 40 carbon steel, as will beams and angle iron used above the plate for reinforcing, required to prevent deflection and insure a rigid support. Seal welding techniques shall be used throughout the baseplate structure to maximize joint strength,water intrusion sealing, and minimize paint holiday potential, as well as increase structural support transfer.

An integral hatch assembly that botts on after baseplate and piping installation on and within the well well, shall also be provided. The assembly shall be of the same carbon steel as the baseplate and incorporate a stiding aluminum hatch of 1/4 checkerplate designed to support 300° in a closed or partially open state. The hatch is positioned in front of the control panel to allow manual level control activity while monitoring the well at station platform level rather than ground level.

Each horizontal motor shall be side base mounted on stainless steel to allow the operator to remove the motor, back-head, and impeller from the volute. The 6-inch pump suction and 6-inch station discharge piping shall be mounted in relation to the floor plate as detailed in the construction drawings. The station shall have no holes in

The pump station shall be enclosed by a hinged, molded, insulated, fiberglass cover and is provided with a stainless-steel hasp connection to the vertical perimeter steel section that allows the pump chamber to be secured with a padiack. A lift assist system is included that reduces the dead lift force required to open the cover to 20 pounds or less.Two gas struts, automatic lock open assemblies, and over extension restraints are provided. A solid aluminum grab handle, secured to the cover, is provided for operator use to lift and open the cover for full walk-around access to the equipment. Closeable ventilating louvers with bug screens are provided on each end of the fiberglass cover. One vent incorporates a vent fan for seasonal heat exhaust.

The exterior surface of the cover shall be gelcoat with a smooth finish free from fiber patterns, roughness or other irregularities. The gelcoat shall be reinforced with a minimum 1/8 fiberglass laminate in non-structural areas and a minimum 1/4 in structural areas. The laminate, consisting of polyester resin and chapped strand fiberglass, shall have a minimum glass content of 30%. The molding shall be continuous, forming a one piece molded composite shelter. Each layer of laminate shall be hand rolled to eliminate air pockets and "stickers" in the completed product. ", closed cell, poly foam insulation in board form shall be encapsulated between layers of the laminate to ensure retention of the insulation quality integrity and maintain an R 9 rating.

The gel-coat material shall be an NPG isophihalic catalyzed cure product with UV stabilizers for maximum protection in continuous weather exposure applications. Color selection is a neutral tan. The resin shall be a general purpose orthophthalic catalyzed resin without additional fillers, for maximum strength. The fiberglass reinforcement shall consist of 1-1/4 long random polyester strands consisting of a minimum 30% of the finished laminate. WELDING

All steel structural members shall be joined by electric arc welding with welds of adequate section and penetration for the joint involved. Welding shall be by MIG technique using stainless steel wire where stainless and carbon steels are to be joined. Carbon steel wire shall be used for carbon on carbon steel joining. PROTECTION AGAINST CORROSION

After welding all inside and outside surfaces of the structure shall be mechanically cleaned and blasted to remove rust, mill scale, weld slag, etc. All weld spatter and surface roughness are removed by grinding. Particles from cleaning are removed by air, brush, and vacuuming, immediately following the cleaning, one coat of 83% solids, AMER lock 2 I high build epoxy,6 to 8 mils in dry thickness, shall be factory applied to all stainless and carbon steel surfaces.

SEWAGE PUMPS

The 4 pumps shall be horizontal, non-clog sewage pumps of heavy cast iron construction, especially designed for the use of mechanical seals. In order to minimize seal wear caused by the lineal movement of the shaft, the shaft bearing nearest the impeller is locked in place so that end play is limited to the clearance within the bearing. The bearing nearest the impelier shall be designed for the combined thrust and radial load. The bearing farthest from the impelier shall be free to move lineally with the thermal expansion of the shaft and shall carry only radial loads.

The pump impeller shall be made of close-grained cast iron and be of the enclosed type designed especially for the pumpage of 3" spherical solids as well as 3" long stringy solids. Prior to assembly it shall be dynamically and statically balanced. The back shroud shall incorporate pump out vanes for thrust balancing and prevention of solids build up. The volute backplate shall be designed with anti-rotation knobs that eliminate grit and other small particles from scouring the mechanical seal area thus extending

The impelier shall be keyed with a stainless-steel cap screw. The impelier shall not be screwed or pinned to the motor pump shaft and shall be readily removable without the use of special tools. Volutes are furnished with hand-hole cleanouts. STANDARD SEAL QUALITY

The pump shaft shall be sealed against leakage by use of a single mechanical seal constructed of matched tungsten carbide against silicon carbide faces lapped to a flatness of one light beam. A stainless-steel shaft sleeve shall be utilized for shaft protection in the event of eventual seal usage failure that might otherwise scar the shaft. The seal rotating face is held in position against the stationary face with a statioless-steel spring which pressures the mating seal faces at one BAR pressure. The seal shall be Type 2 as manufactured by John Crane Company and shall be lubricated internally by process water.

The premium efficient pump motors as manufactured by KSB or equal quality U.S. manufacturer, are of standard NEMA design, horizontal foot mounting, JP frame, squirrel cage induction type, suitable for 3 phase, 60 cycle, 208/230-volt three wire electric current. The motors shall be furnished with Class F insulation and NEMA B design. The enclosures shall be open drip proof with forced air circulation by an integral fan. Openings for ventilation are of uniform spacing around the motor frame. Leads

he motors shall have a 1,14 Service Factor. The Service Factor is reserved for the Owners protection. The motors will not be overloaded beyond their nameplate rating, at the design condition, nor at any head in the operating range as specified under operating conditions. The motor pump shaft is centered, in relation to the motor base, within .005 inches. The shaft runout will not exceed .003 inches.

A bearing cap shall be provided to hold the motor bearing nearest to the impeller in a fixed position. Bearing housings are provided with fittings for lubrication as well as purging old lubricant. The motors shall be furnished with silde bases of stainless steel for easy removal and replacement.

The control equipment shall be mounted on an equipment mounting plate per NEMA standards and installed in a NEMA 3R steel enclosure complete with nonremovable hinged outer door.Circuit breakers and H-O-A switches shall be operable from the front of the control panel door. The control panel is mounted so the operator may stand on the portion of the base plate which has the wet well entrance hatch. This will provide a safe working platform and easy access to the controls. A grounding type convenience outlet with 20-amp breaker shall be provided on the side of the cabinet for operation of II5-volt AC equipment other than that provided with the station. All station equipment is terminal strip wired.

Magnetic air circuit breakers shall be provided for branch disconnect service and short circuit protection of auxiliary circuits. Industrial grade switch gear shall be provided. Magnetic coil starters shall be provided for pump engagement when signaled by the level control system and bi-metallic overloads shall be mounted between the starters and motors for over current protection,

Each single-phase auxiliary motor shall be equipped with an over-current protection device in addition to the branch circuit breaker or shall be impedance protected. All switches shall be labeled, and a coded wiring diagram shall be provided. All control wiring shall be numbered at termination points with permanently marked sleeves and whose numbers shall be entered on the wiring ladder diagram. Minimum 120-volt control wire is 14 AWG. To control the operation of the pumps with variations of sewage level in the wet well, a submersible pressure transducer and a backup float switch level control system shall be

provided. Four float switches shall be furnished. Three will be for level control and one will be for the high level glarm circuit. A minimum of 30 feet of cord shall be provided

with the head to eliminate problems caused by splicing. The cord shall have a corrosion resistance vinyl jacket and be multi-stranded in order to prevent fatigue.

CONTROLS (CONTD.)

The pressure transducer and float switches shall be incorporated into the "Station Centre" controller which shall be provide the operator a 7" color touch screen for viewing and controlling all operating conditions at the station. The controller shall have 30 or more screens to view wet well level conditions, pump operating status, pump run time, pump prime status, vacuum pump run time, pump run sequence, station temperature, flow metering, and any active alarm conditions. The interactive screens stall allow changes in pump operation, pump selection (alternation), alarm settings and clearance, temperature alarm set points, and password protection of the unit from unauthorized personnel changes. The controller shall incorporate a memory SD card to retain a minimum 2 year operating history of the station for future download by the City for archive or regulatory needs. The equipment shall accommodate connection to a communications device available to provide wireless remote connection and alarm reporting. The service shall allow the operator through a smart phone, tablet or internet connected computer to remately view and change any operating settings at the station as well as alarm clearance.

Should there be a failure of the controller, provisions are made in the control circuit for backup operations to continue by automatic, independent use of the float switches. A battery pack is also provided to tie into the appropriate controller power supply terminals to supply a backup system in the event utility power is lost. The feature is designed to maintain programming and alarms within the controller and not engage the three phase pump motors when in use.

VACUUM PRIMING SYSTEM

A separate and independent priming system is furnished for each sewage pump, providing complete stand-by operation, Stainless steel probes are used with LED attenuation when prime is achieved. Priming takes place on the suction side of each sewage pump to maintain vacuum continuity on the priming system components rather than switch from vacuum to pressure during a pumping cycle.This also reduces exposure to grease. System logic is designed to not allow a sewage pump to run unless primed when in auto mode.

Each priming system is complete with vacuum pump, vacuum control solenoid valve, and prime level sensing system. Vacuum pumps shall have corrosion resistant internal components and solenoid valves shall incorporate stainless steel components. A float operated check valve is installed in each system ahead of the vacuum pump to prevent the vacuum pump shuts off. Minimum tubing size used throughout is 3/8".

To prevent excessive stoppage due to grease accumulation,the priming chamber incorporated into the suction elbow is coated and no passageway in the priming system through which sewage must pass is smaller than a 2 3/4 opening.

ENVIRONMENTAL EQUIPMENT

A ventilating blower is provided, capable of delivering 250 CFM at O.F static water pressure, in order to remove the heat generated by continuous motor operation. The ventilating blower shall be turned on and off automatically by a panel mounted thermostat and secured to the fiberglass cover. A 500-watt electric heater also controlled by a panel mounted thermostal shall be furnished. The heater shall be rigidly mounted to the station control panel back to prevent removal.

SEWAGE PIPING

The pump suctions are drilled and tapped for a 125 lbs. American Standard flange for ready connection to the suction riser. The discharge line from each pump is fitted with a four-inch ball check valve and discharges through a lever operated, four-inch three-way plug valve . Size, location and quantity of check valves and plug valves are to be shown on the shop drawings. Ball check valves are specifically used to avoid the air and water leaks and low longevity of wafer style flapper valves that are a common maintenance and

Protrusions through the floor plate are gas-tight to effect sealing between the equipment chamber and the wet well. Bolled and sealed joints are provided at the suction pipes in order to prevent corrosive or noxious fumes from entering the station. The 4 suction flange face and 4 plain end discharge connections are extended through the floor plate at the factory, so that field connections can be made without disturbing the gas-tight seals. The 4 discharge pipe terminates through the base plate and is seal welded. A thrust restraint, mechanical, dresser type coupling is provided for installation to the common discharge pipe.

INSTALLATION & OPERATION INSTRUCTIONS

installation of the pump chamber must be done in accordance with the written instruction provided. Operation and Maintenance manuals are furnished, which will include parts lists of components, complete service procedures and troubleshooting guide.

FACTORY TESTS All components of the pump stations will be given an operational test at the factory for proper trouble-free function at design conditions, as well as points above and below. prior to shipment.

GUARANTEE The MANUFACTURER shall guarantee the structure and all equipment to be free from defects in material and workmanship for a period of up to one (I) year from date of start-up, not to exceed 18 months from the date of shipment, The MANUFACTURER will be solely responsible for the guarantee of the station and all components.

PUMP AN	D MOTOR DATA	
	PUMP *I	PUMP *I
DESIGN GPM & TDH	94 GPM @ 22'	94 GPM @ 22'
PUMP MODEL	KSB KRT F 100- 215/44XEG-S 1E3 OR APPROVED EOUAL	KSB KRT F 100- 215/44XEG-S 1E3 OR APPROVED EOUAL
IMPELLER DATA	6-11/16"	6-"/16"
ROTATION CW-CCW (MOTOR END)	CCW	CW
SUCTION LIFT (STATIC) AT OFF-LEVEL	20' MAX	20' MAX
MOTOR HORSEPOWER	5 HP	5 HP

LIFT STATION ELEVATIONS					
&					
CONTROL SYST	TEM				
LIQUID LEVEL SE	TTINGS				
TOP OF STATION	1012.89				
FLOW LINE IN	1000.82				
FLOW LINE OUT	1008.89				
BOTTOM OF STATION	993.82				
LEAD/LAG PUMP OFF	996.50				
LEAD PUMP ON	997.82				
LAG PUMP ON	999.32				
HIGH WATER ALARM	999.82				





924 FRANCIS ST. ST. JOSEPH, MO 64501 P: 816-233-8003 F: 816-233-7793 www.ellison-auxier.com


CONSULTANTS


NO. ISSUE DESCRIPTION


NO. REVISION DESCRIPTION


LIFT STATION/FORCEMAIN PLAN AND PROFILE

SHEET:

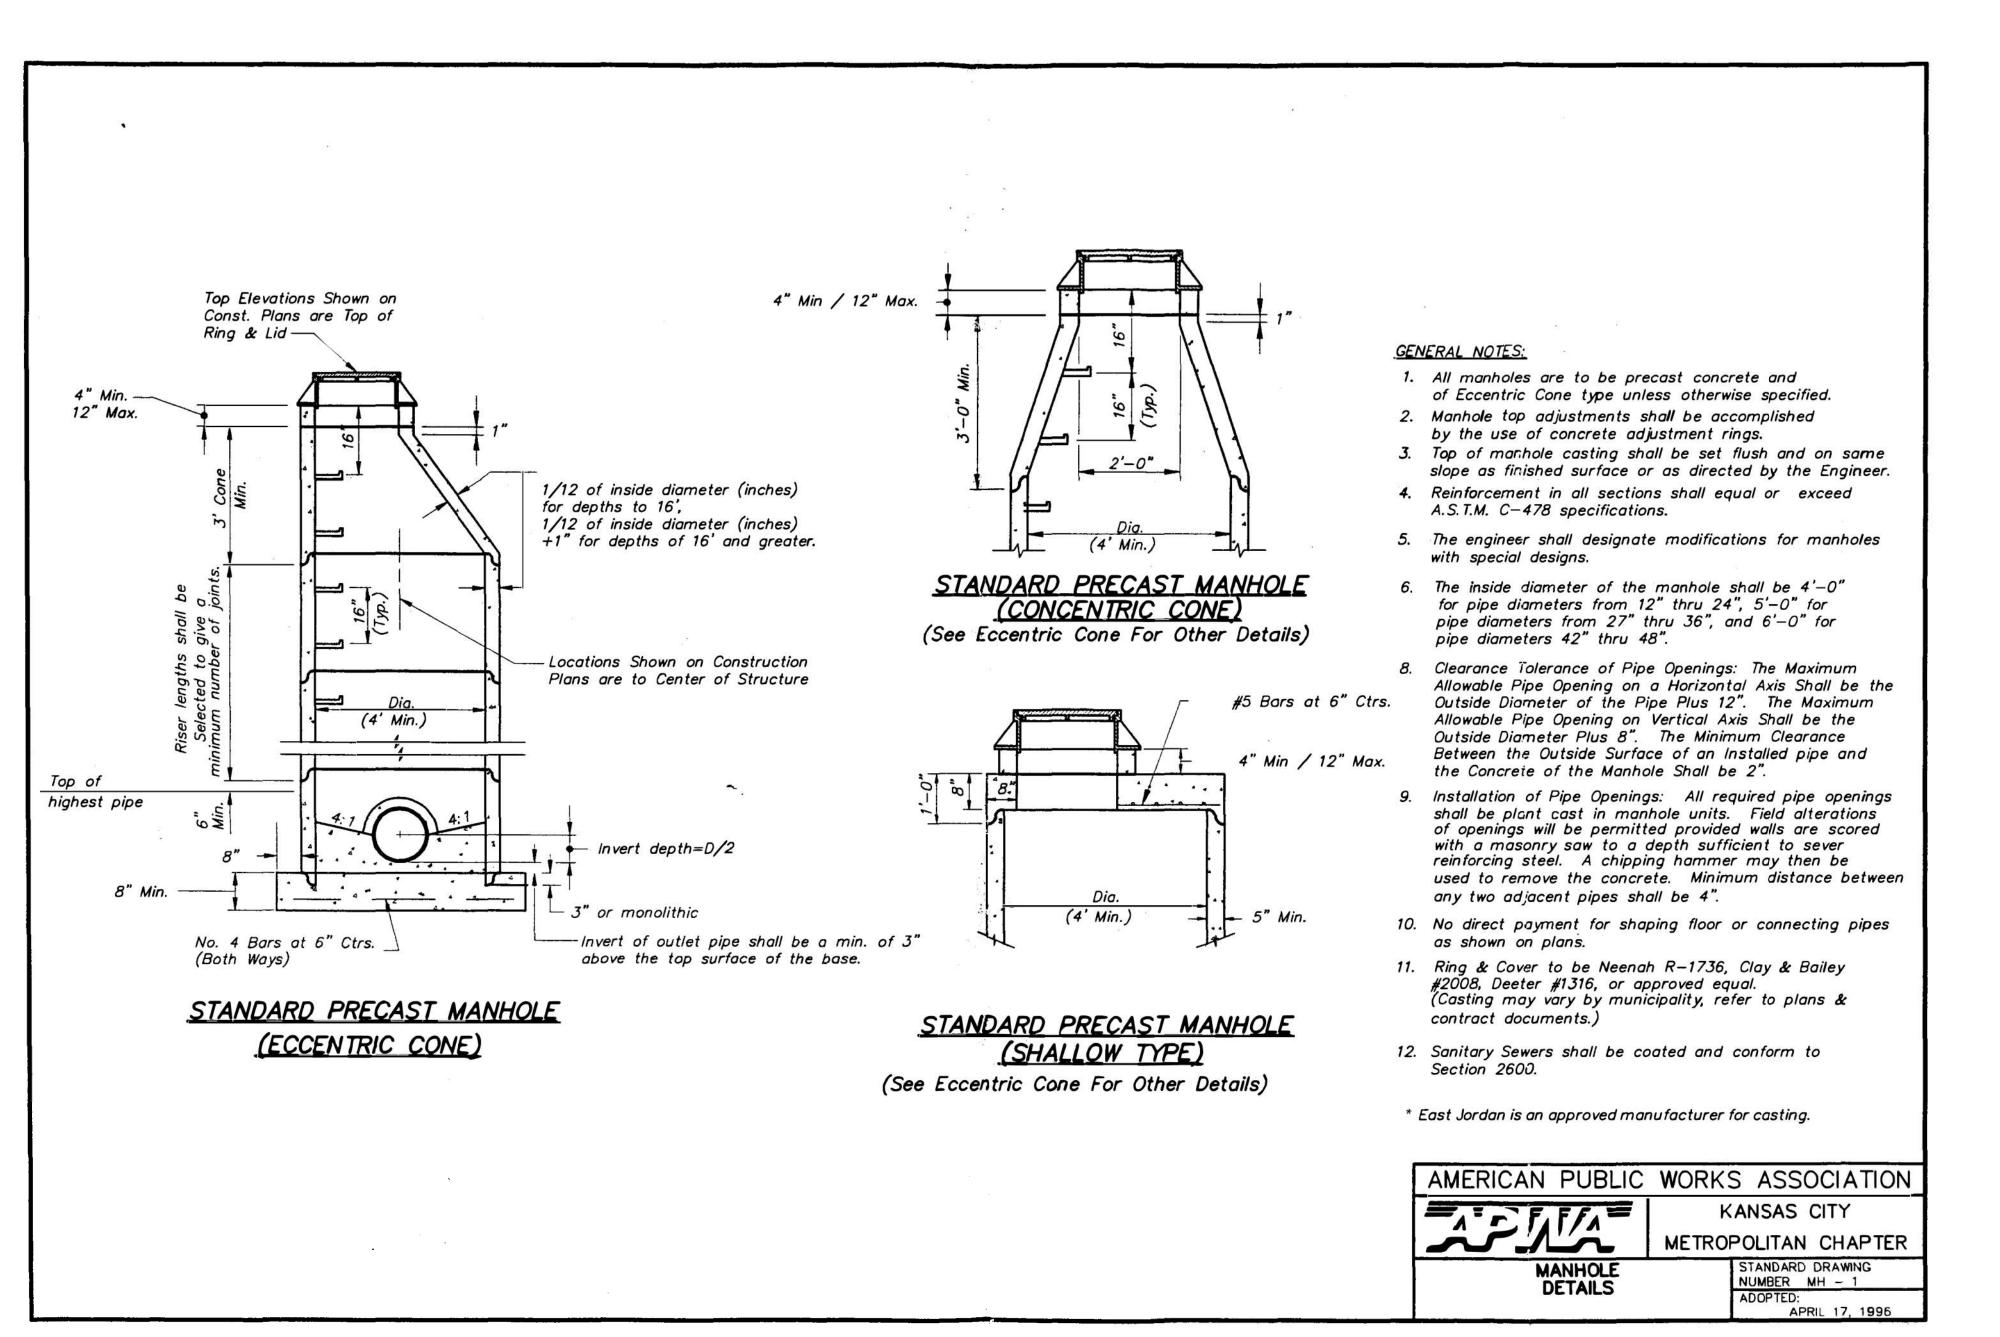

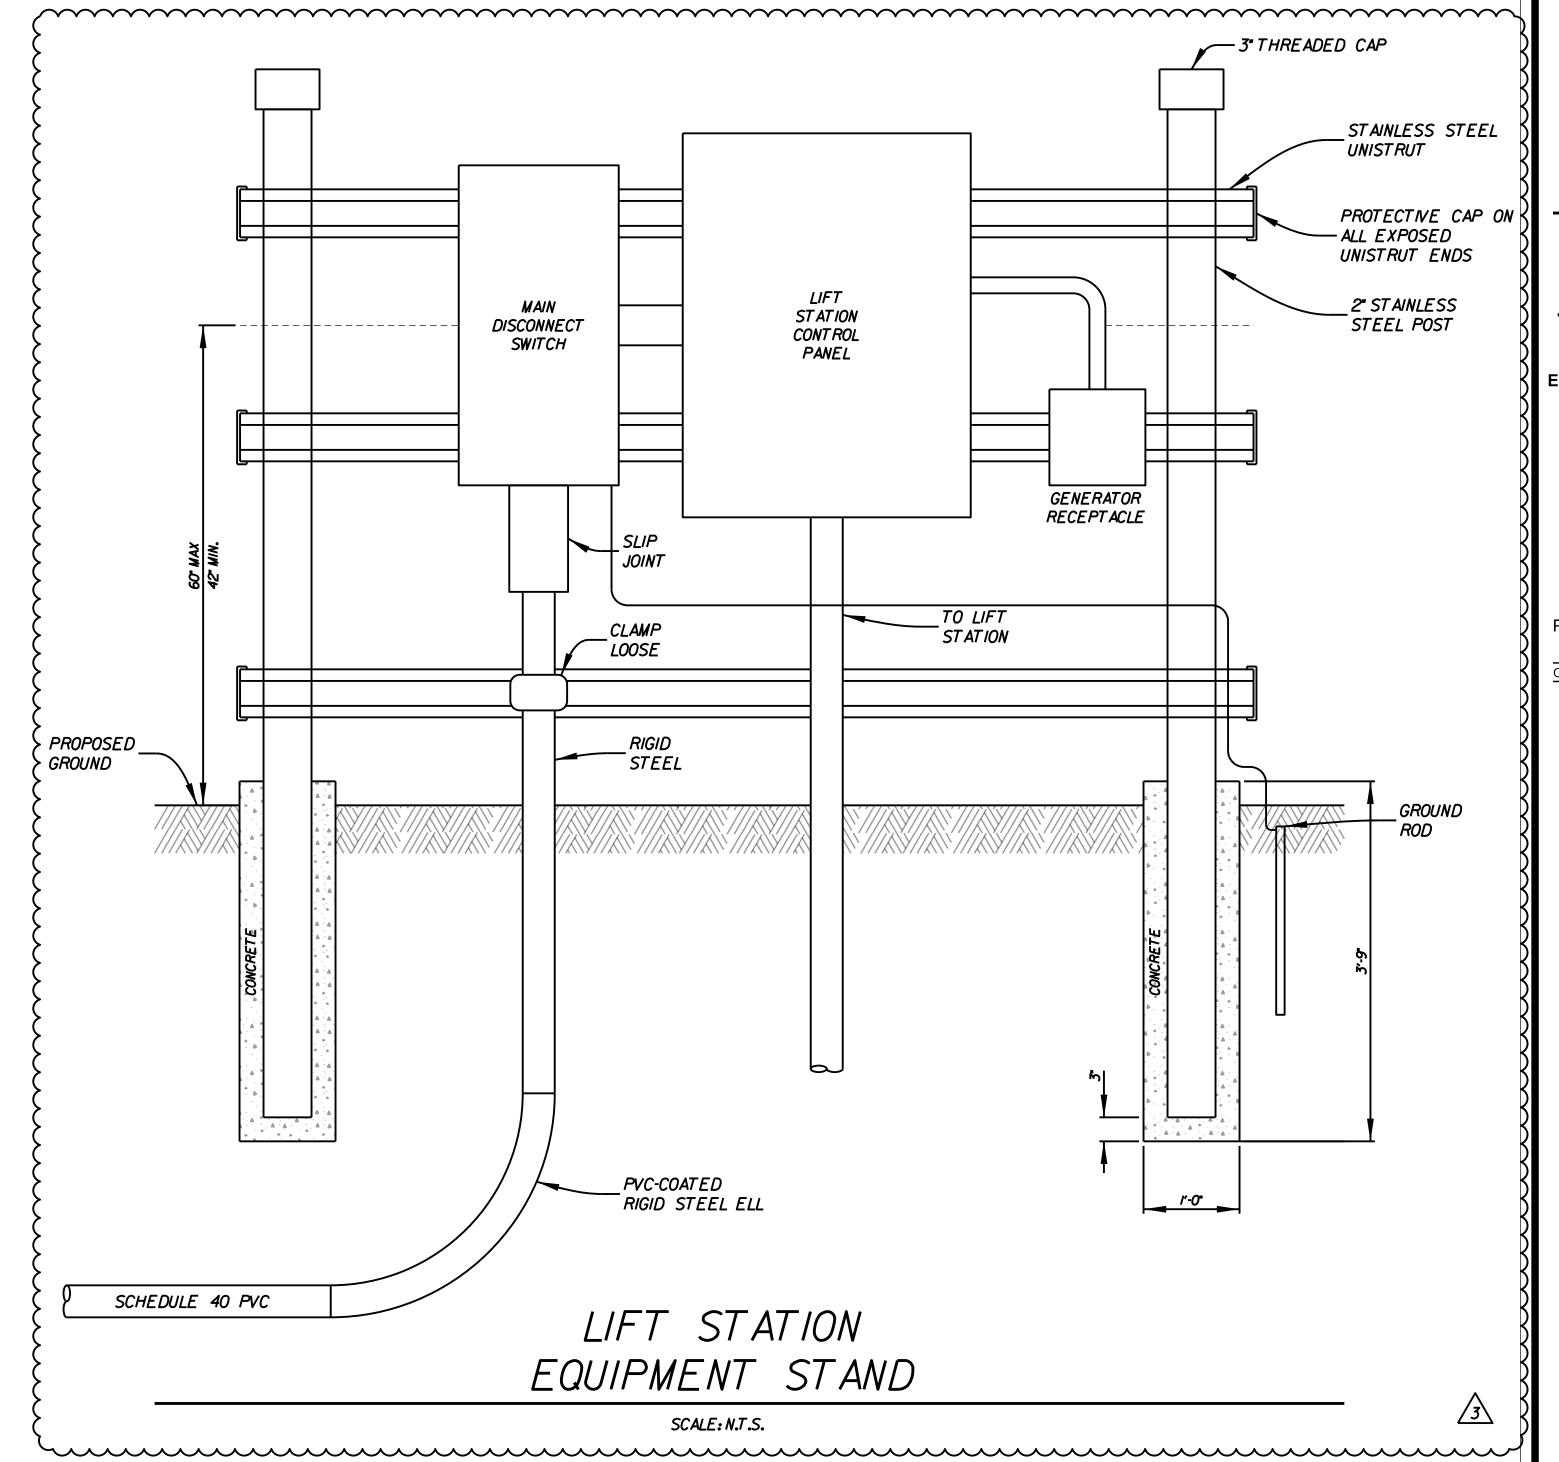

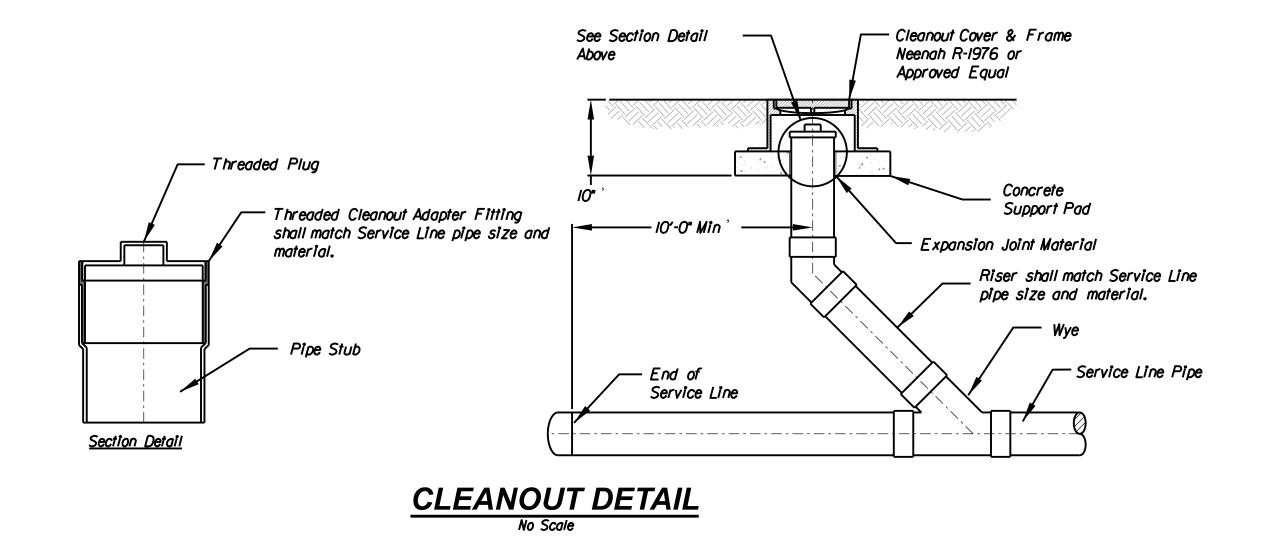

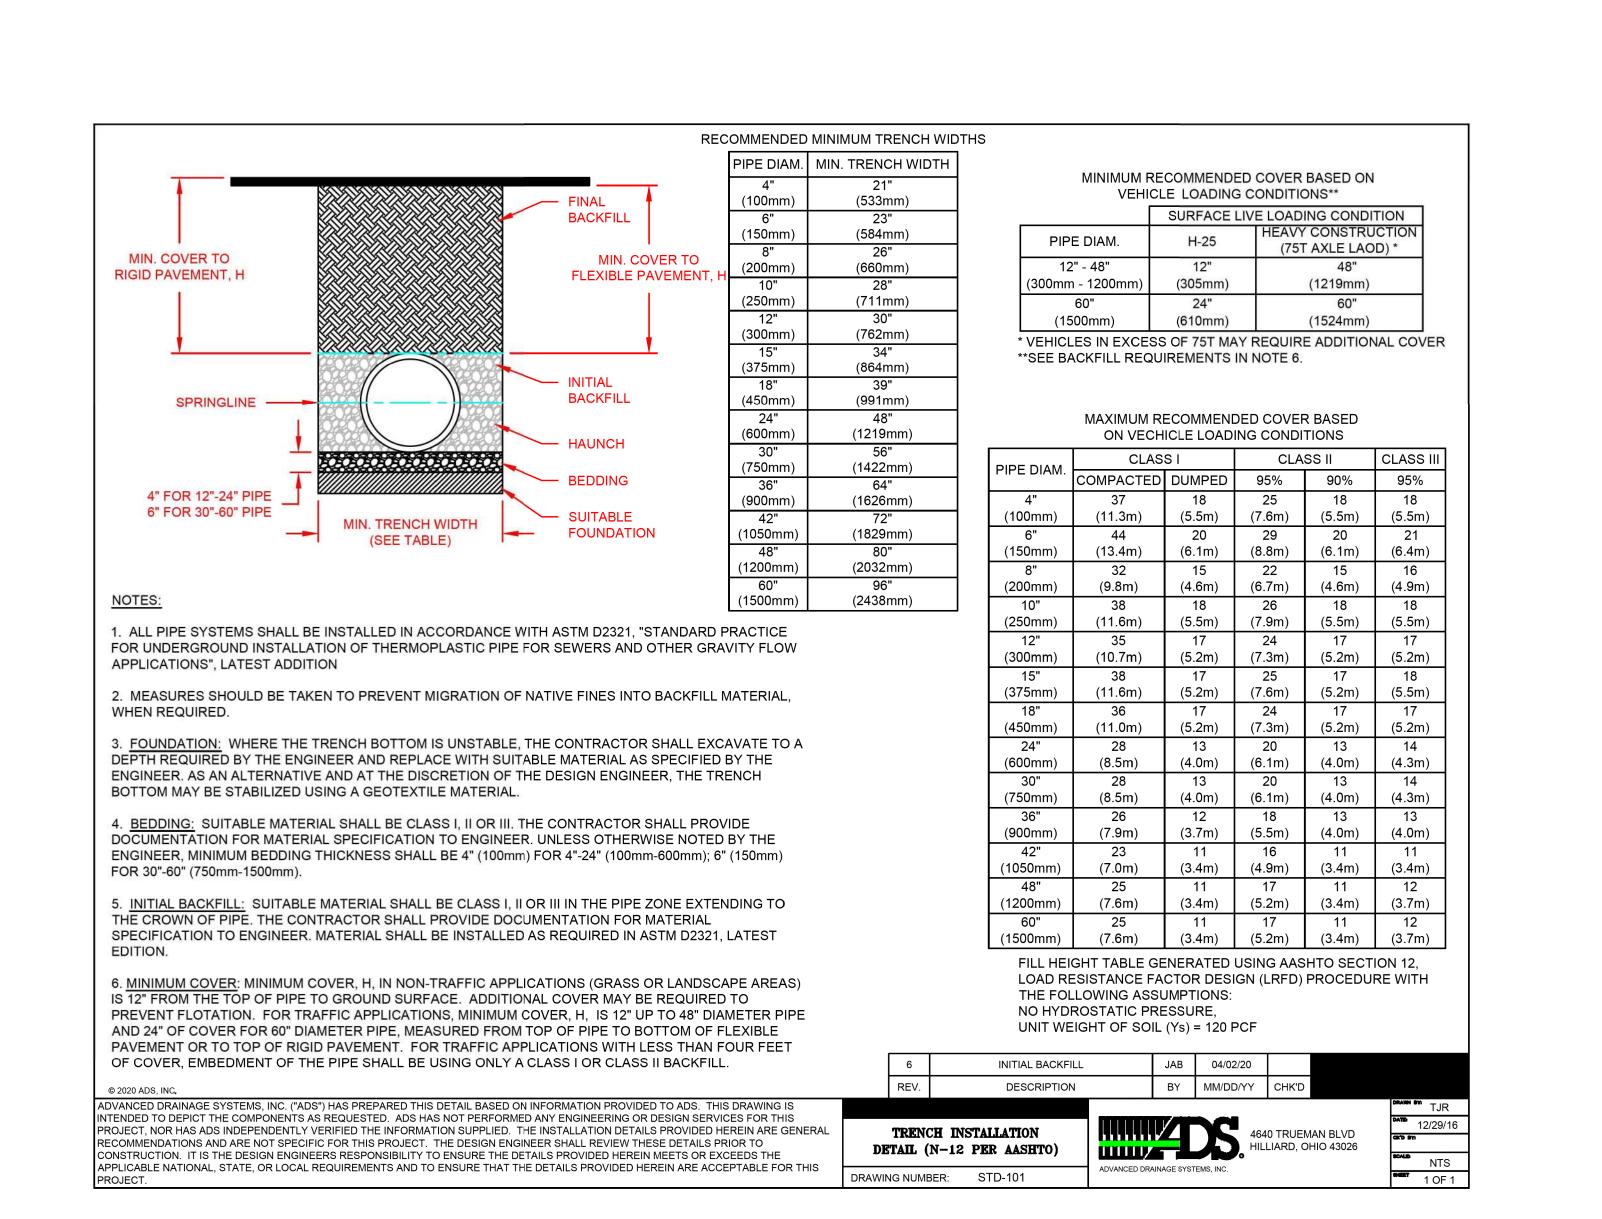





ELLISON - AUXIER ARCHITECTS

924 FRANCIS ST. ST. JOSEPH. MO 64501 P: 816-233-8003 F: 816-233-7793

www.ellison-auxier.com

INEER 9




Z

NO. ISSUE DESCRIPTION ADDENDUM 3

NO. REVISION DESCRIPTION DATE

DETAILS

SHEET:

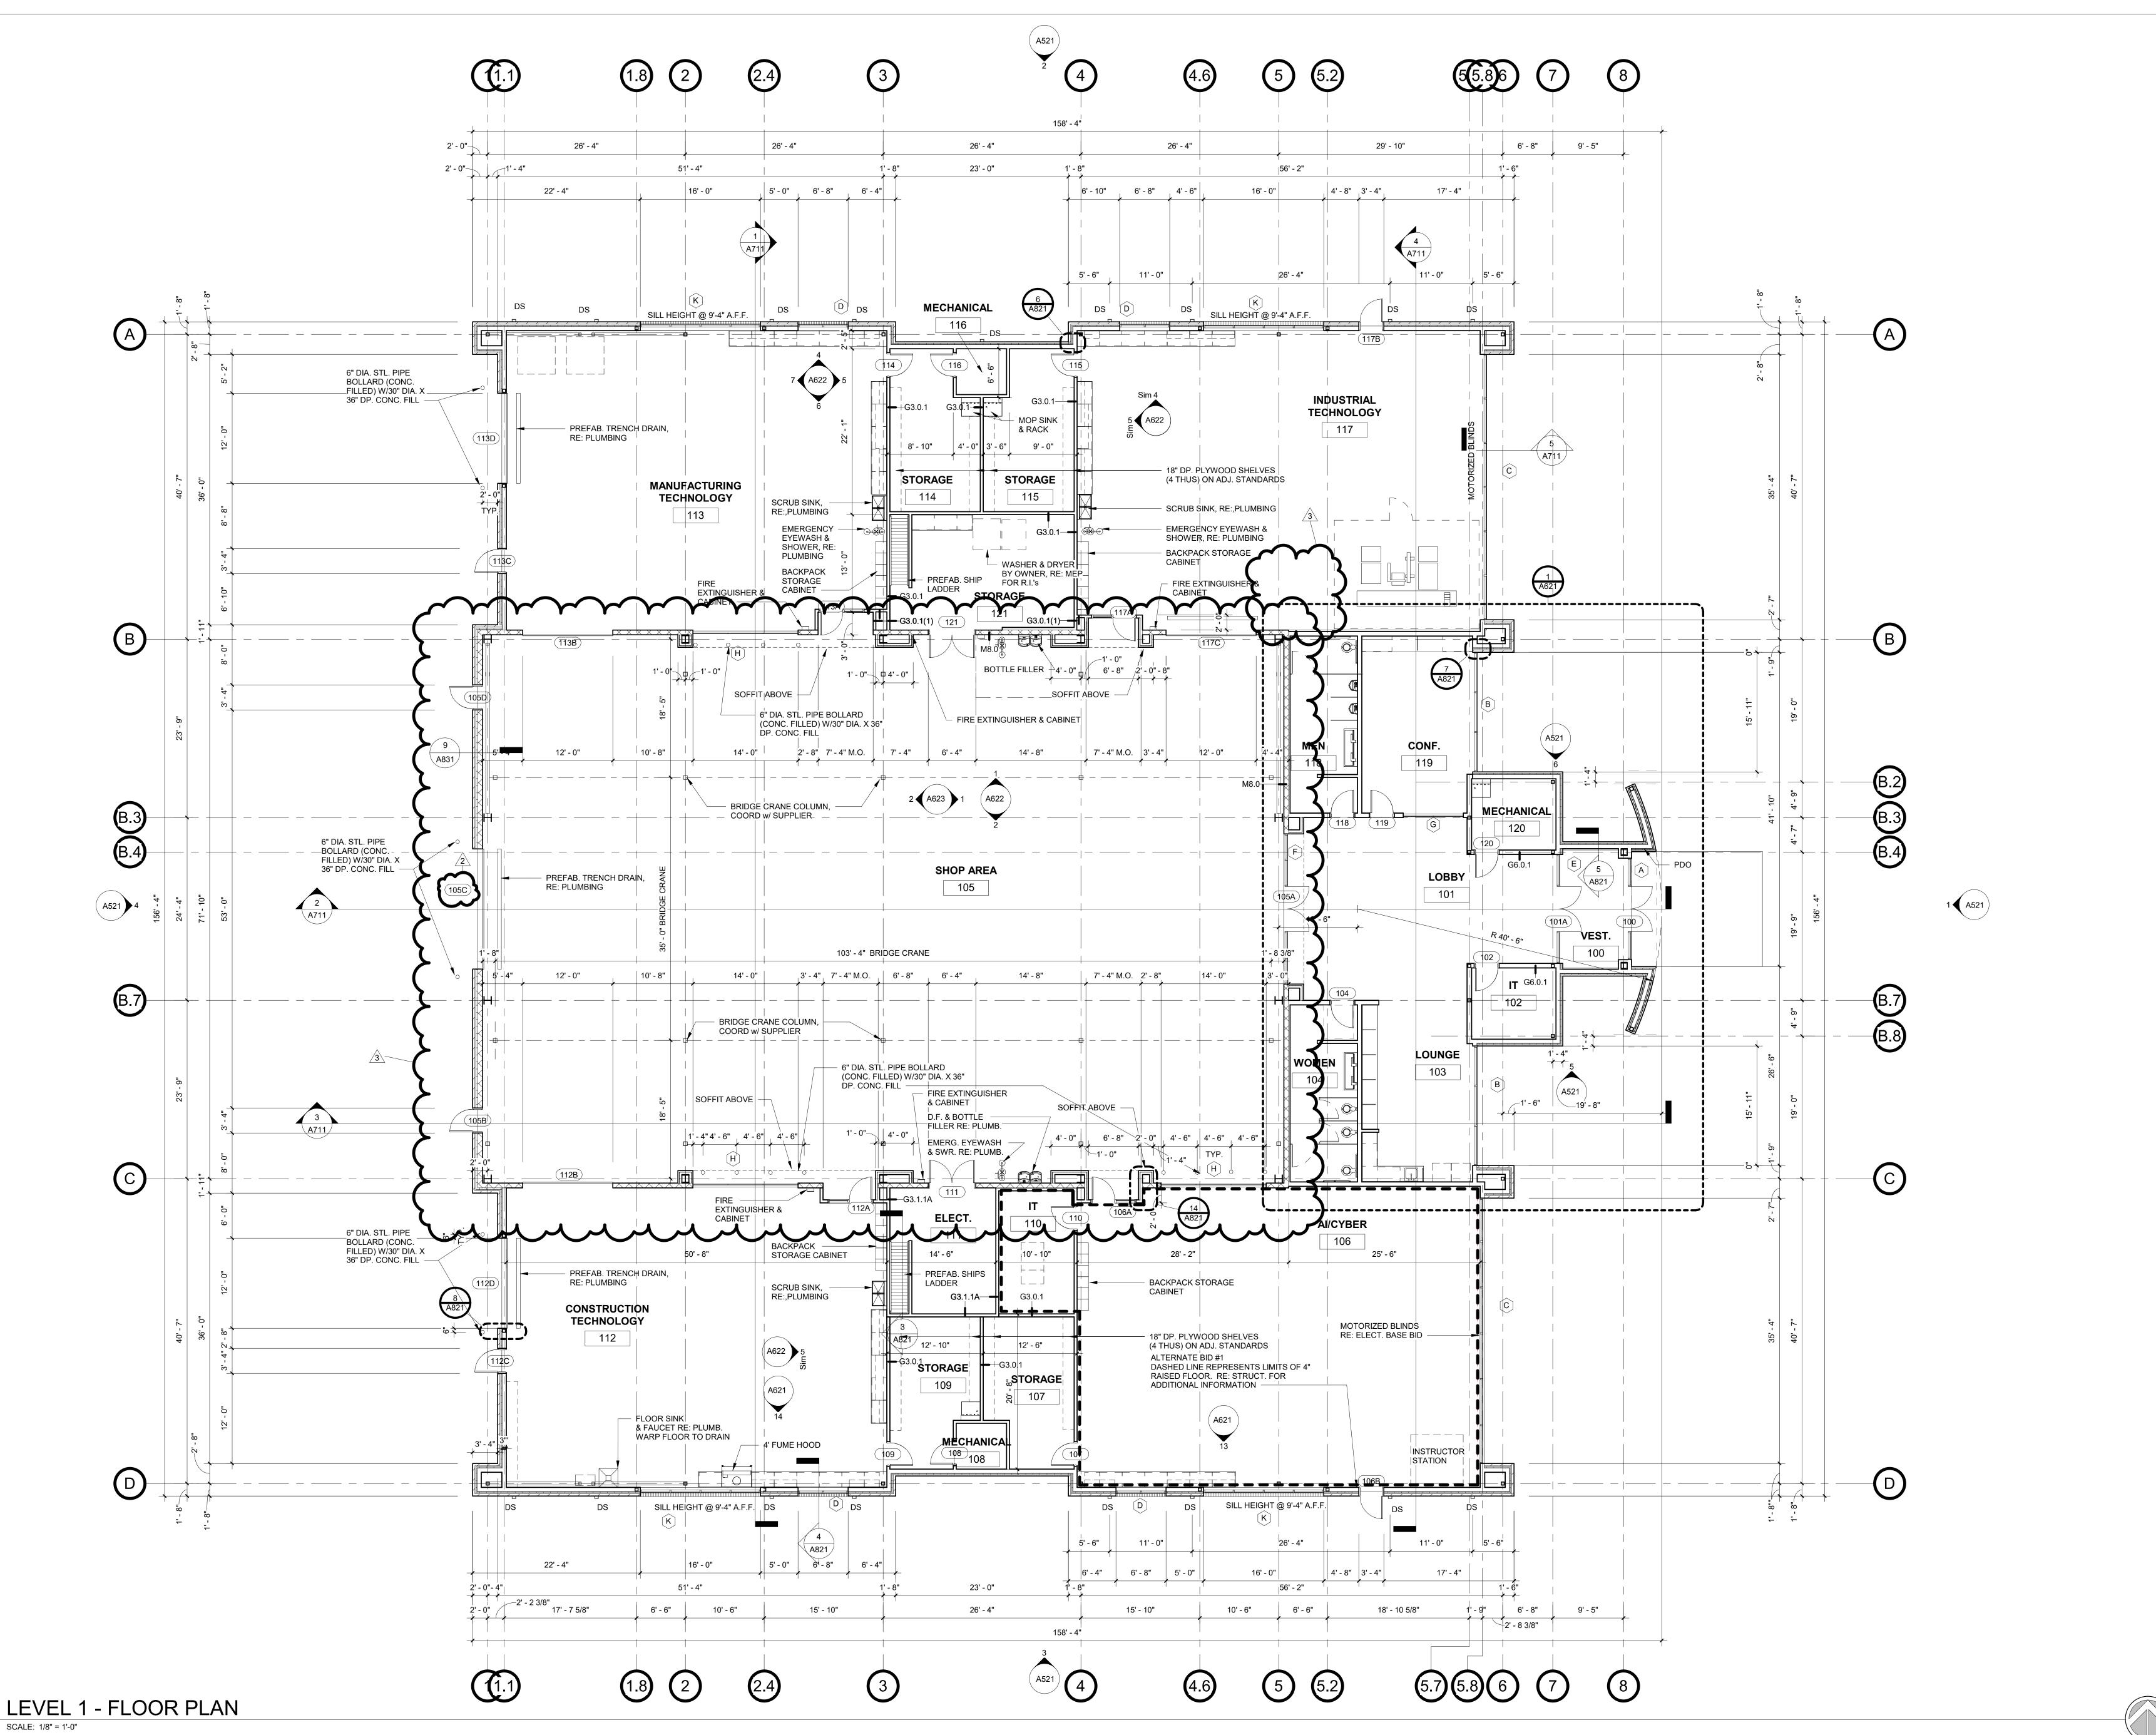





ARCHITECTS

924 FRANCIS ST. ST. JOSEPH, MO 64501 P: 816-233-8003 F: 816-233-7793 www.ellison-auxier.com

NO. ISSUE DESCRIPTION DA

NO. REVISION DESCRIPTION DATE

3 ADDENDUM #3 05.23.202

WESTERN STATE


Y
SUILDING
IVE
64507

MISSOURI WESTE UNIVERSITY
FB24-001 CTAC BUILDING
4525 DOWNS DRIVE
ST. JOSEPH, MO 64507

LEVEL 1 - FLOOR PLAN

SHEET:
A211

OF: DATE: 05-01-202

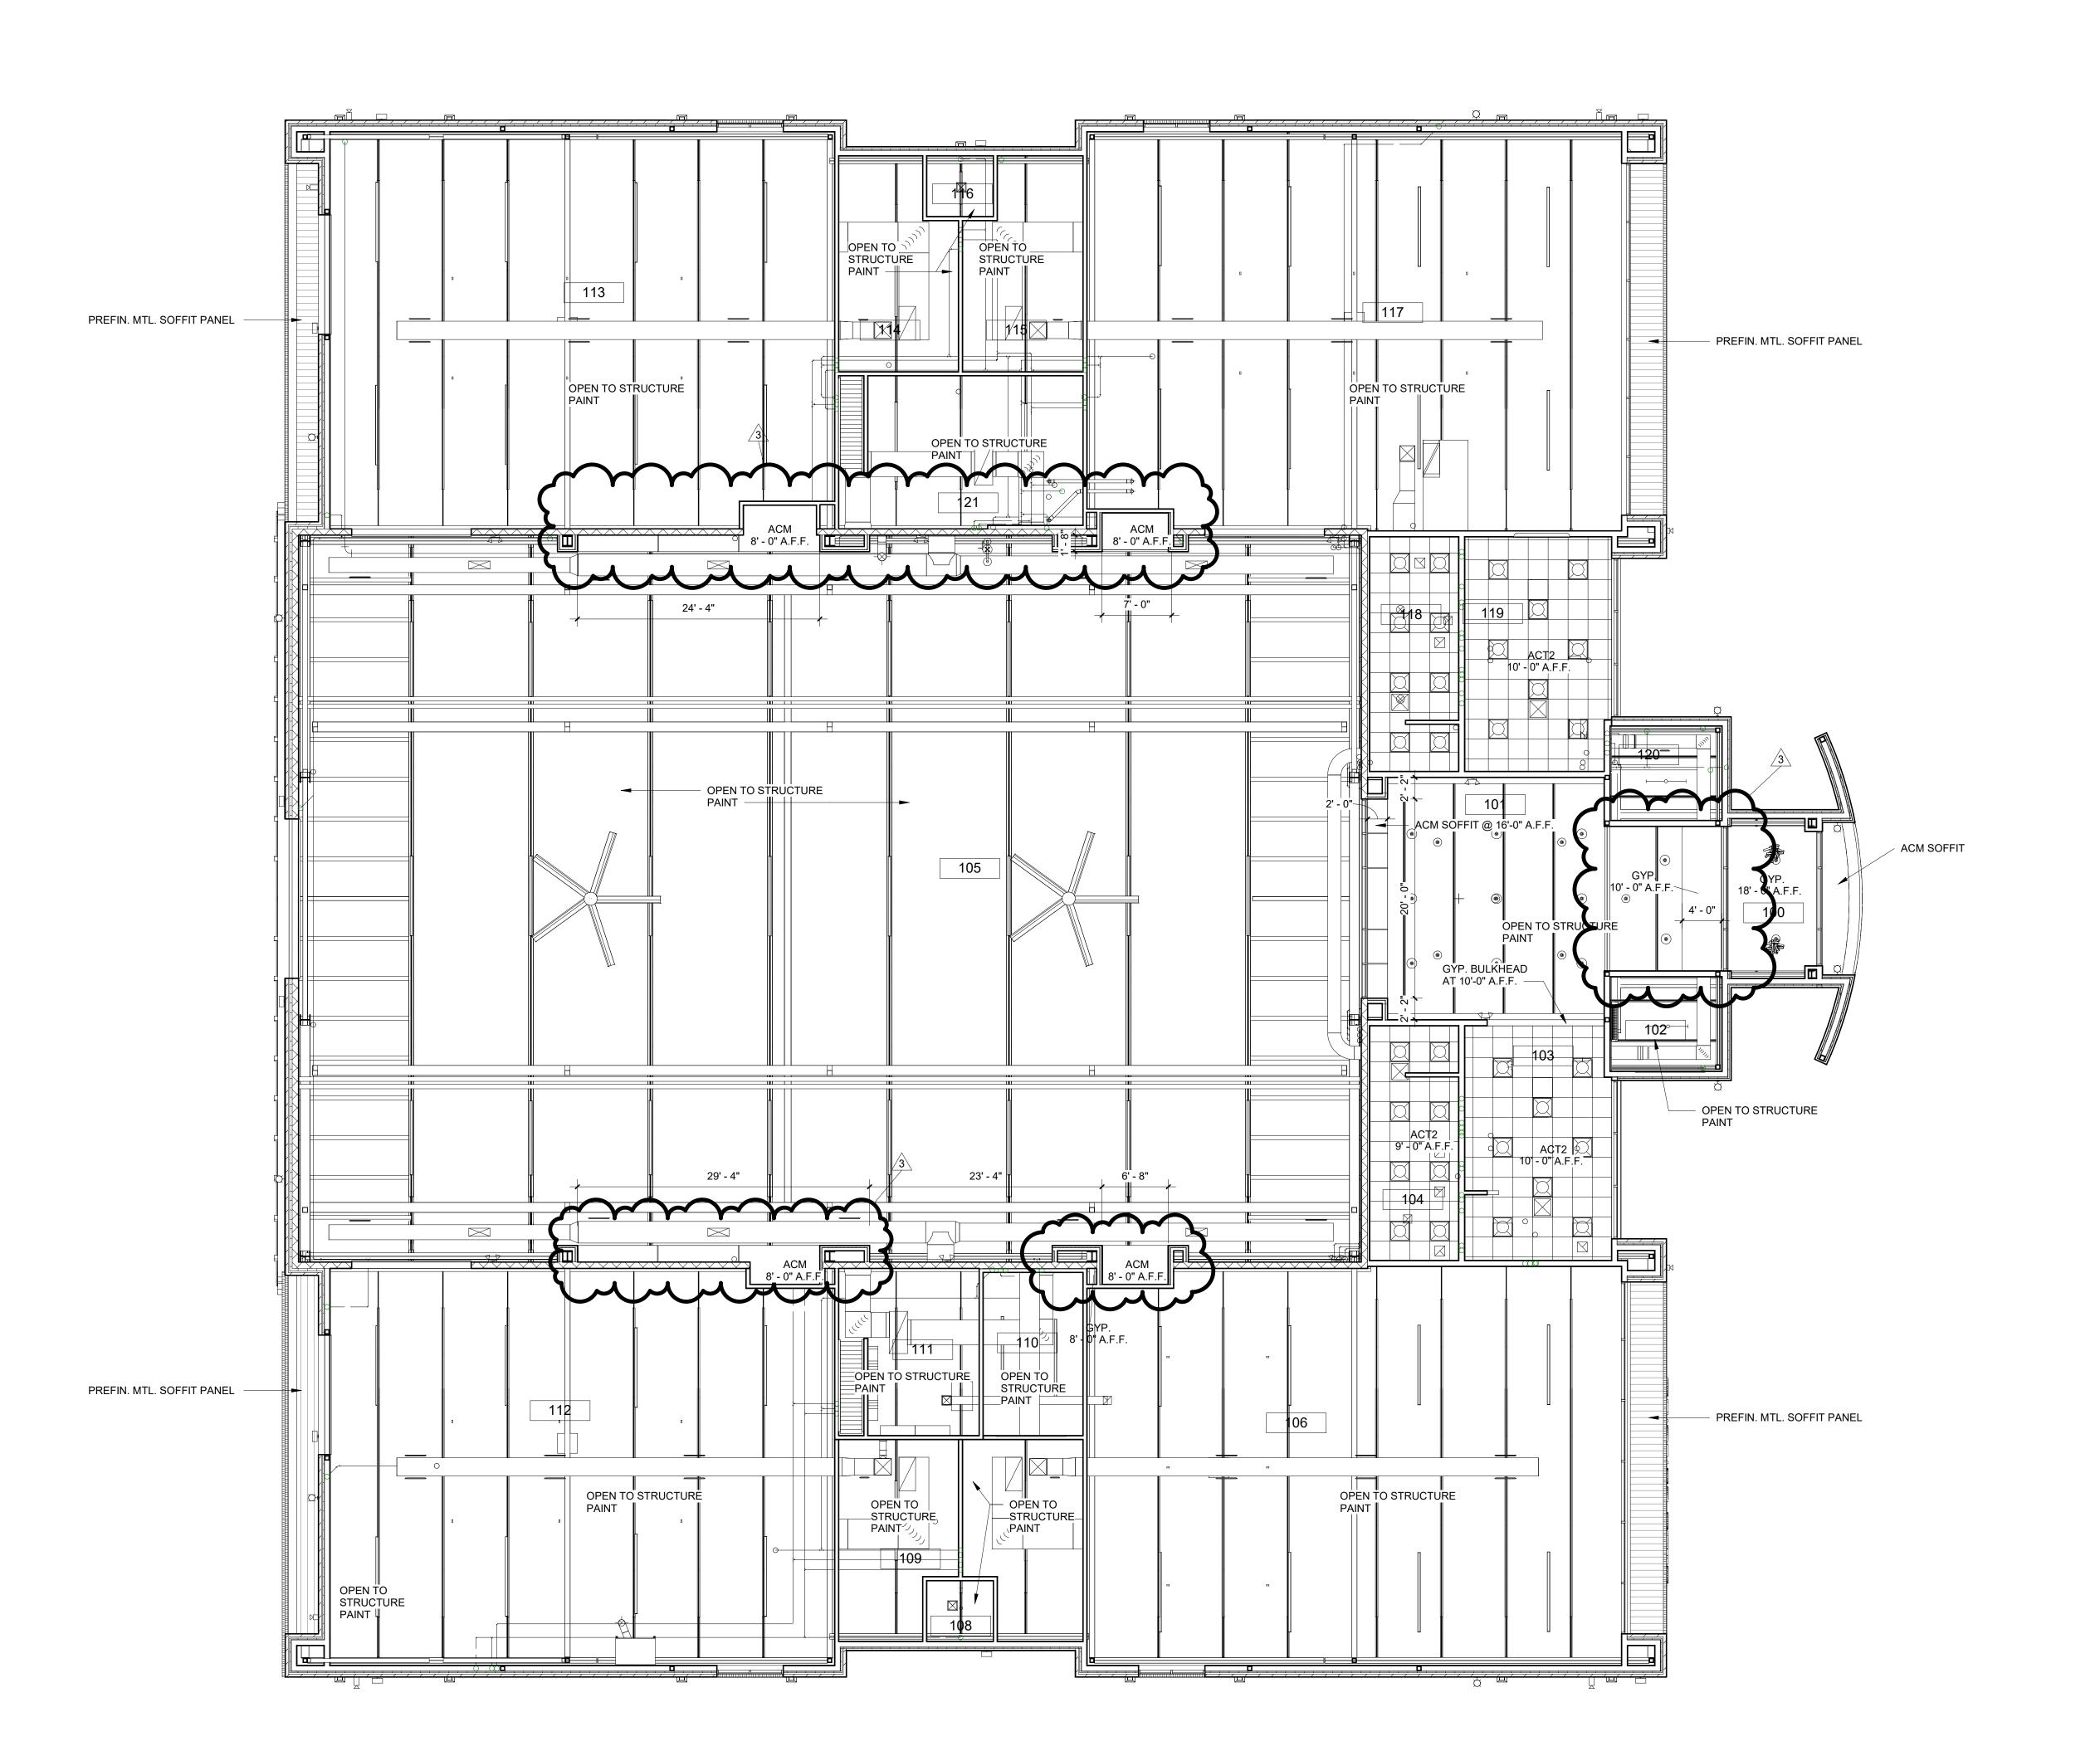





ELLISON - AUXIER
ARCHITECTS

924 FRANCIS ST. ST. JOSEPH, MO 64501 P: 816-233-8003 F: 816-233-7793 www.ellison-auxier.com

CONSULTANTS

NO. ISSUE DESCRIPTION

NO. REVISION DESCRIPTION DATE

3 ADDENDUM #3 05.23.2

ESTERN STATE


MISSOURI WESTERI UNIVERSITY FB24-001 CTAC BUILDING


LEVEL 1 - REFLECTED CEILING PLAN


SHEET:


A311


E: DATE: 05-01-202

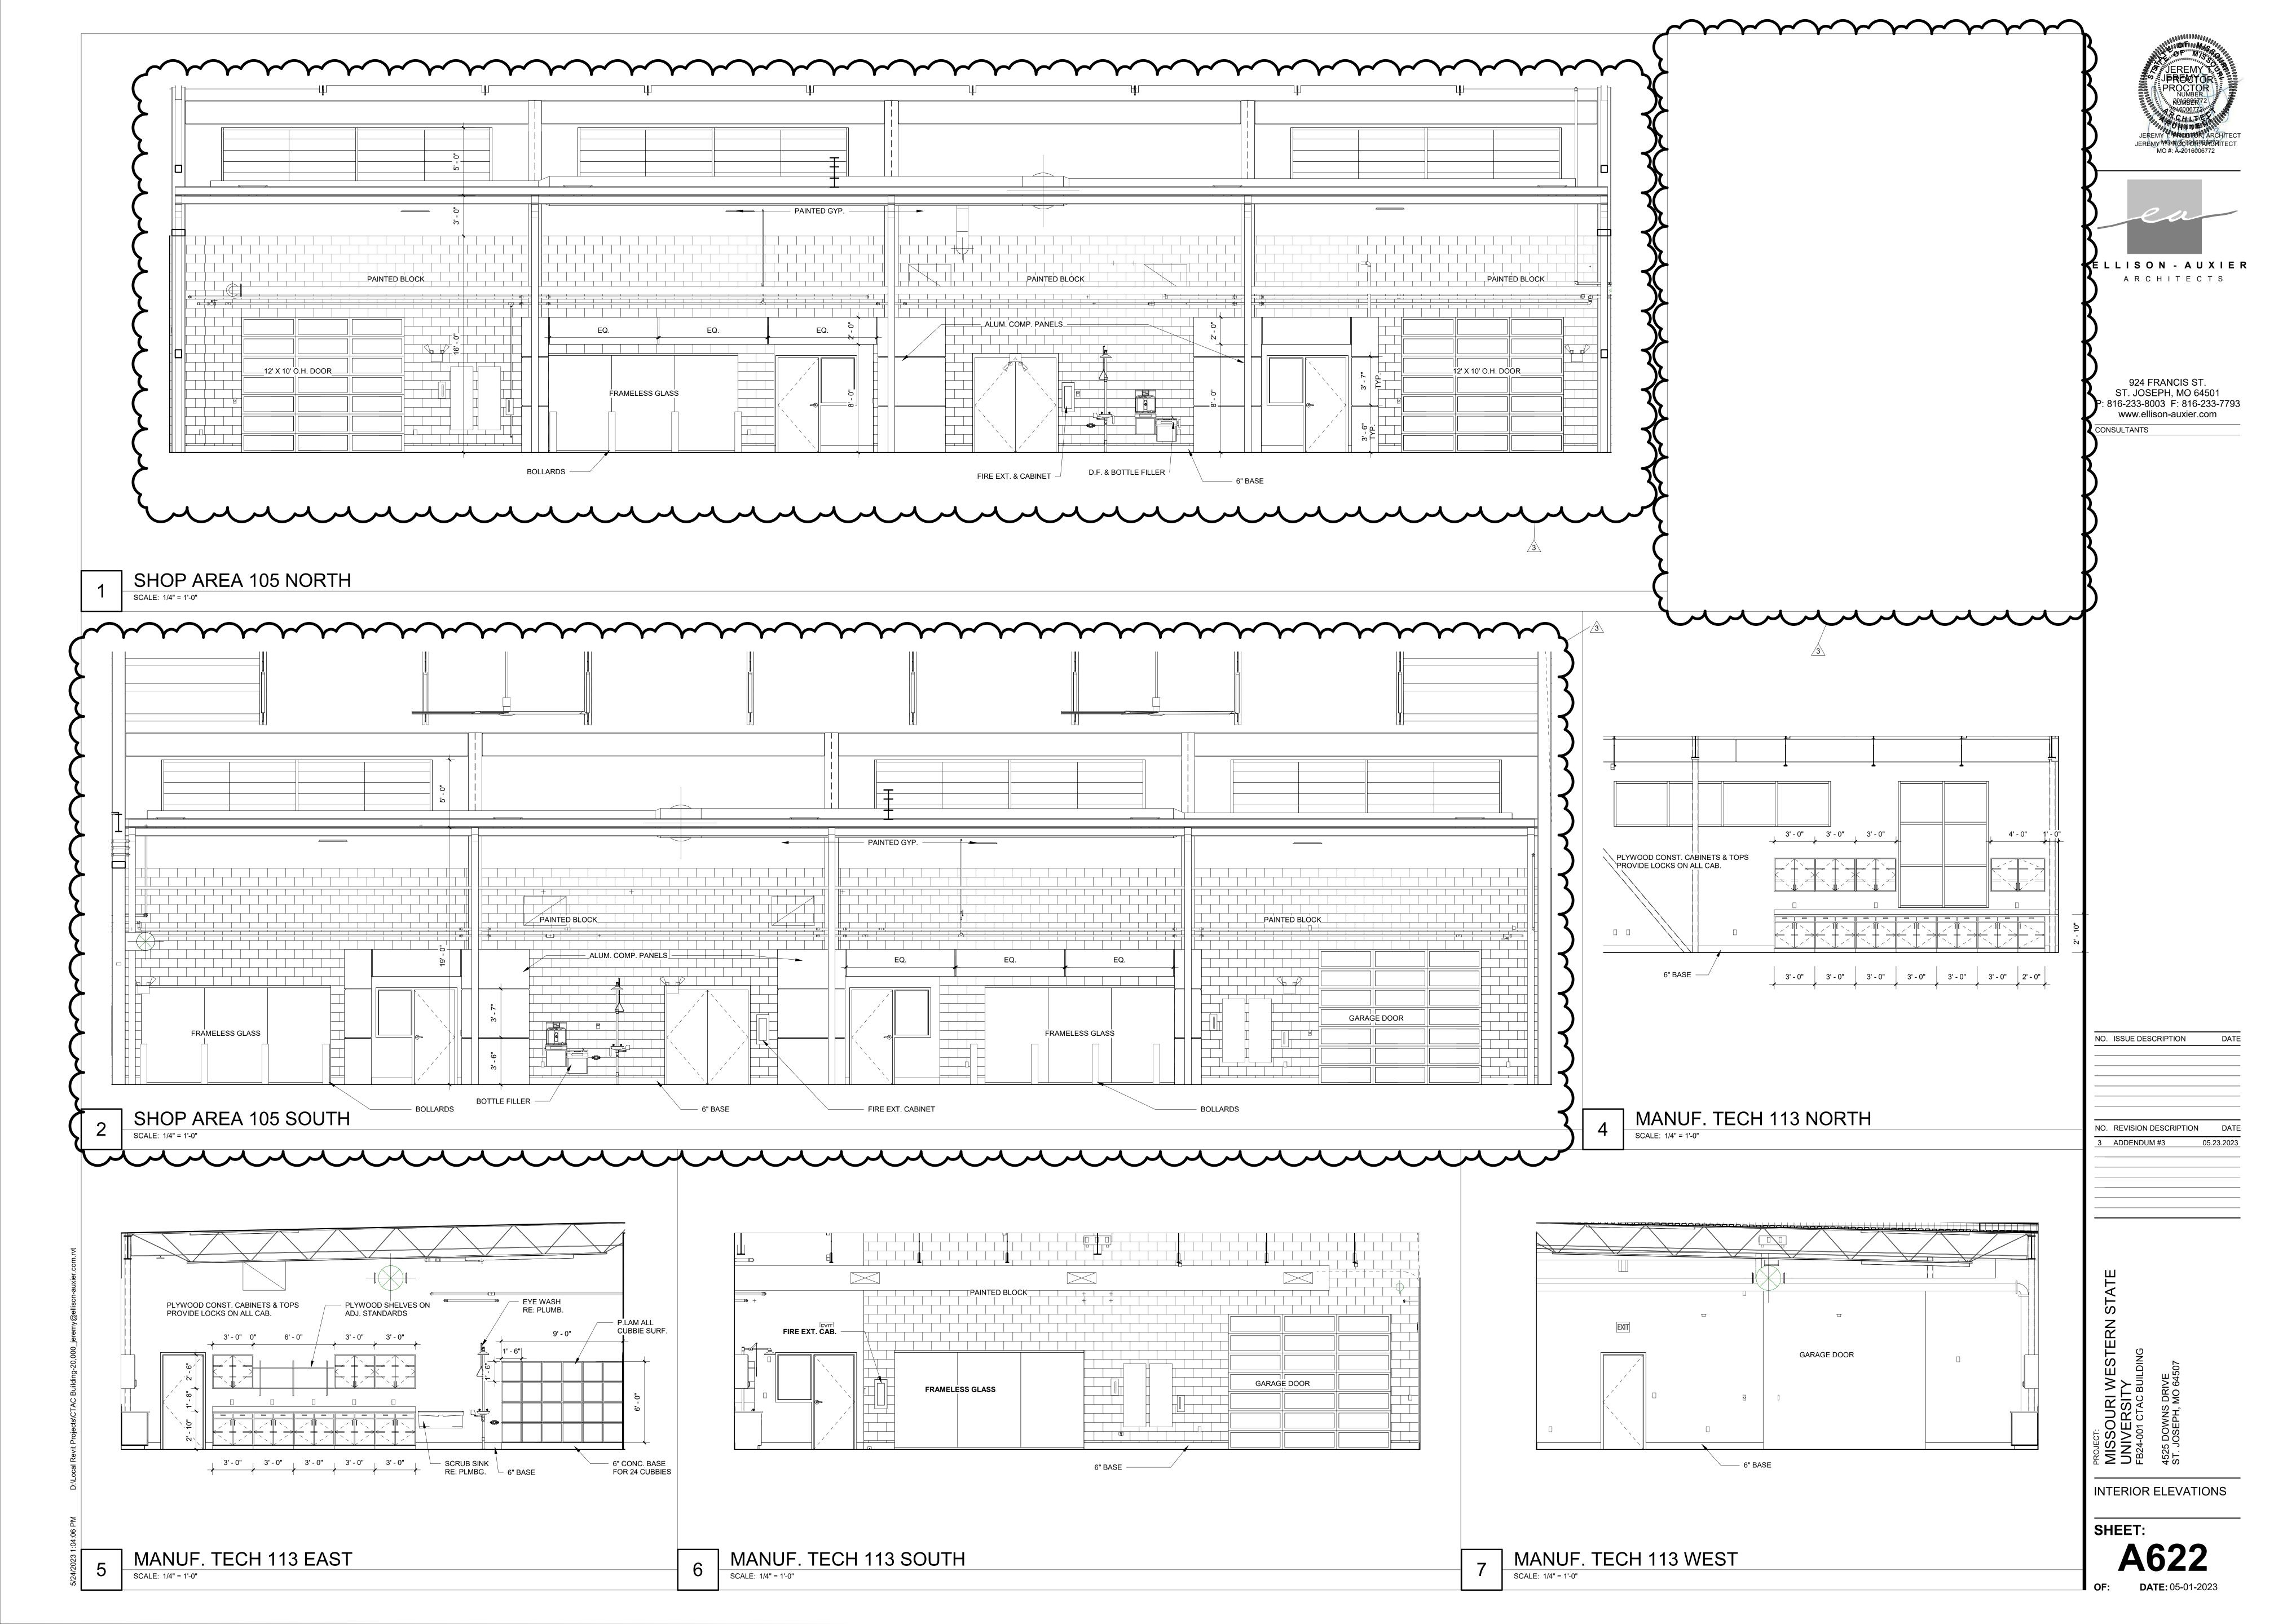


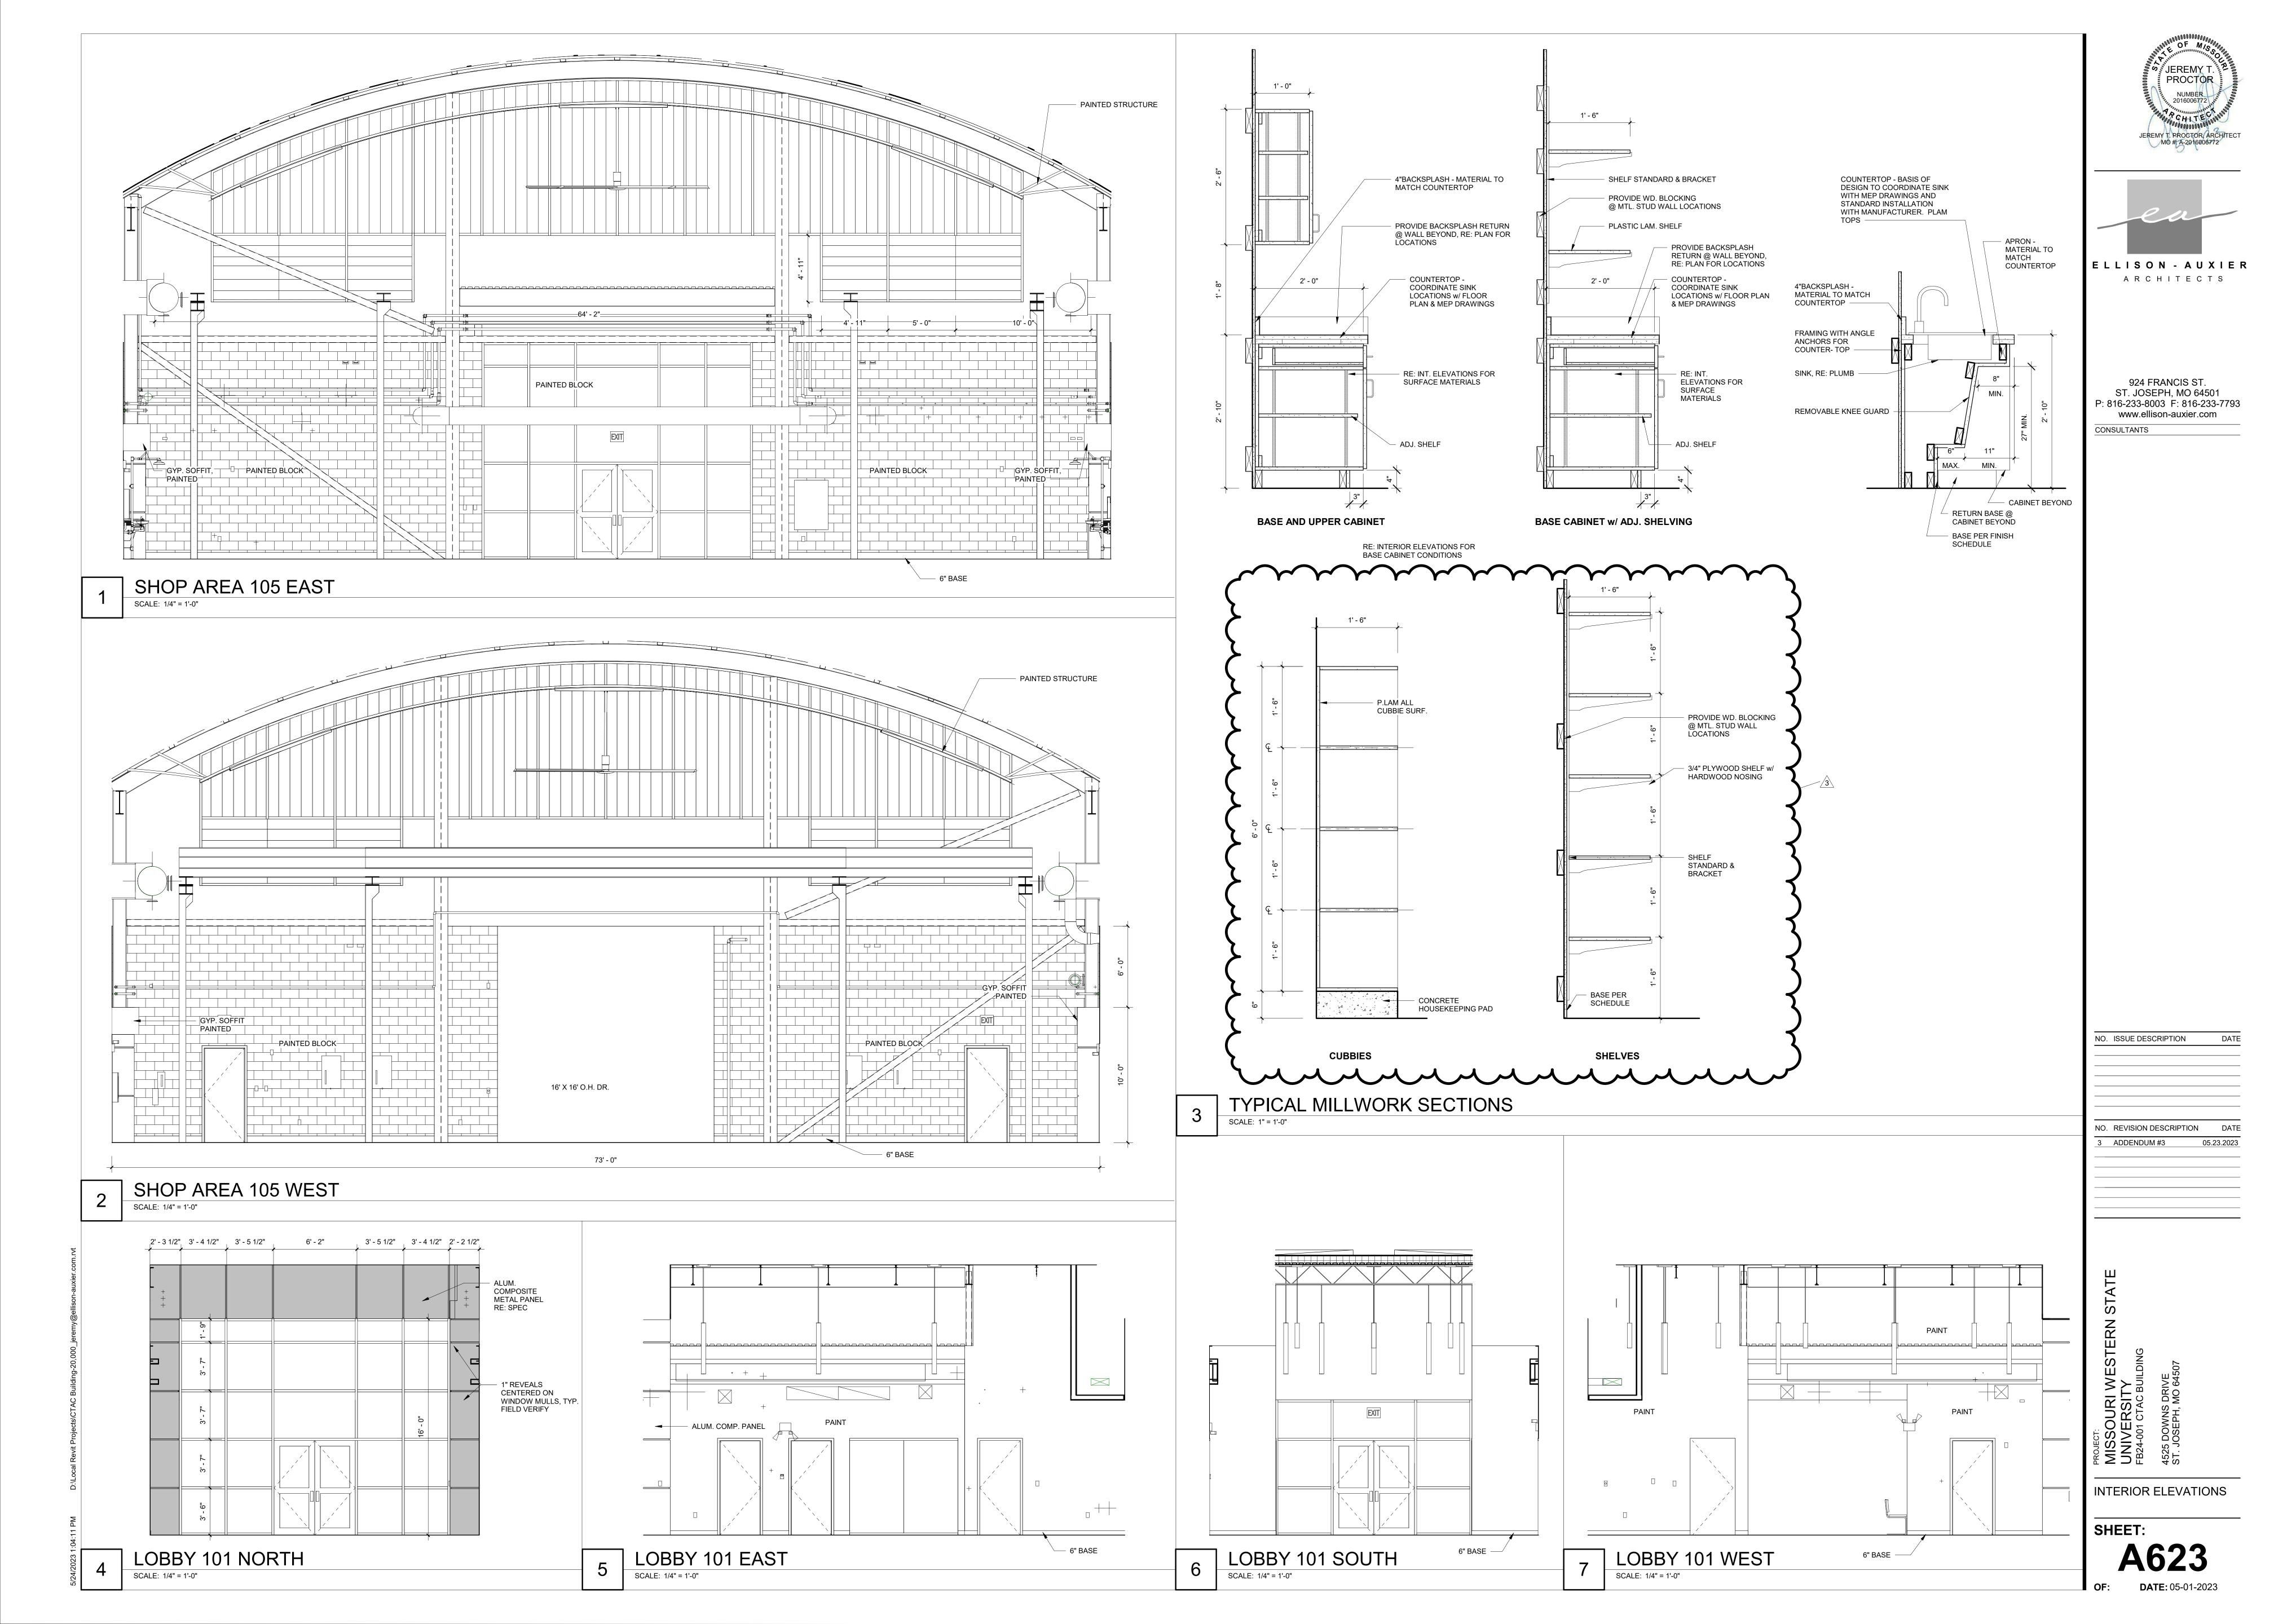


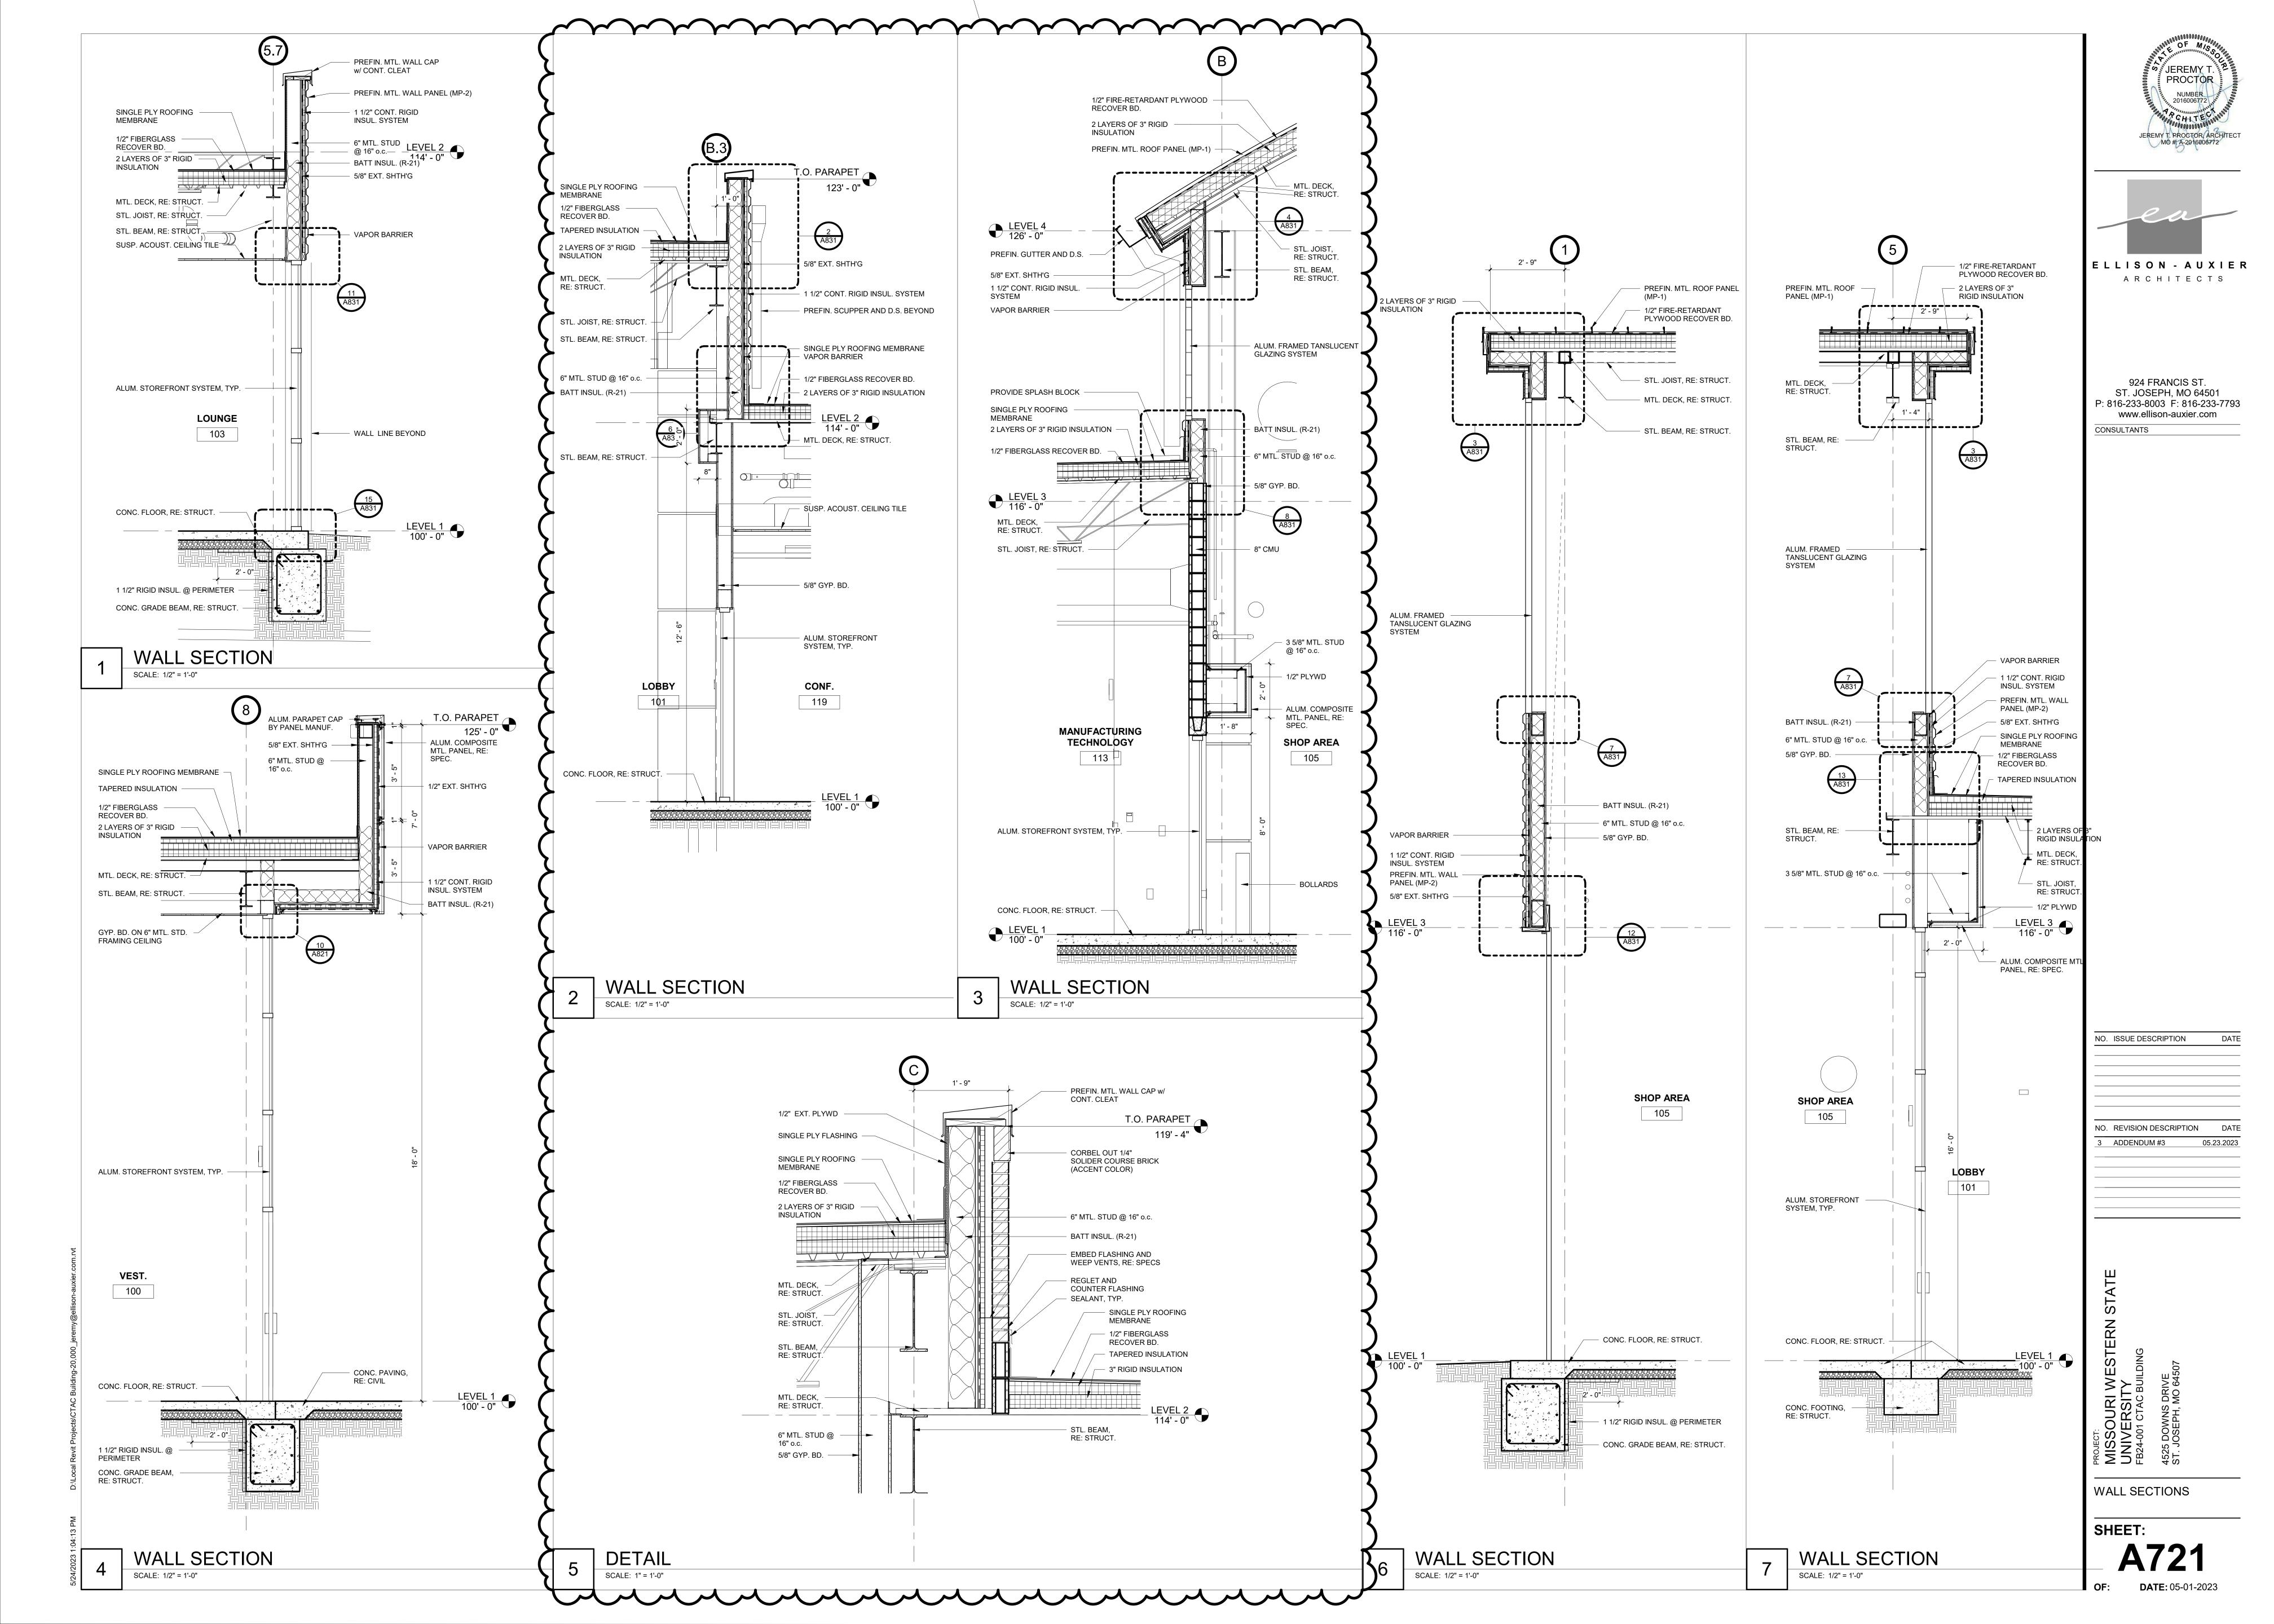

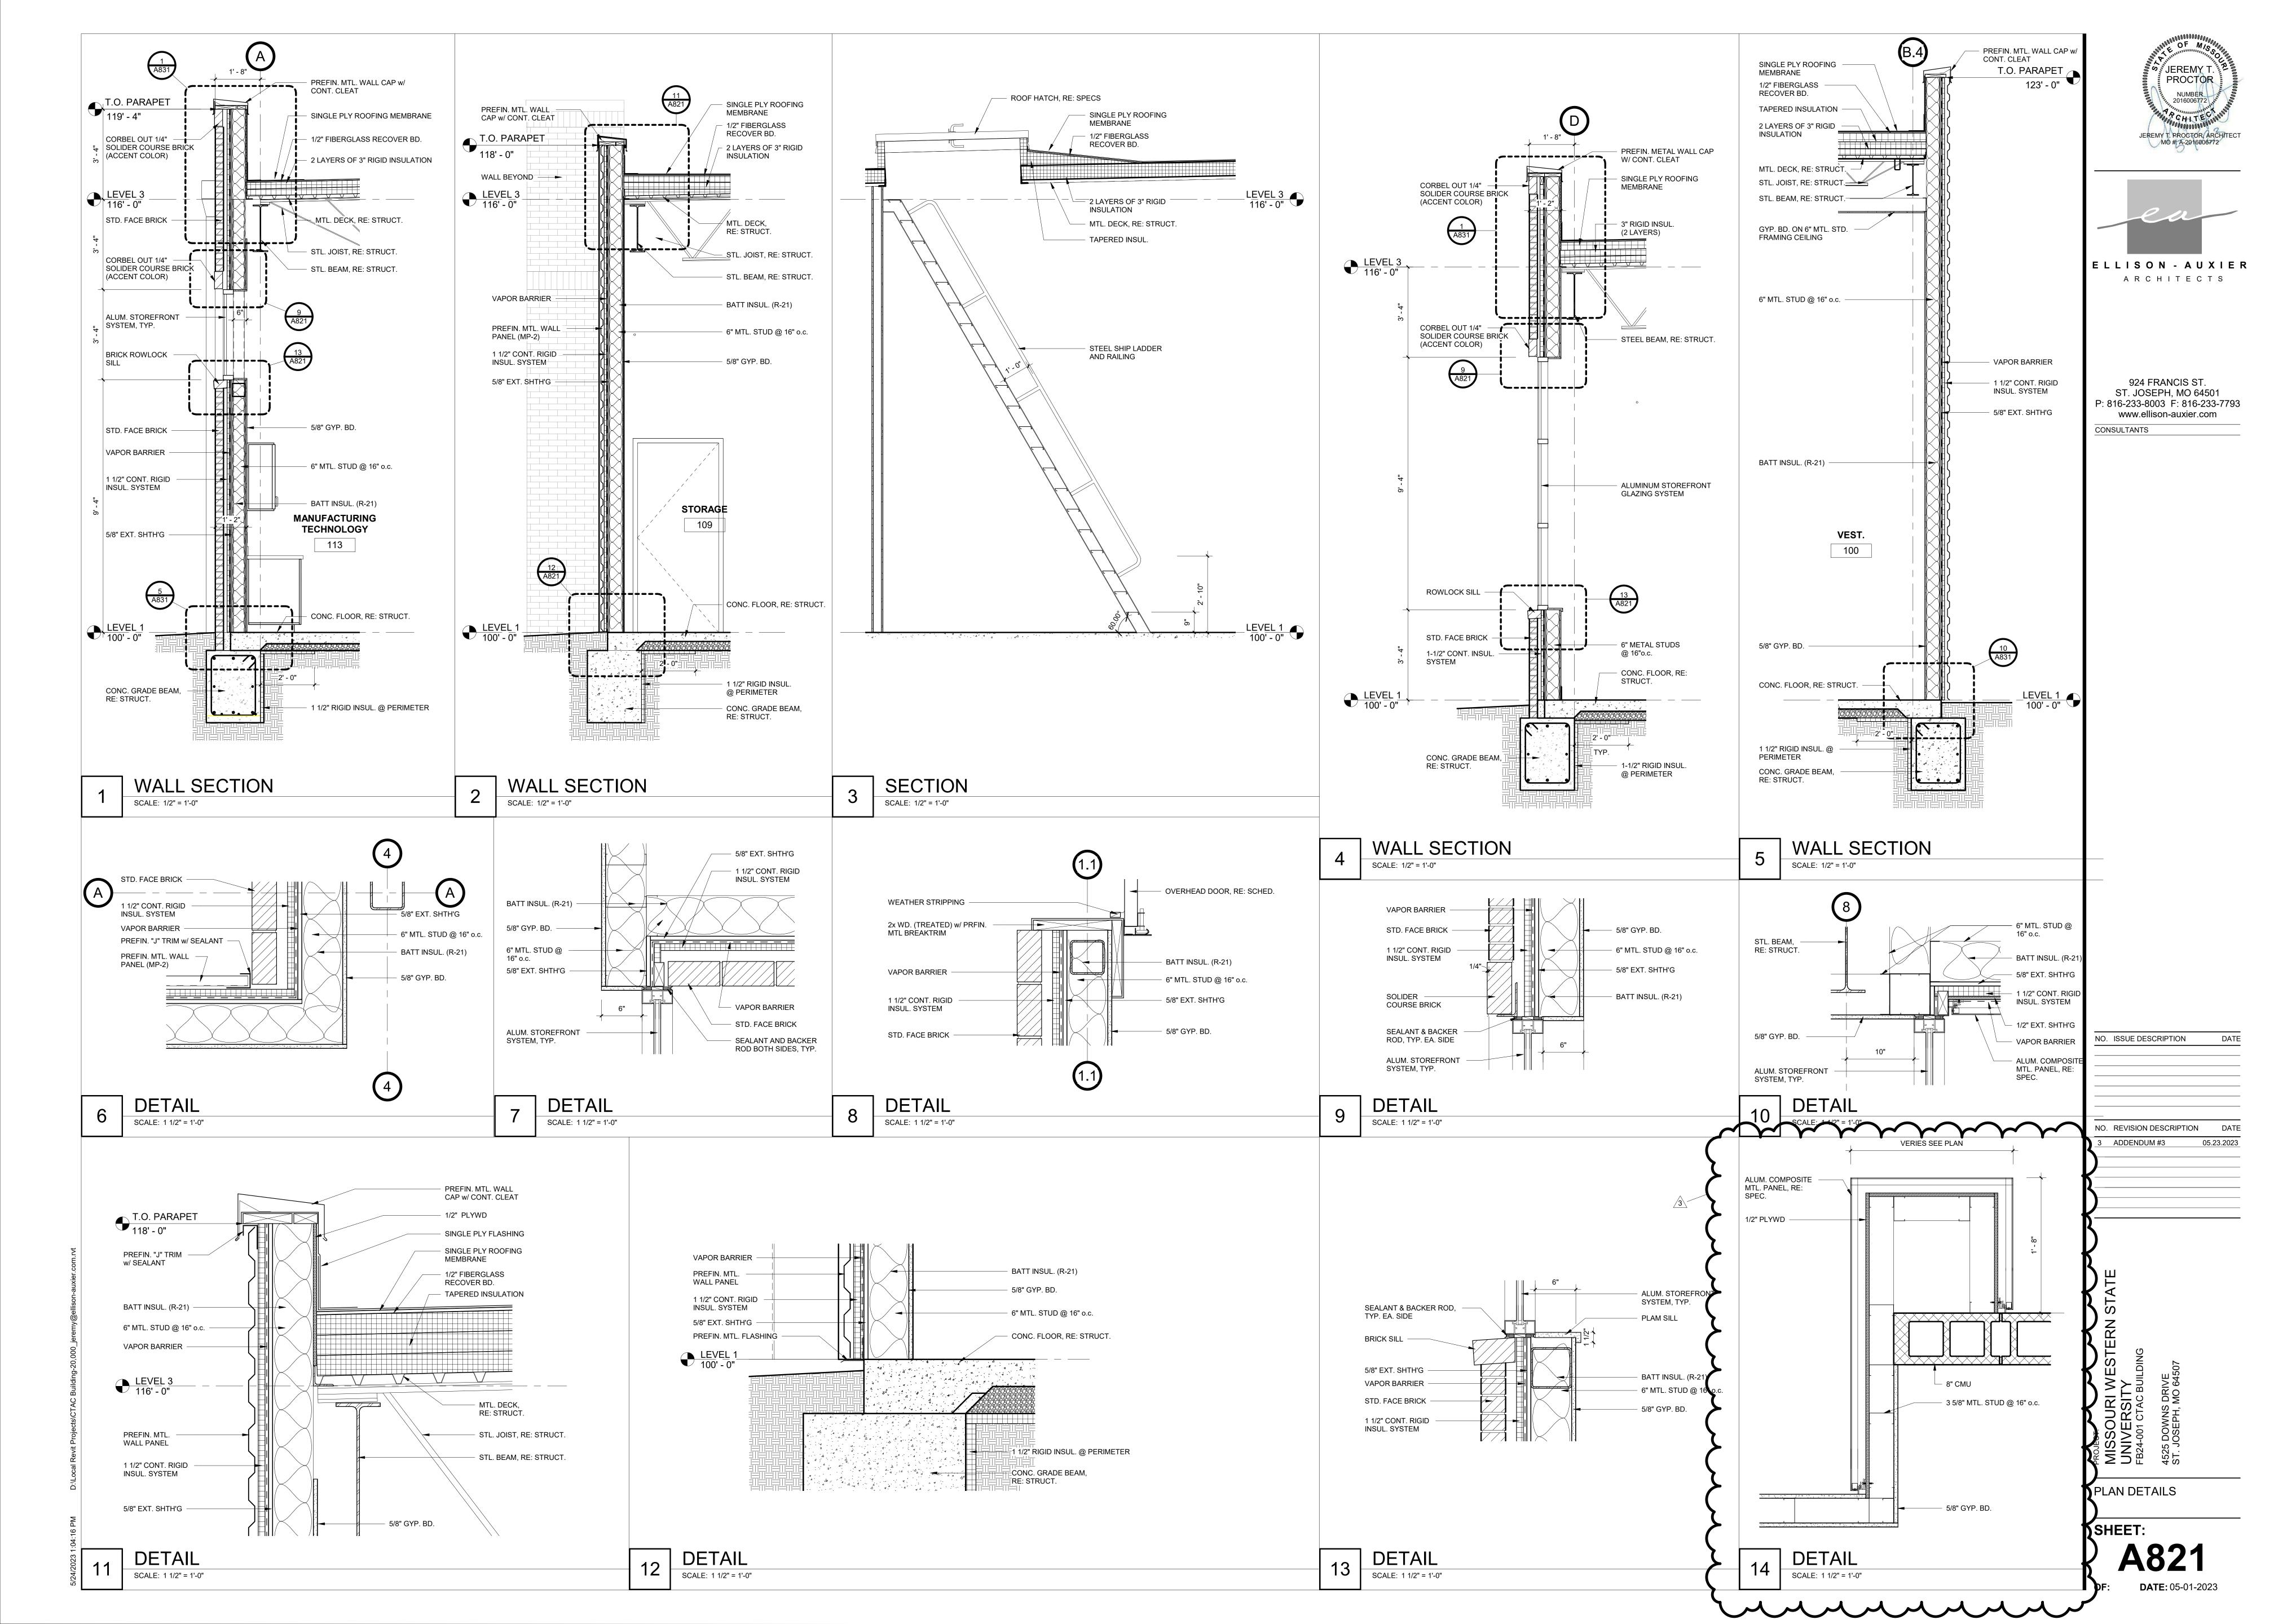

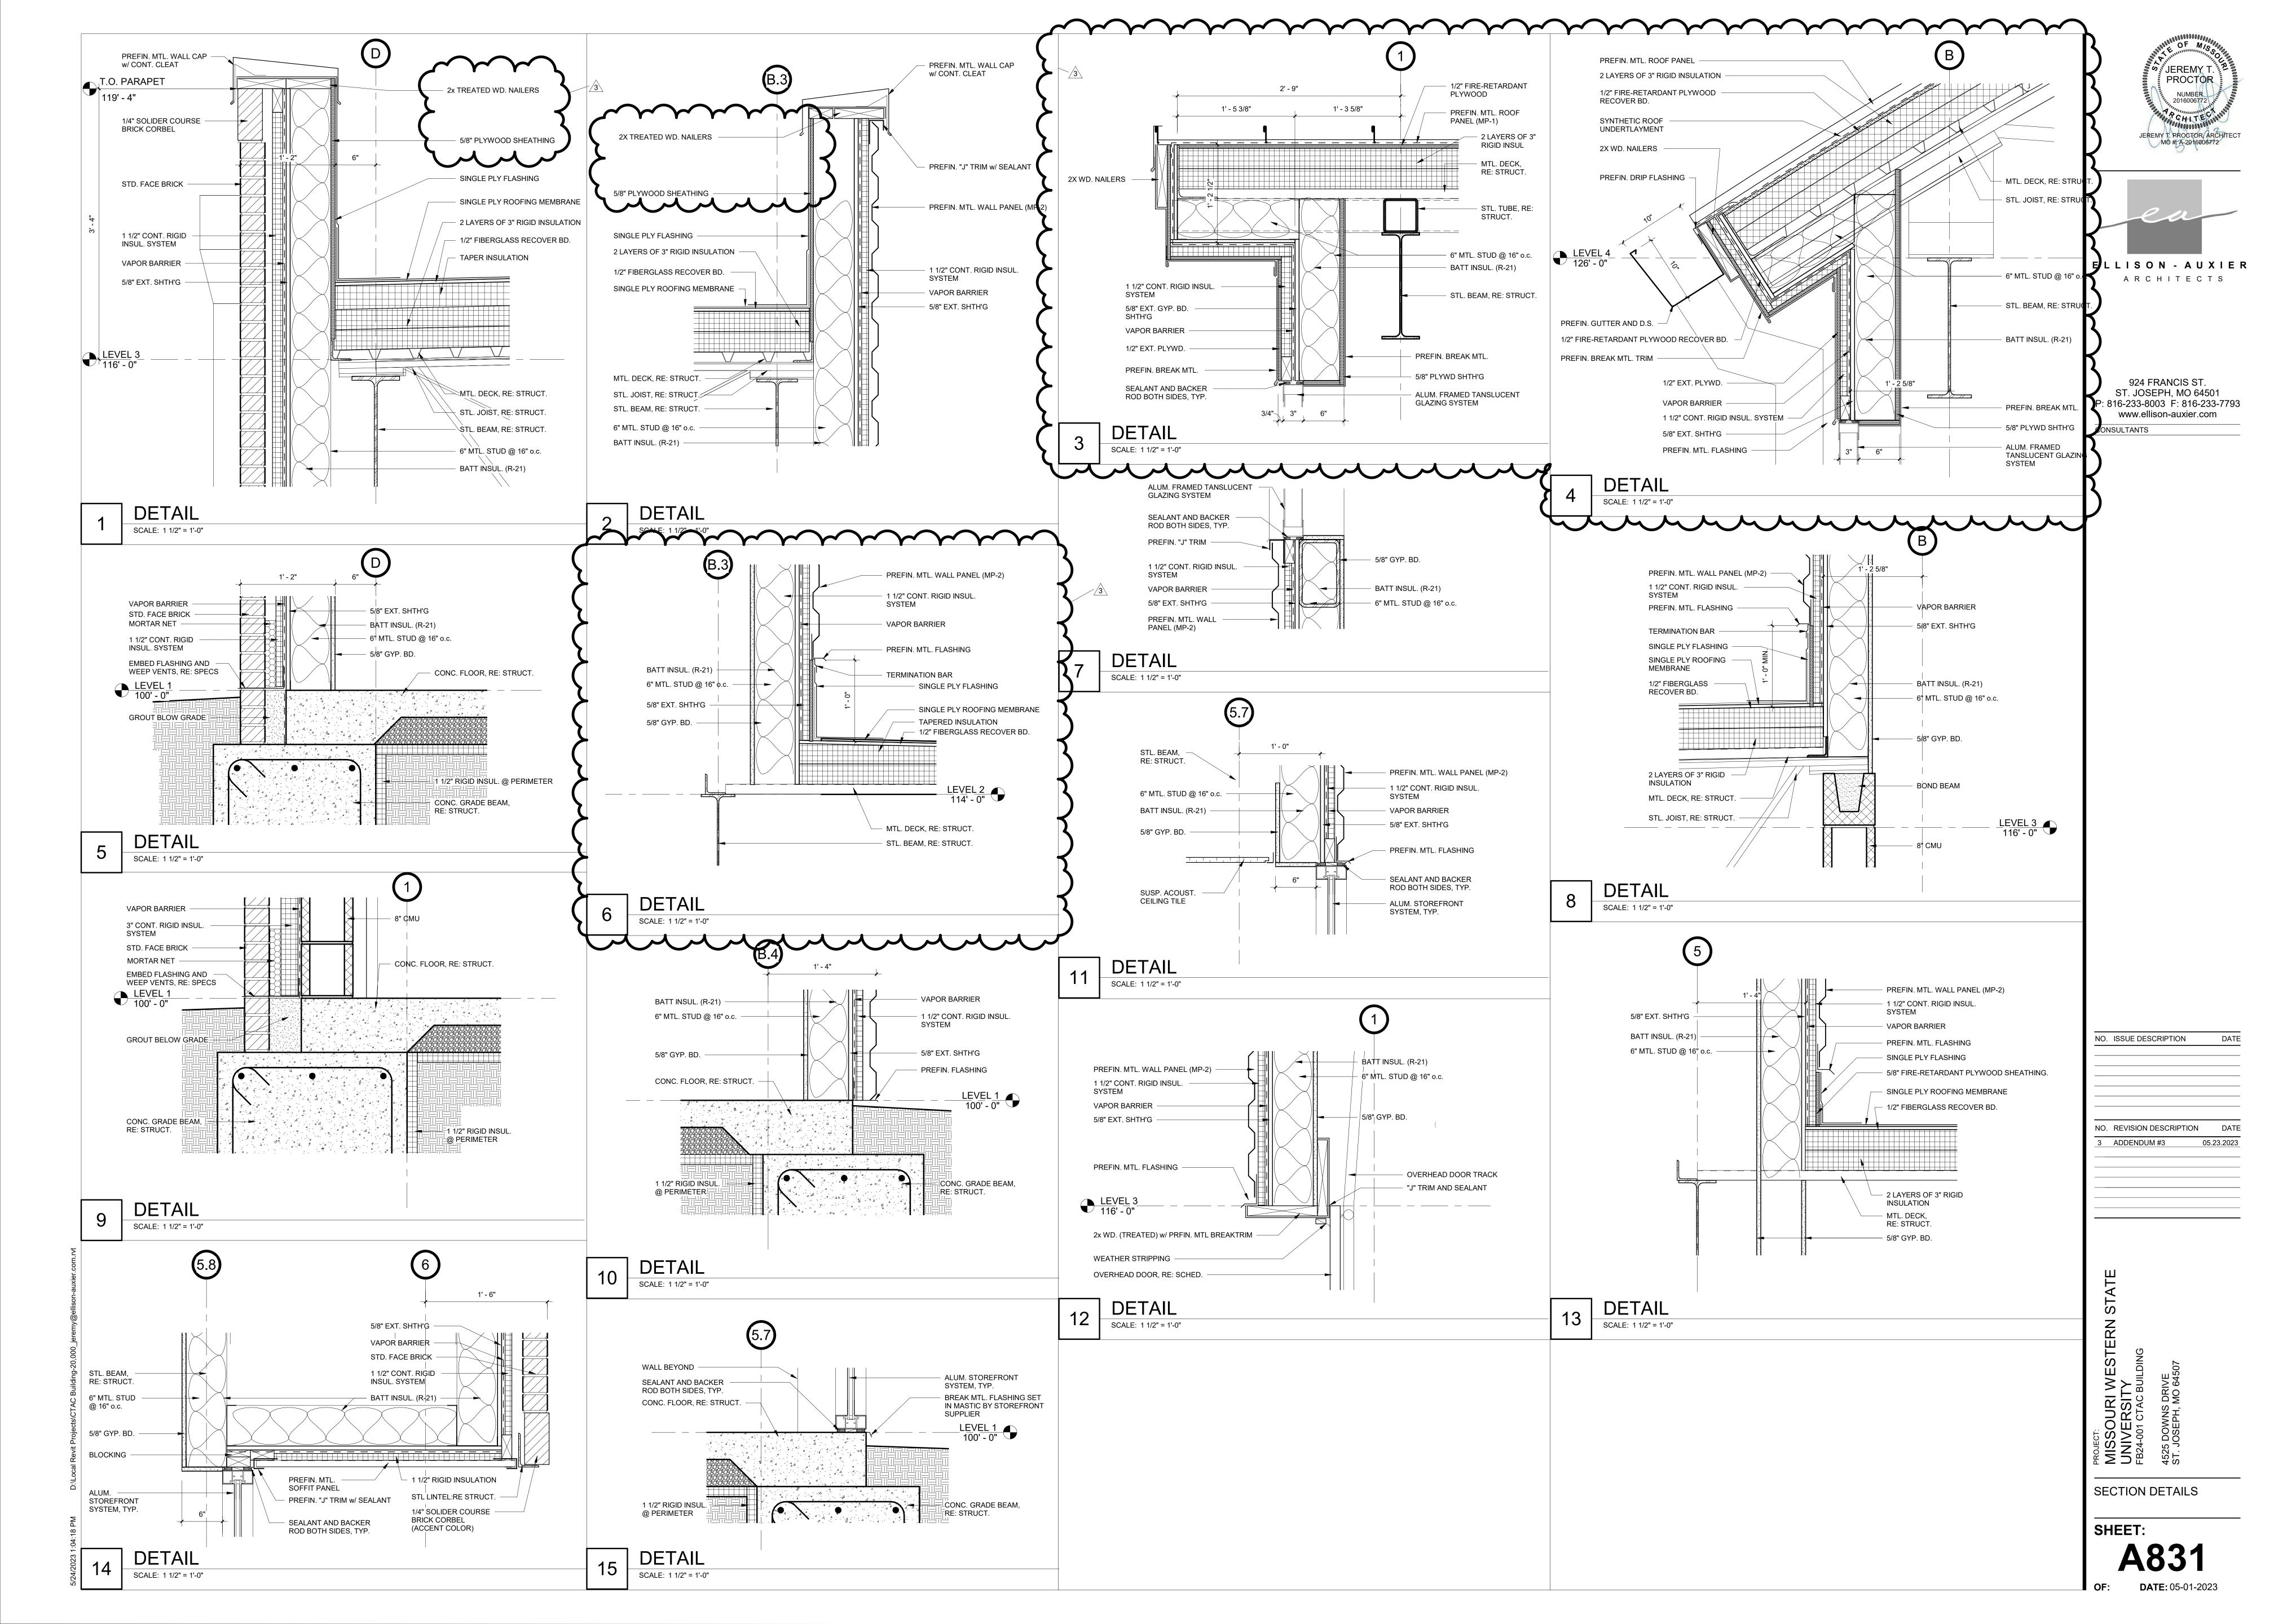

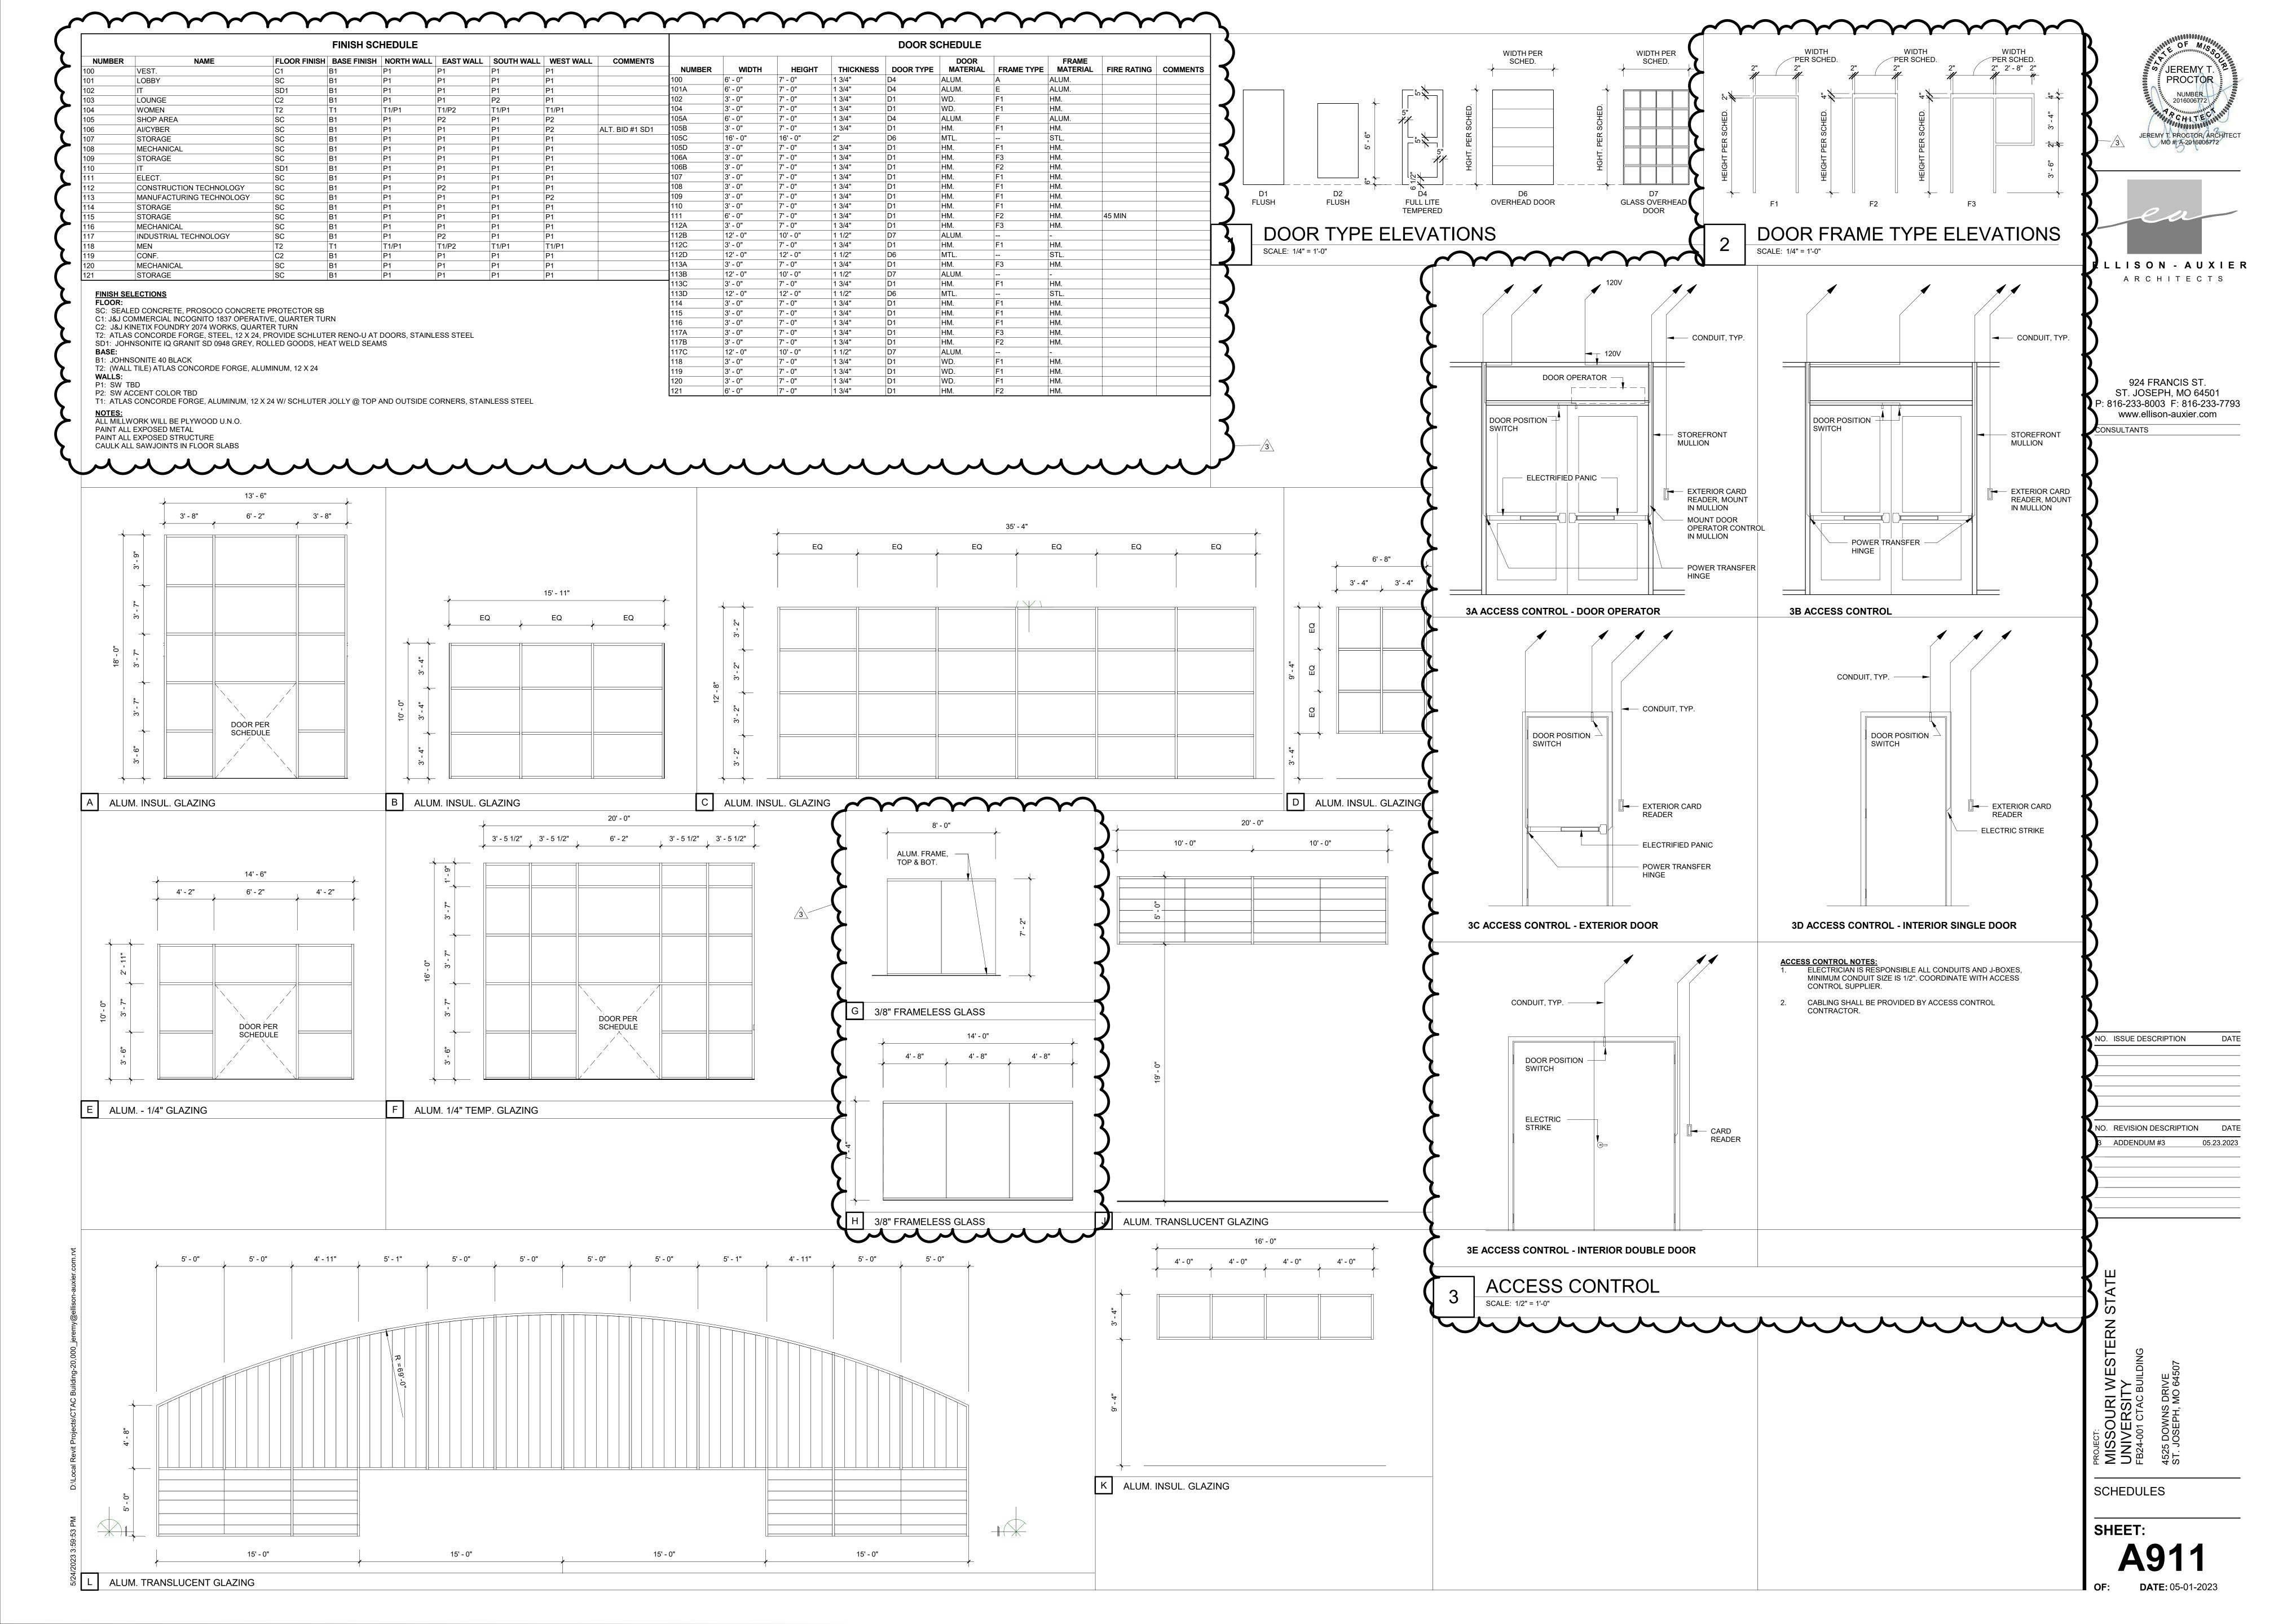

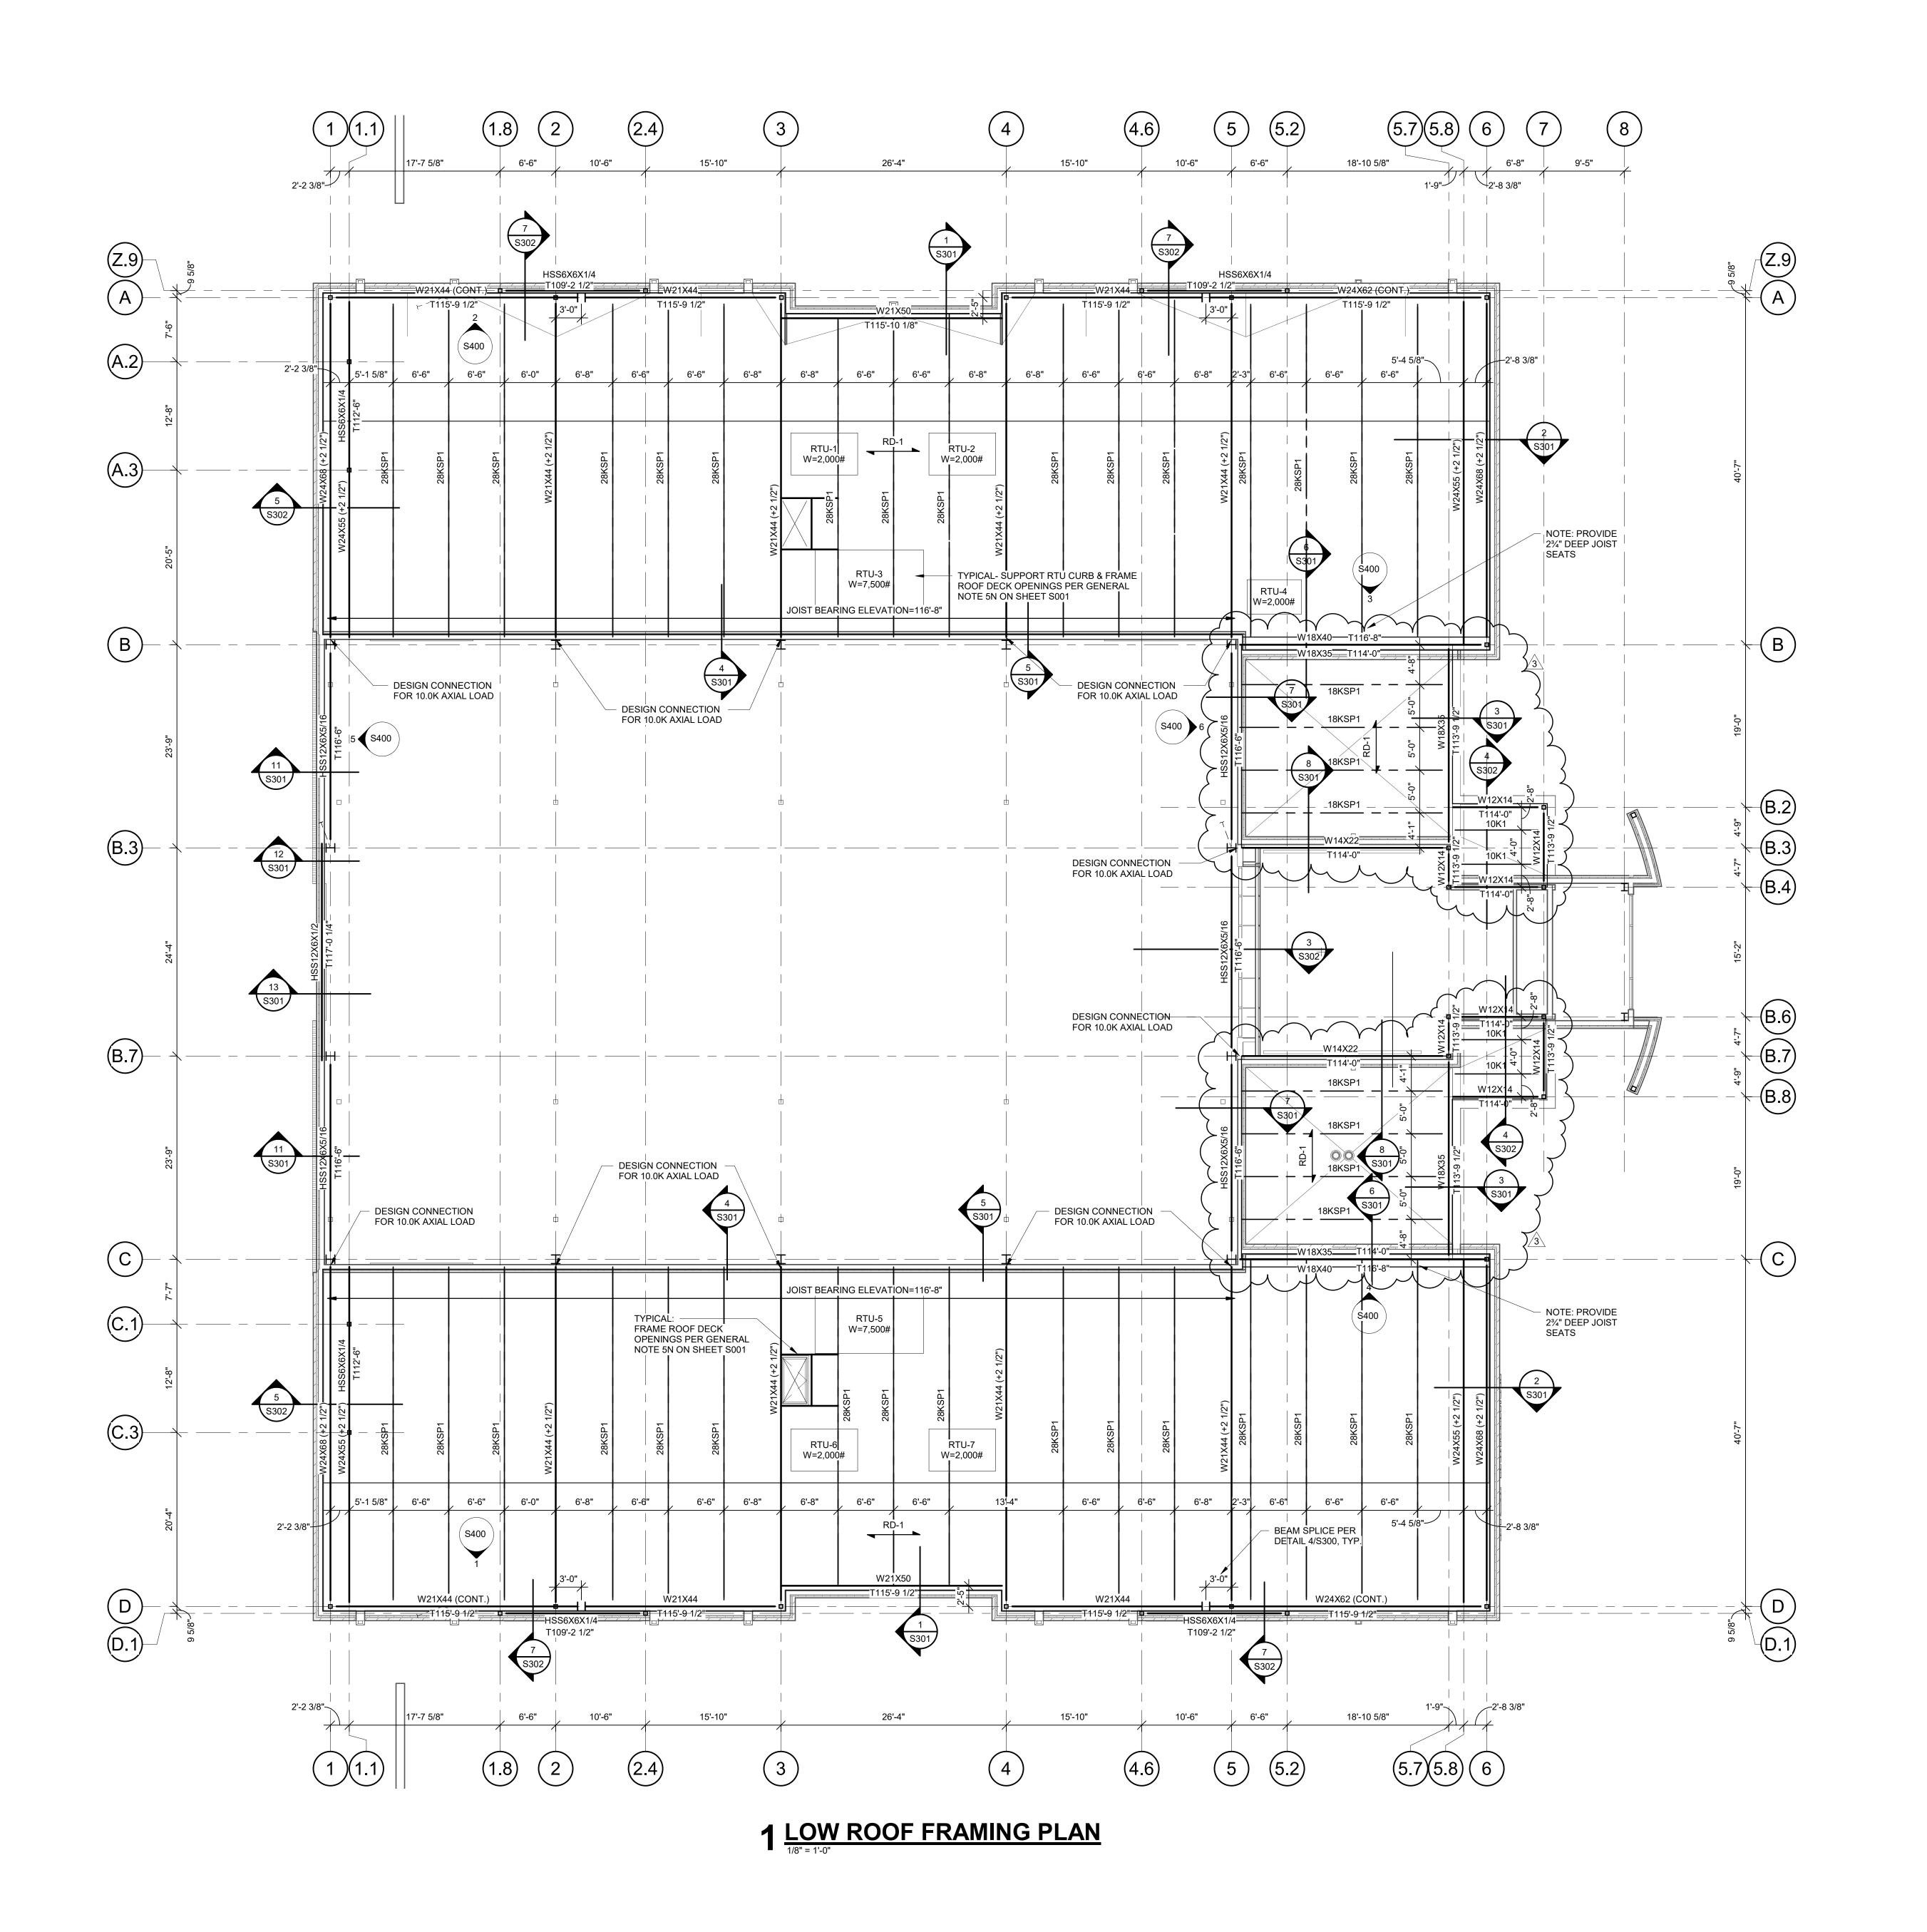



924 FRANCIS ST. ST. JOSEPH, MO 64501 P: 816-233-8003 F: 816-233-7793 www.ellison-auxier.com


NO. ISSUE DESCRIPTION DAT

NO. REVISION DESCRIPTION DATE
3 ADDENDUM #3 05.23.2023

SSOURI WESTERN STATINERS SENDERSITY
AC BUILDING
SE DOWNS DRIVE
JOSEPH, MO 64507


LOW ROOF FRAMING PLAN


SHEET:
S101

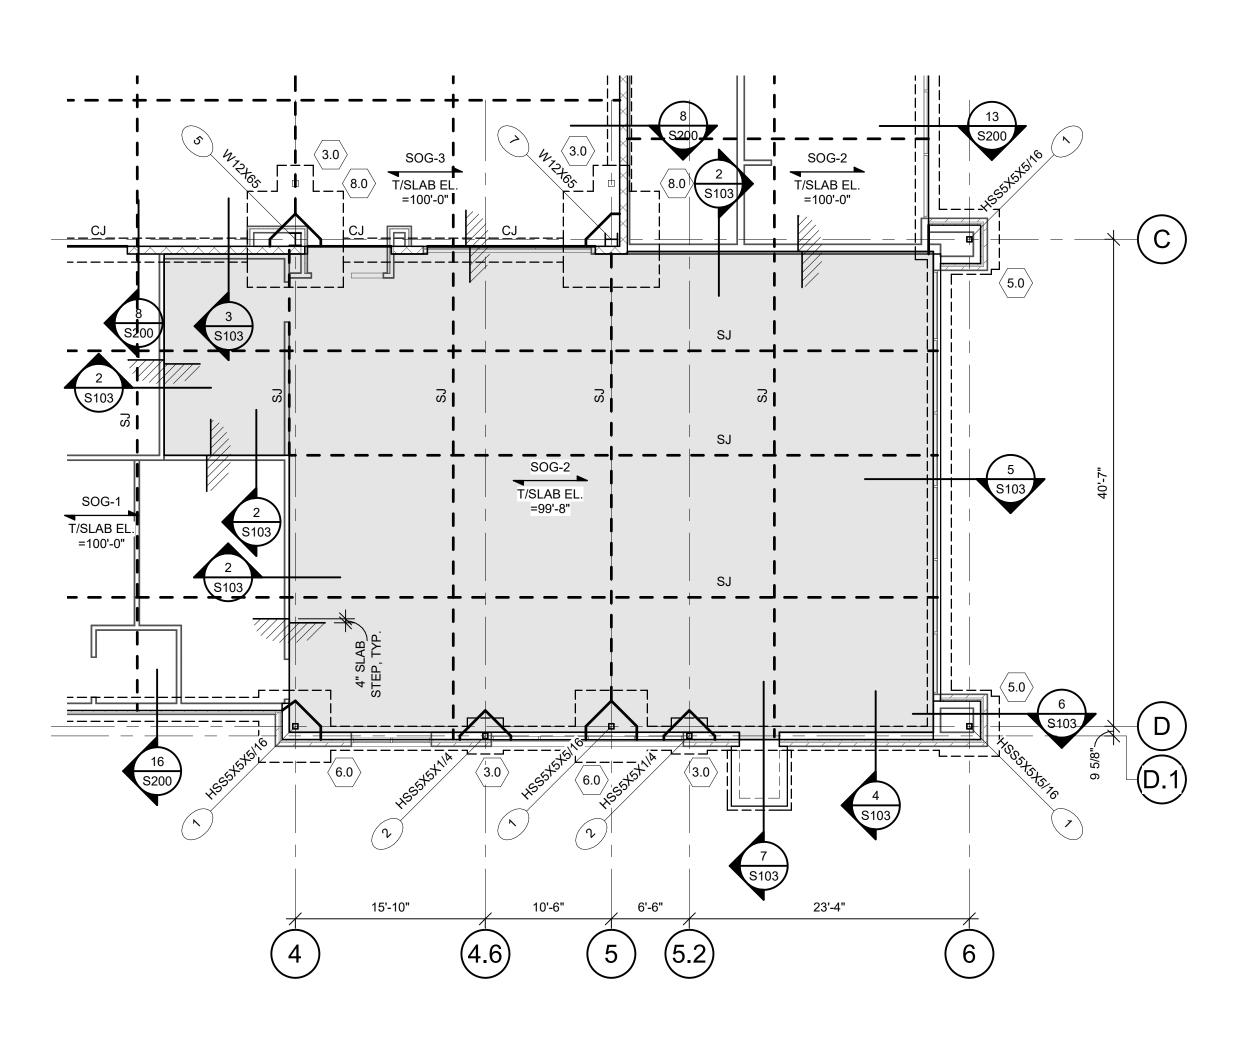



1 FOUNDATION PLAN - ALTERNATE BID #1

ALTERNATE BID #1 ENCOMPASSES THE RECESSED SLAB (HIGHLIGHTED IN GRAY ON PLAN). REFER TO SHEET S100 FOR ALL INFORMATION NOT SHOWN.

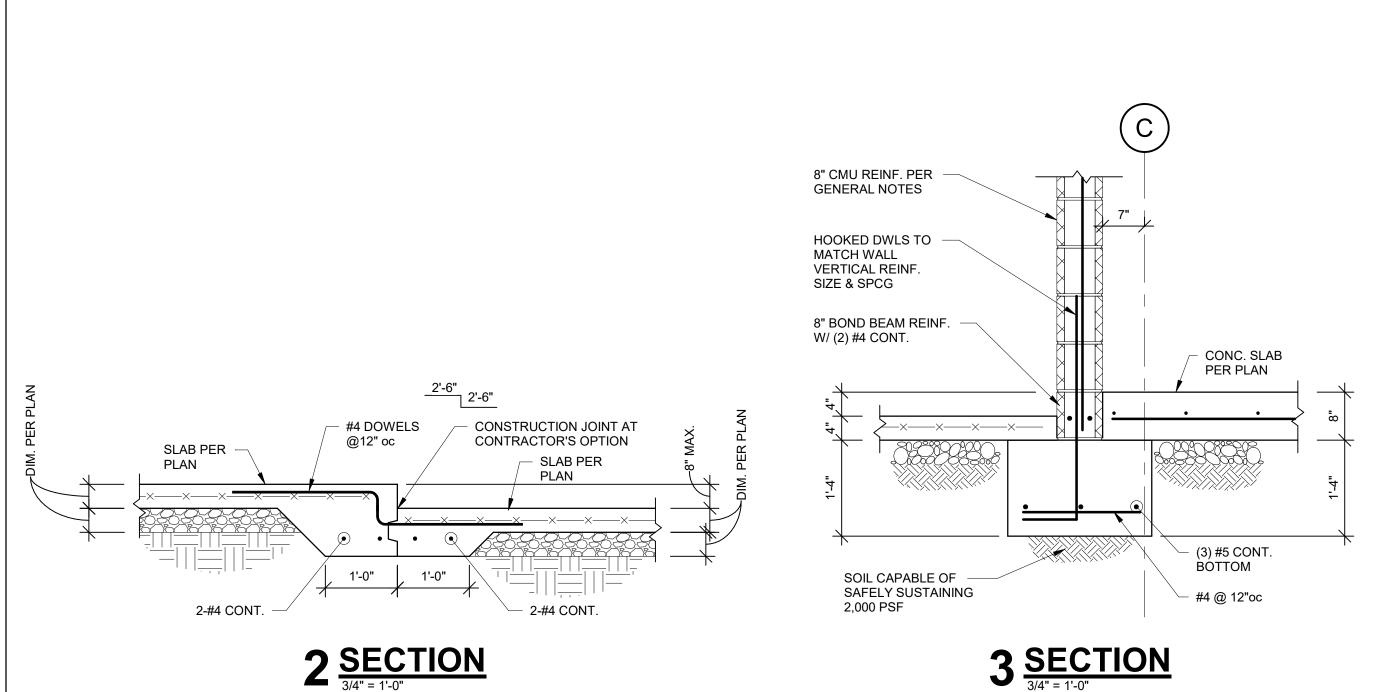


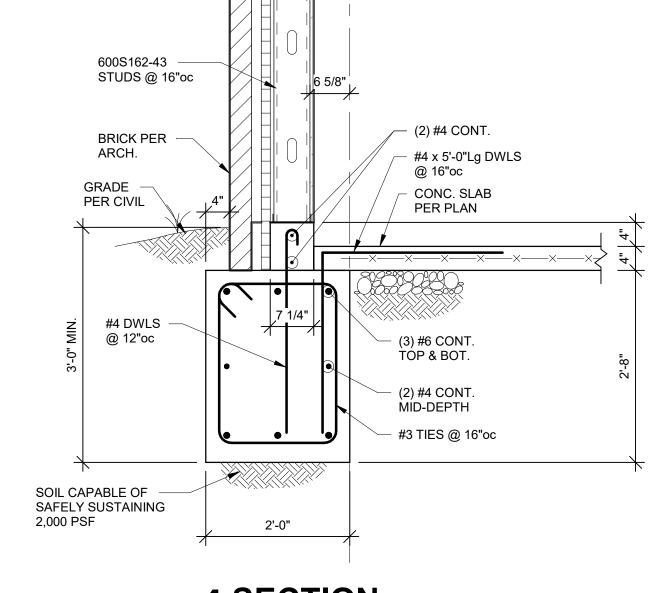

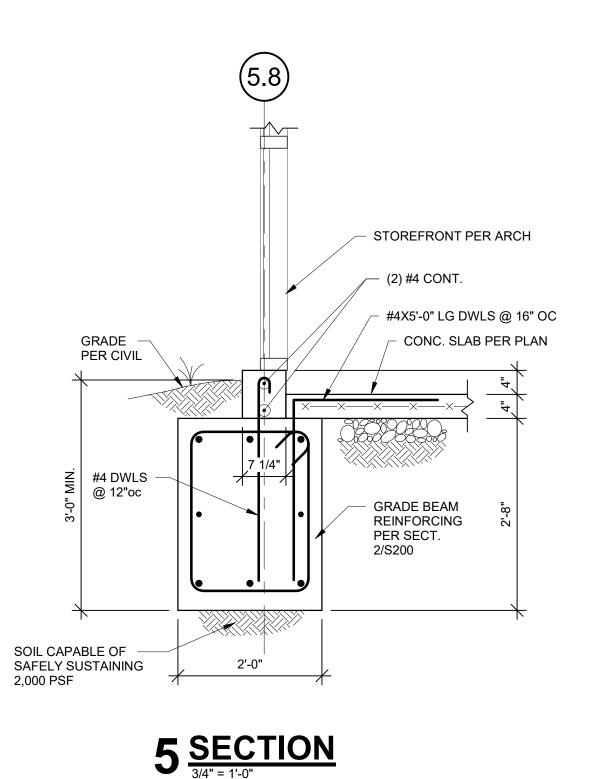

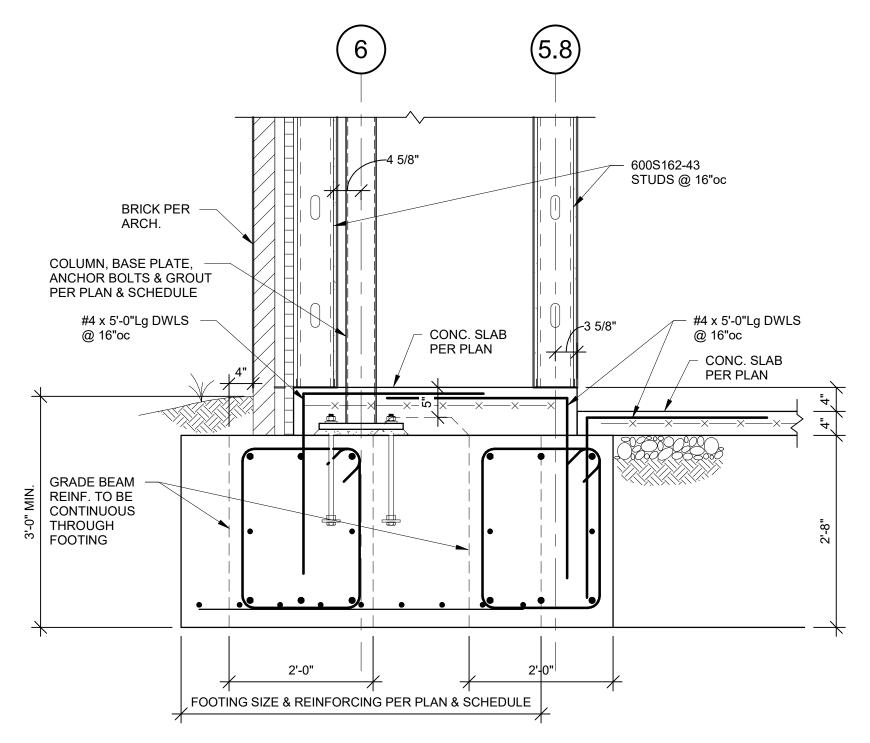

6 **SECTION**

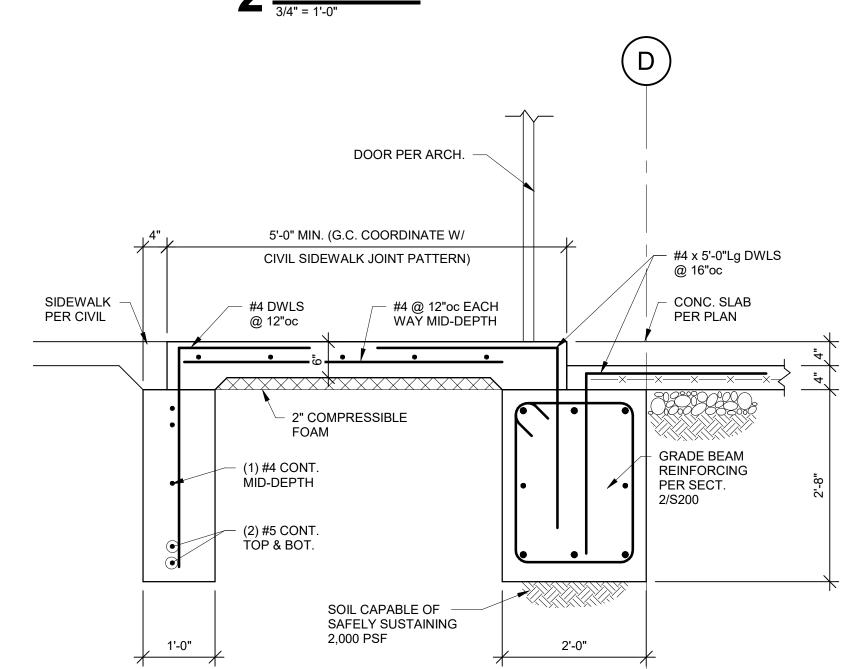

7 SECTION 3/4" = 1'-0"

ELLISON - AUXIER
ARCHITECTS

924 FRANCIS ST. ST. JOSEPH, MO 64501 P: 816-233-8003 F: 816-233-7793 www.ellison-auxier.com

NO. ISSUE DESCRIPTION DATE

NO. REVISION DESCRIPTION DATE

3 ADDENDUM #3 05.23.2023

3 ADDENDUM #3 05.23.2

SOURI WESTERN STATE
/ERSITY
BUILDING


MINDATION PI


FOUNDATION PLAN -ALTERNATE BID #1


SHEET:

SHEET:

DATE: 5-1-23

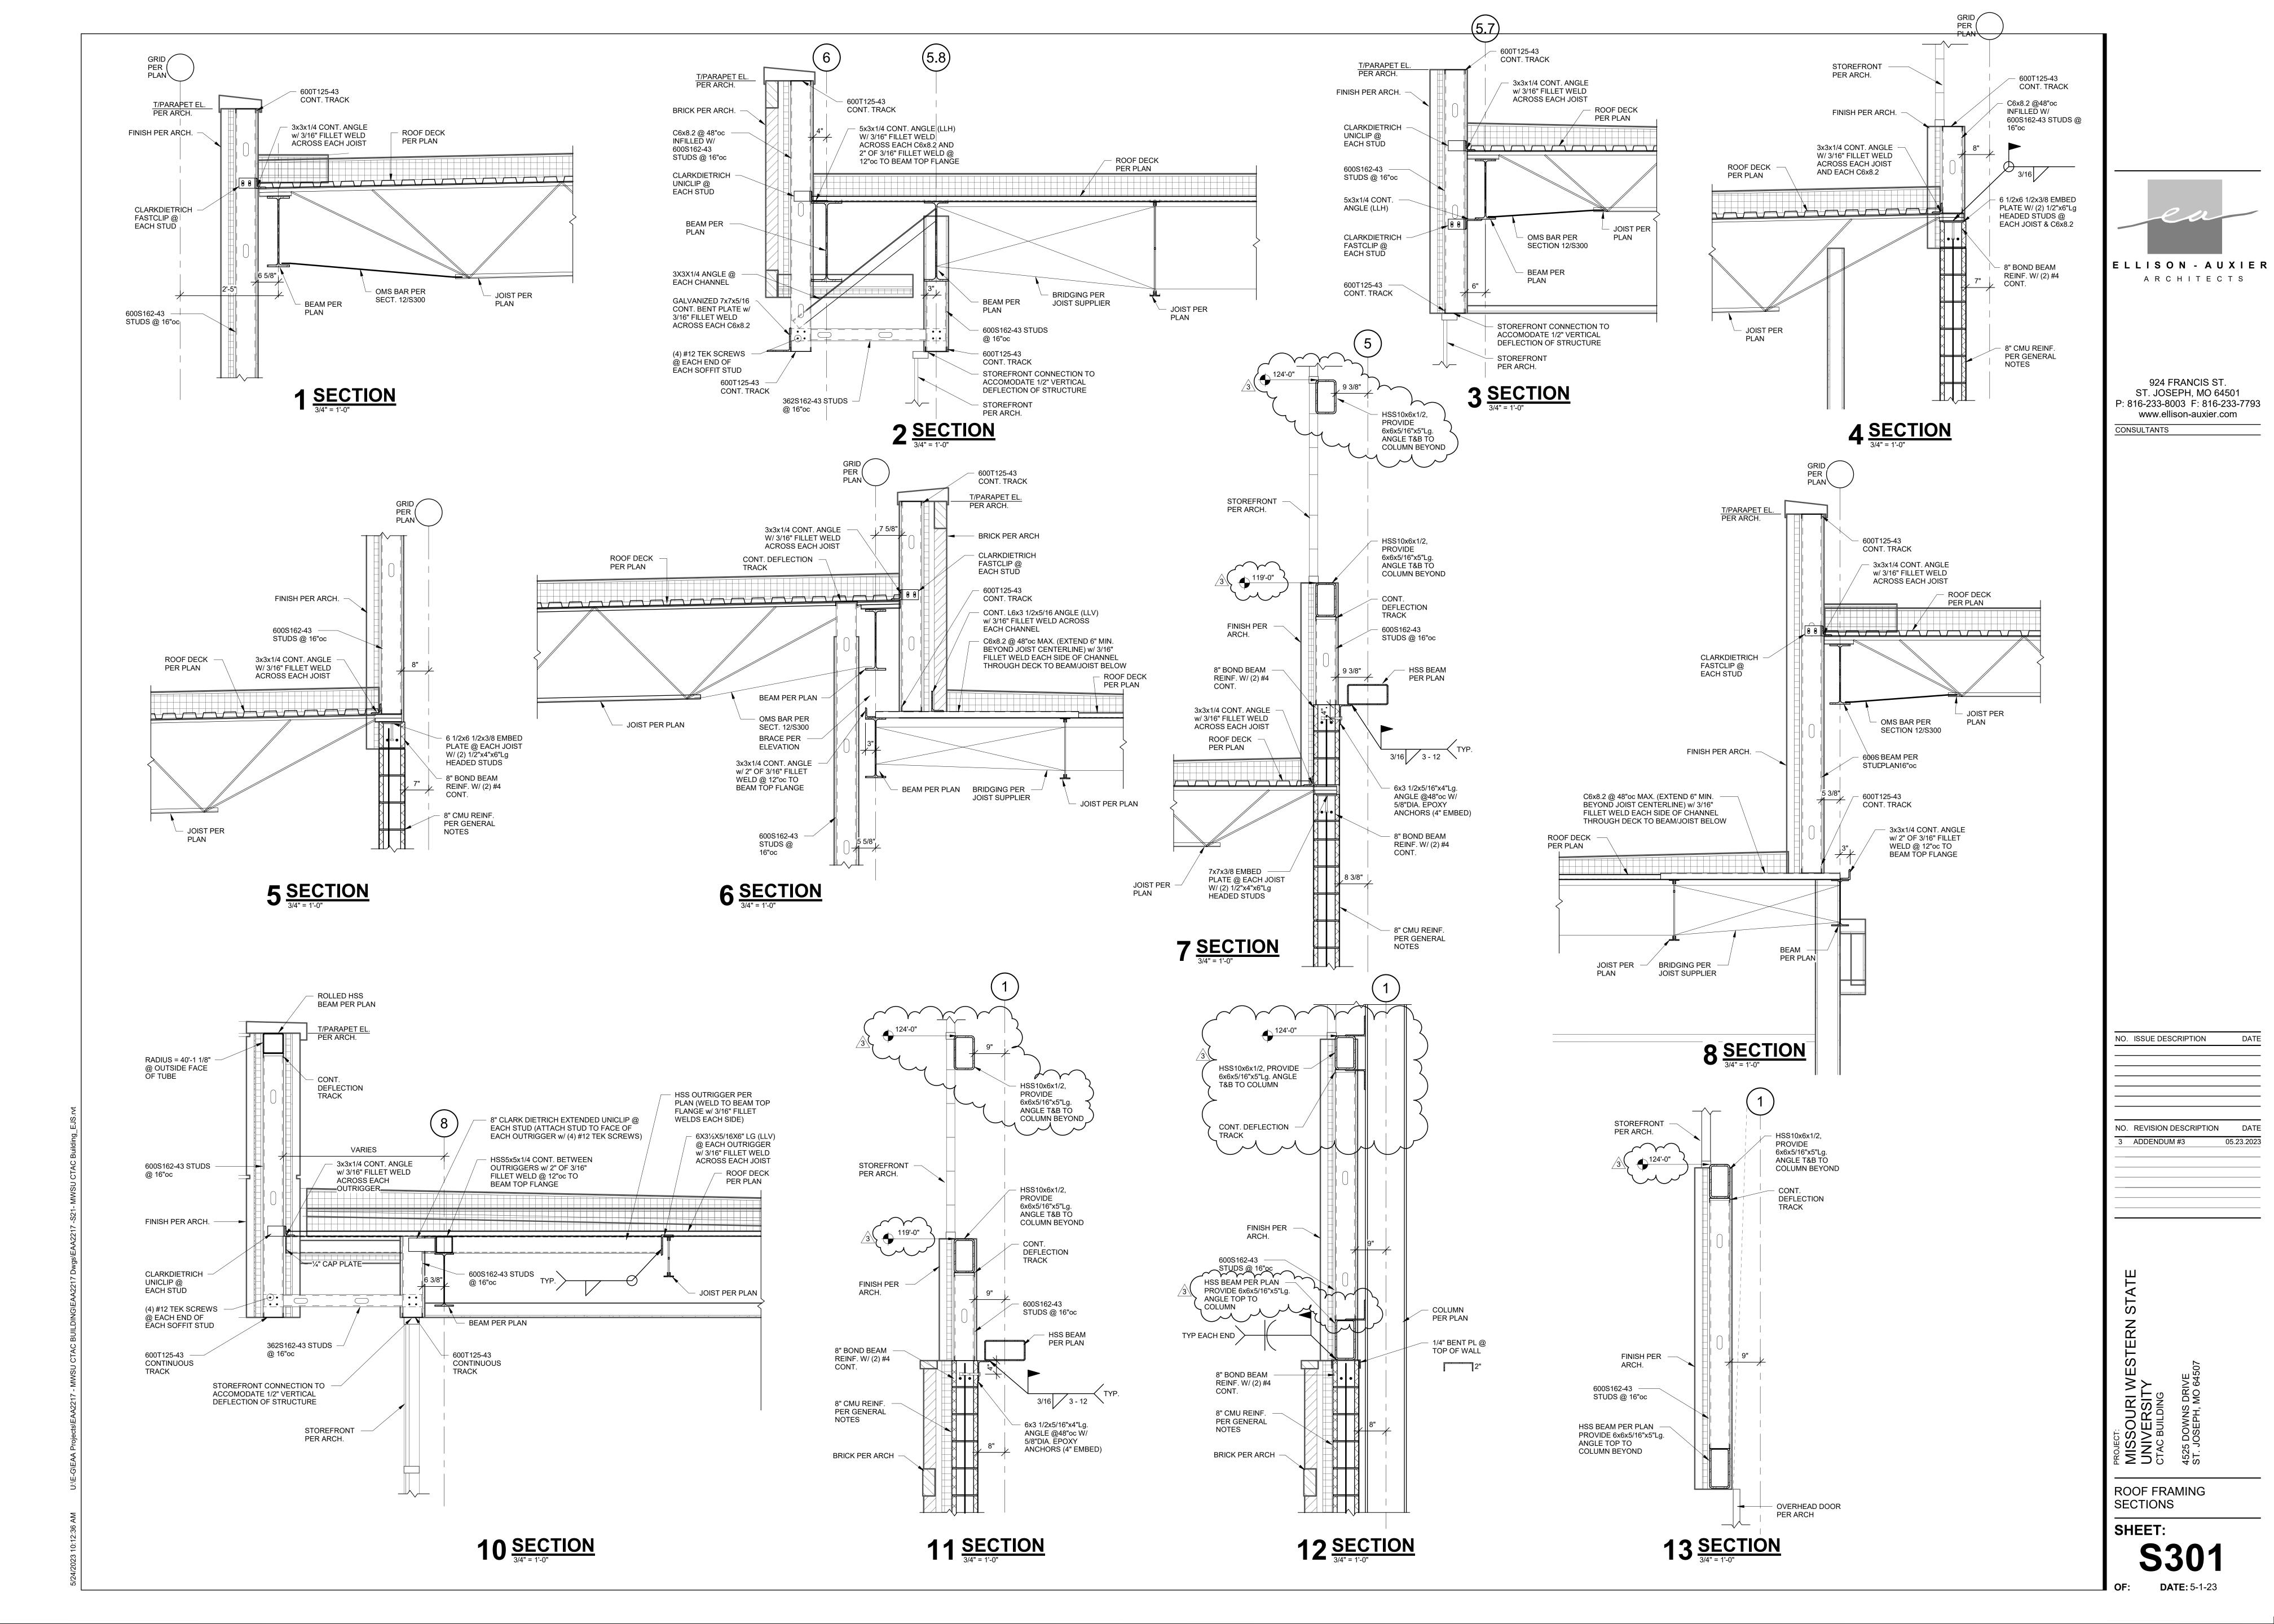

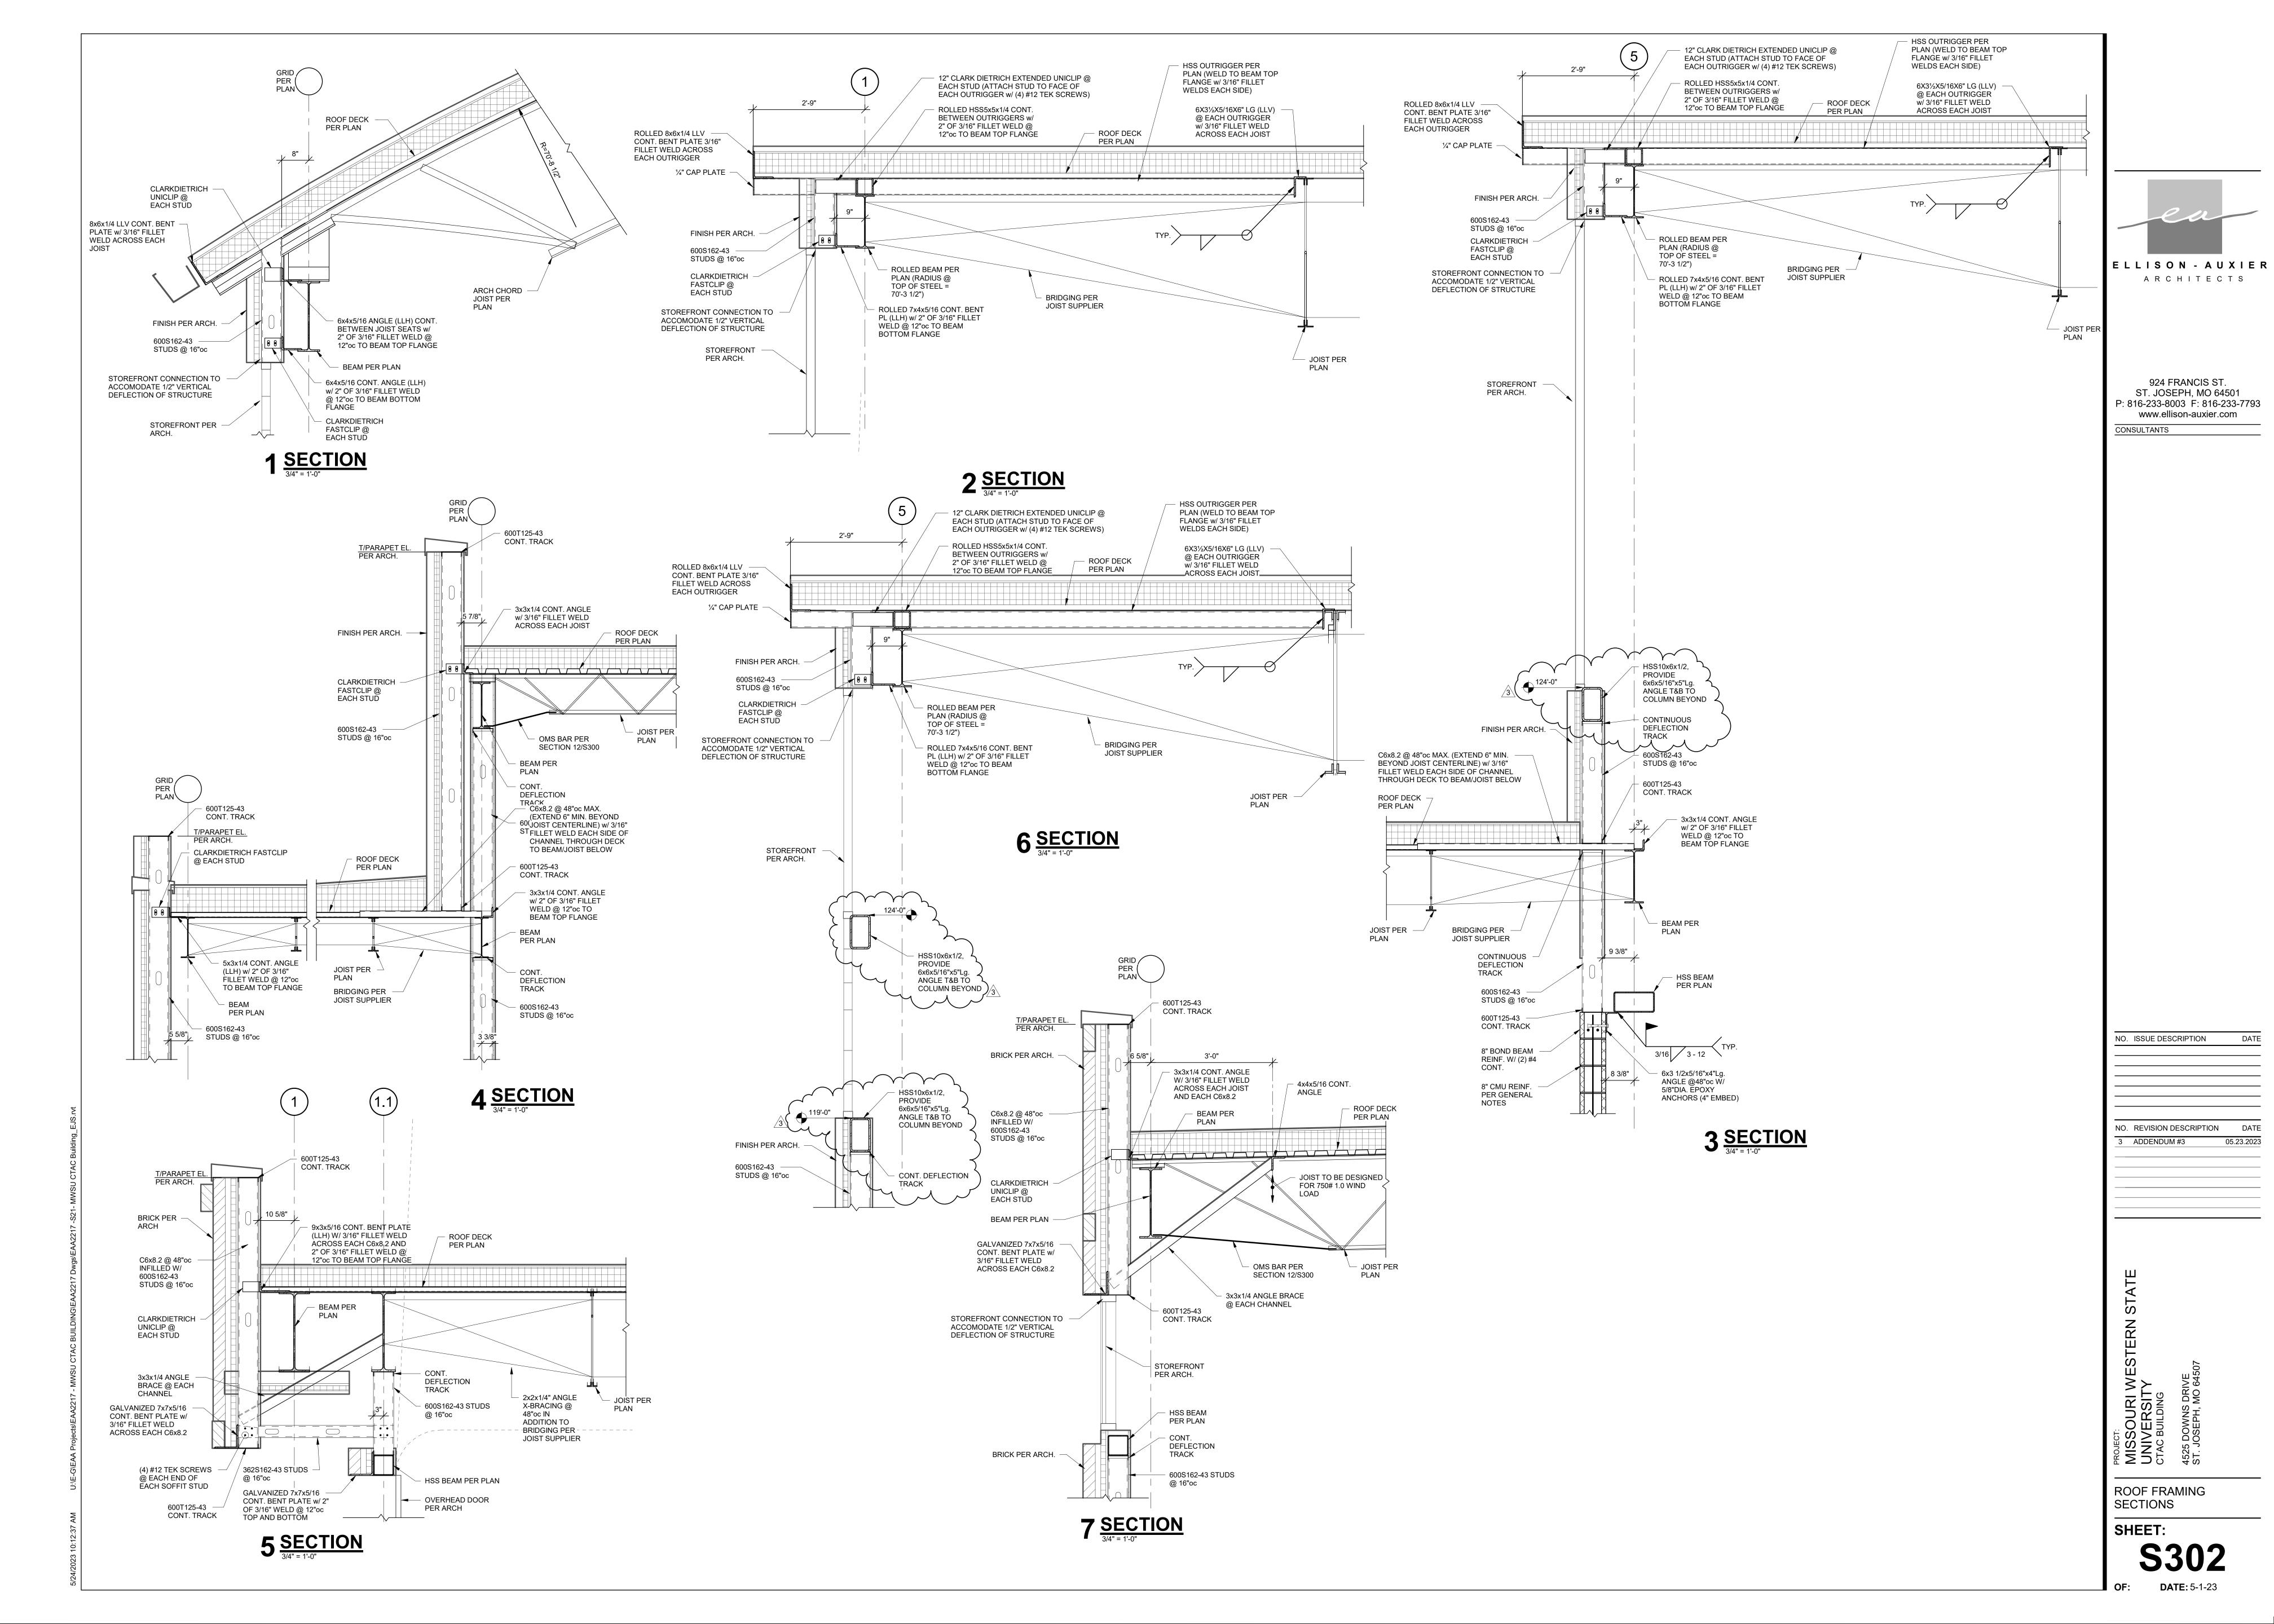

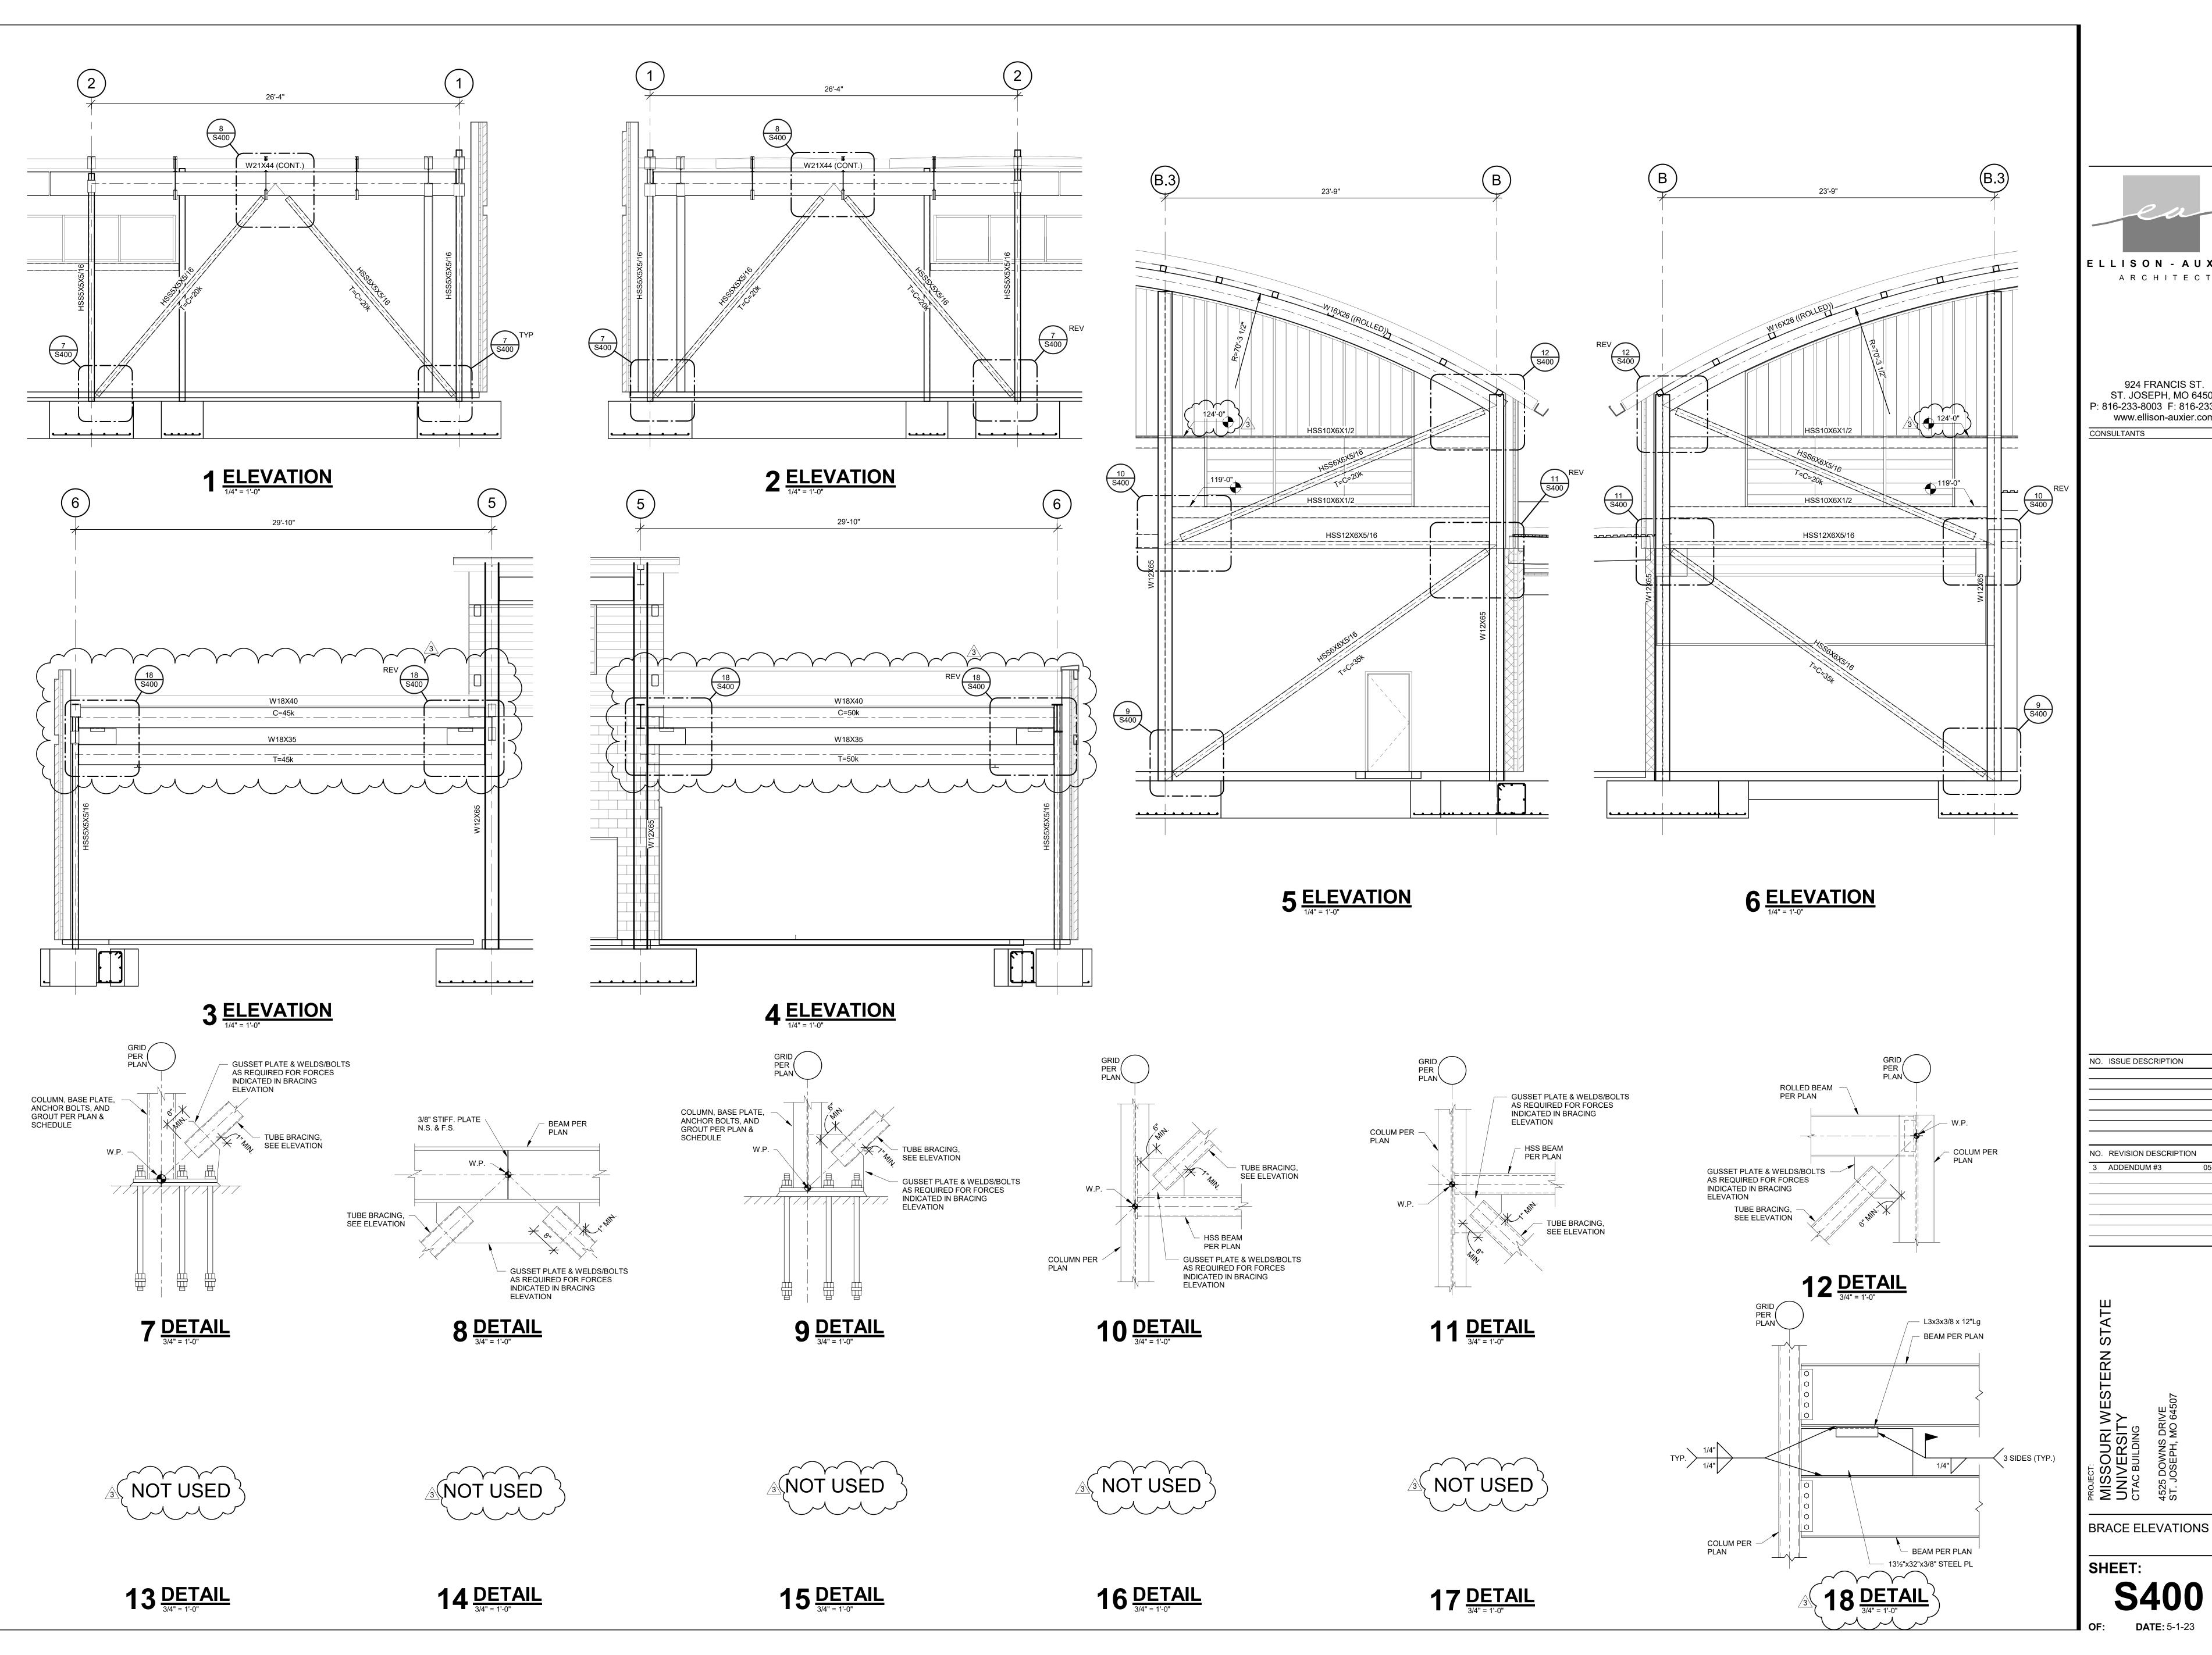




924 FRANCIS ST. ST. JOSEPH, MO 64501 P: 816-233-8003 F: 816-233-7793 www.ellison-auxier.com CONSULTANTS

05.23.2023

DATE: 5-1-23

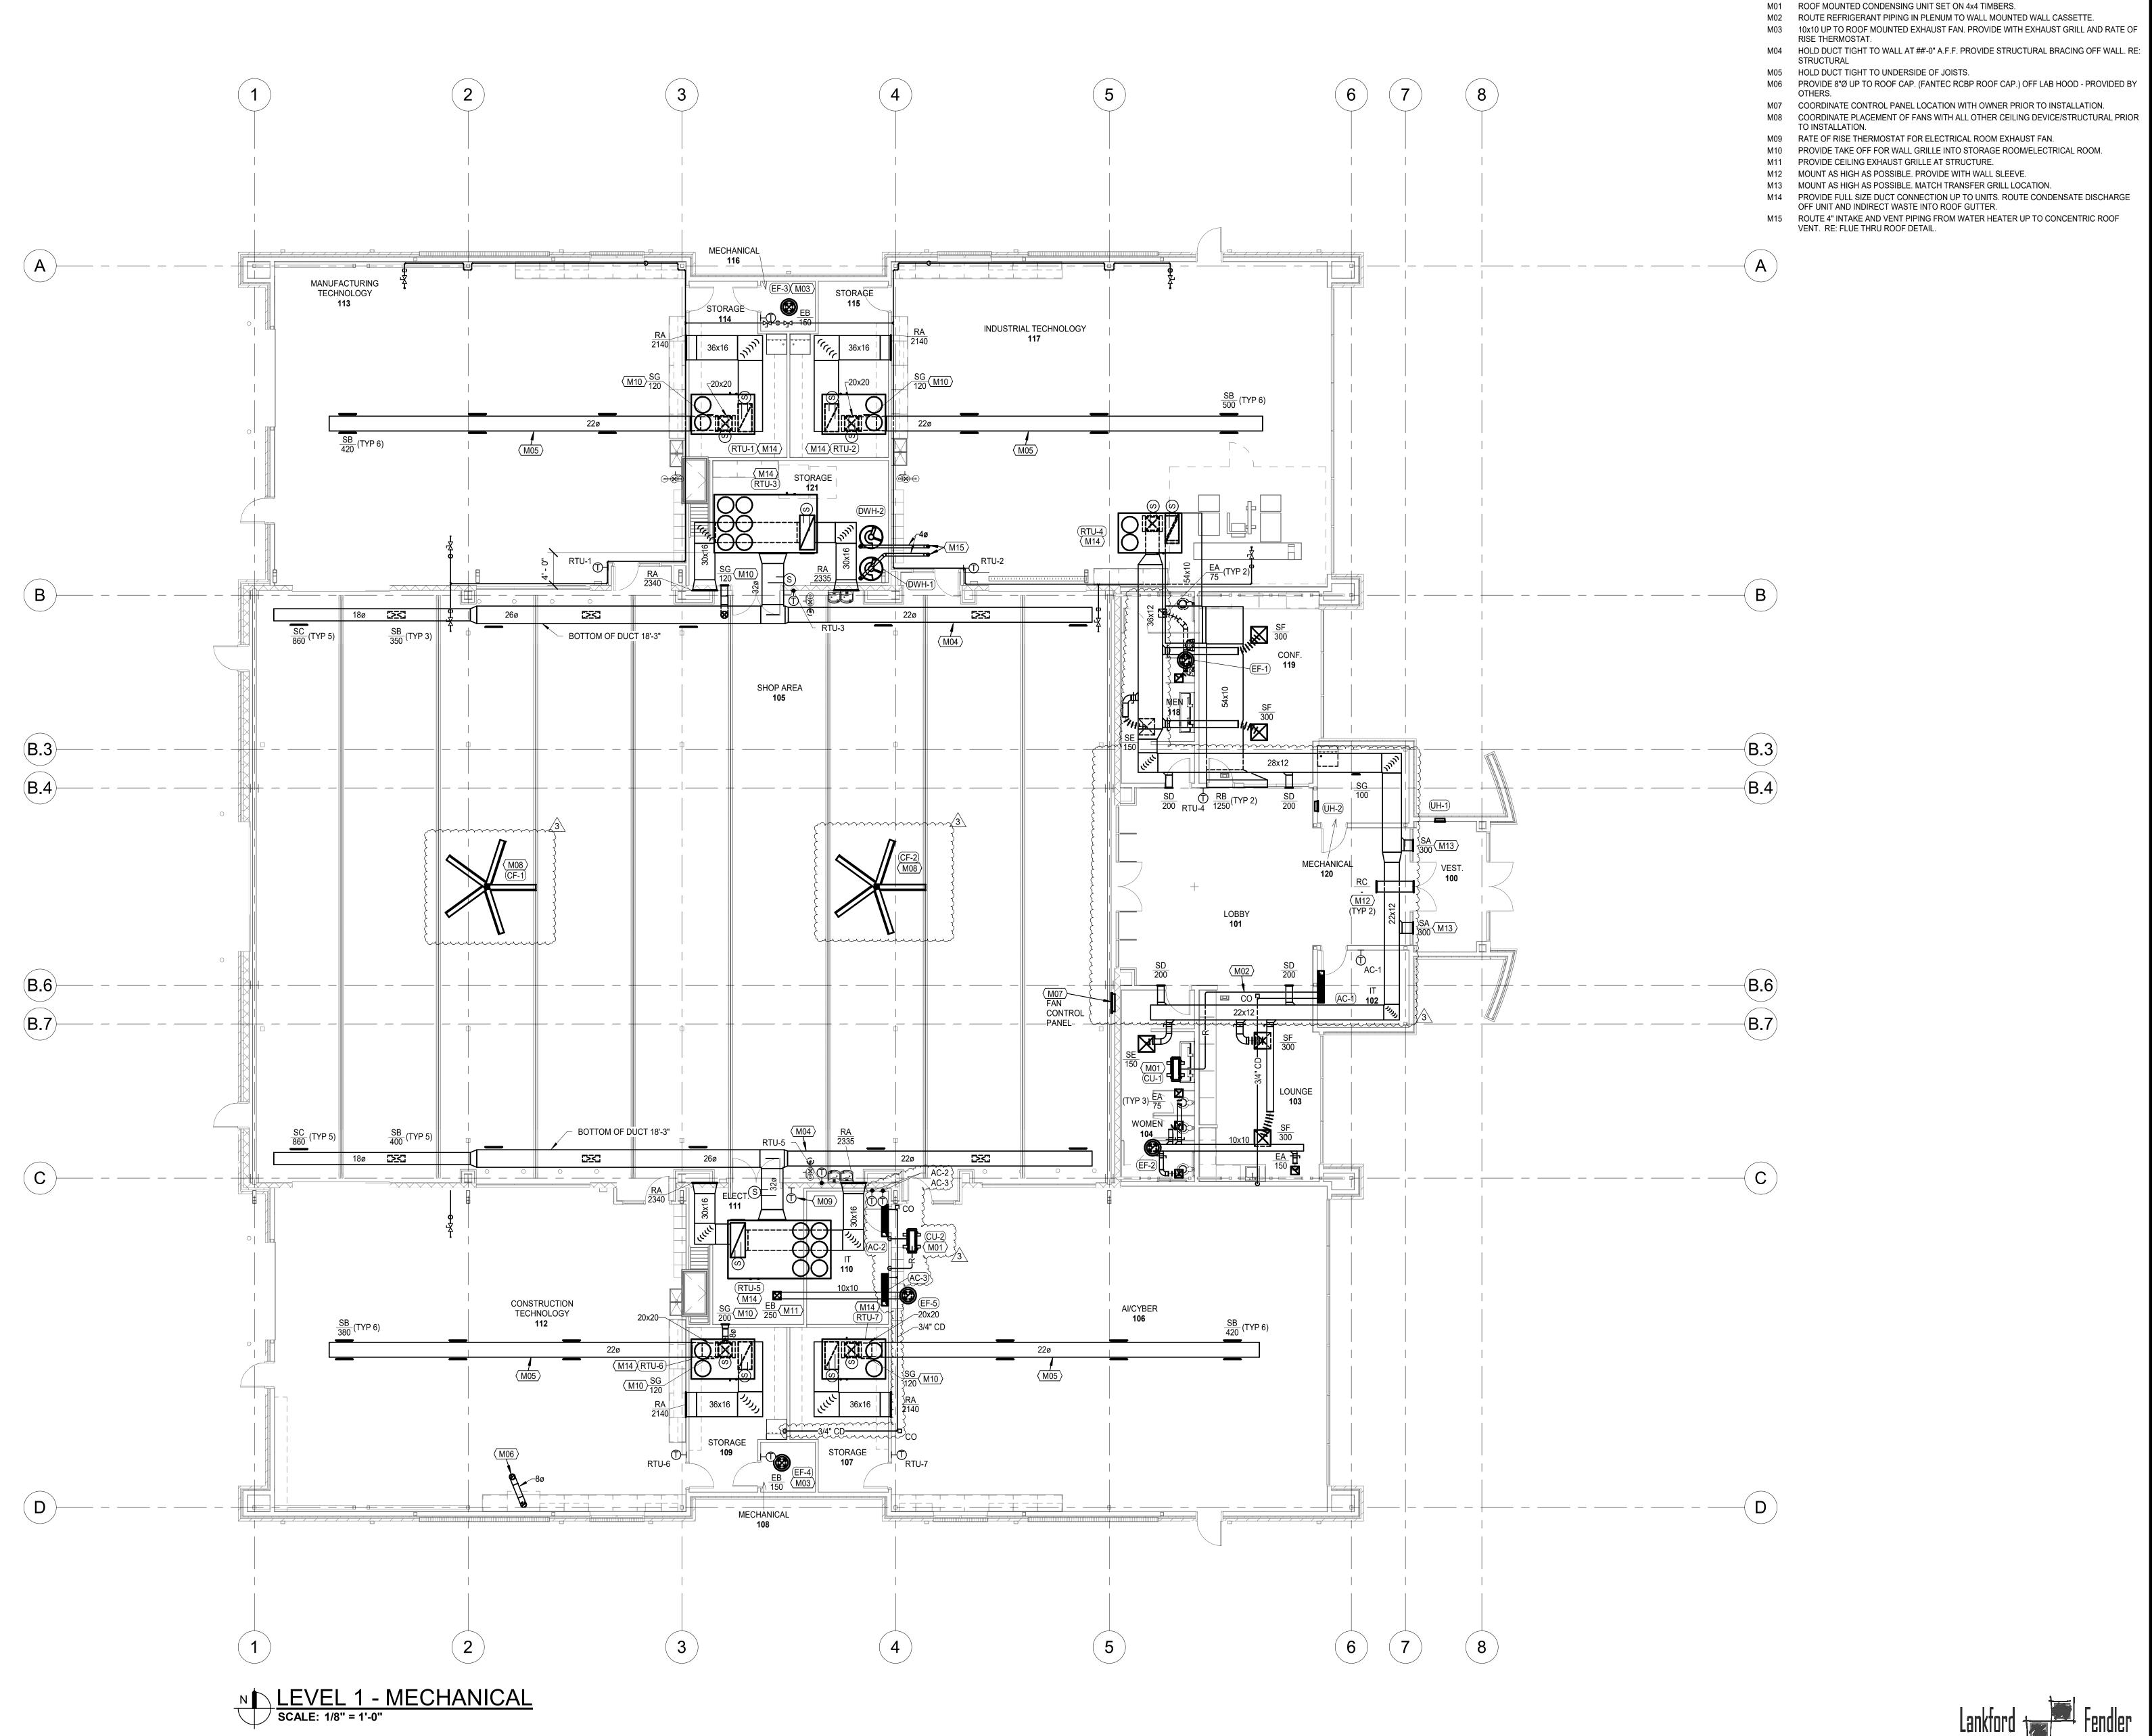



FLOOR PLAN NOTES



ARCHITECTS

924 FRANCIS ST. ST. JOSEPH, MO 64501 P: 816-233-8003 F: 816-233-7793 www.ellison-auxier.com

CONSULTANTS

ADDENDUM #3

LEVEL 1 - MECHANICAL

SHEET:

ROOFTOP UNIT SCHEDULE (OWNER PROVIDED/CONTRACTOR INSTALLED)

					`																			
				MIN	EXT.								COOLING						HEATING-GA	S	EL	ECTRIC.	AL	
MARK	MANUFACTURER	MODEL	AIRFLOW	O.A.	S.P.	FAN	FAN	RPM	AMB.	E.D.B.	E.W.B.	L.D.B.	L.W.B.	TOTAL	SENS.			INPUT	OUTPUT					NOTES
NO.			CFM	CFM	(IN W.G.)	HP	TYPE		(°F)	(°F)	(°F)	(°F)	(°F)	MBH	MBH	STAGES	IEER	MBH	MBH	STAGES	VOLT	Ø	HZ	
RTU-1	DAIKIN	MPS-SH07D	2640	500	0.75	3	FC	918	100	77	65	54.8	54.1	85.3	63	2	14.6	150	121.5	2	480	60	3	1,2,3,4,5,6,7,9,10
RTU-2	DAIKIN	MPS-SH07D	2640	500	0.75	3	FC	918	100	77	65	54.8	54.1	85.3	63	2	14.6	150	121.5	2	480	60	3	1,2,3,4,5,6,7,9,10
RTU-3	DAIKIN	MPS-015B	5500	825	0.75	5 (2 total)	FC	791	100	77	65	54.9	54.4	174	131	2	14.8	350	284	2	480	60	3	1,2,3,4,5,6,8,9,10
RTU-4	DAIKIN	MPS-SH07D	3000	600	0.75	3	FC	918	100	77	65	54.8	54.1	85.3	63	2	14.6	150	121.5	2	480	60	3	1,2,3,4,5,6,7,9,10
RTU-5	DAIKIN	MPS-015B	5500	825	0.75	5 (2 total)	FC	791	100	77	65	54.9	54.4	174	131	2	14.8	350	284	2	480	60	3	1,2,3,4,5,6,8,9,10
RTU-6	DAIKIN	MPS-SH07D	2640	500	0.75	3	FC	918	100	77	65	54.8	54.1	85.3	63	2	14.6	150	121.5	2	480	60	3	1,2,3,4,5,6,7,9,10
RTU-7	DAIKIN	MPS-SH07D	2640	500	0.75	3	FC	918	100	77	65	54.8	54.1	85.3	63	2	14.6	150	121.5	2	480	60	3	1,2,3,4,5,6,7,9,10

NOTES: 1. PROVIDE WITH DDC CONTROLS, COTTONWOOD FILTERS SUCH AS AIR SOLUTION COMPANY MEDIUM DUTY COMMERCIAL GRADE FILTERS, HINGED ACCESS PANELS, DISCONNECT SWITCH, CONDENSATE DRAIN TRAP, AND DRAIN PAN OVERFLOW SWITCH

TO SHUT DOWN UNIT IF DRAIN BECOMES CLOGGED.

2. PROVIDE WITH 2" MERV 13 FILTERS.

3. PROVIDE WITH ECONOMIZER WITH DIFFERNTIAL ENTHALPY CONTROL AND BAROMETRIC RELIEF.

4. PROVIDE WITH UNIT MOUNTED GFCI OUTLET WITH WEATHERPROOF COVER. OUTLET TO BE FIELD POWERED/WIRED FROM BUILDING POWER 5. PROVIDE WITH CURB OF HEIGHT REQUIRED TO HAVE THE TOP OF THE CURB A MINIMUM OF 8" ABOVE THE TOP OF THE ROOF SURFACE.

6. PROVIDE WITH HOT GAS REHEAT COIL SECTION

7. UNIT TO BE CONFIGURED FOR DOWNFLOW DISCHARGE AND RETURN.

8. UNIT TO BE CONFIGURED FOR HORIZONTAL SUPPLY DISCHARGE WITH BOTTOM RETURN.

9. PROVIDE WITH 2 SPEED SAF CONTROL

10. PROVIDE WITH HOT GAS REHEAT COIL SECTION

DIFFUSER SCHEDULE

MARK	MANUFACTURER	MODEL	SIZE (IN.)	SIZE (IN.)	FRAME TYPE*	FINISH	NOTES
SA	PRICE	520D	18x8	16x6	SURFACE	PRIME COAT	
SB	PRICE	620D	26x10	24x8	DUCT	MILL	1
SC	PRICE	620D	26x14	24x12	DUCT	MILL	1
SD	PRICE	520D	12x12	10x10	SURFACE	PRIME COAT	
SE	PRICE	SPD	24x24	8"	LAY-IN	WHITE	
SF	PRICE	SPD	24x24	10"	LAY-IN	WHITE	
SG	PRICE	520D	12x8	10x6	SURFACE	PRIME COAT	1
RA	PRICE	510ZD	38x26	36x24	SURFACE	PRIME COAT	2
RB	PRICE	510ZD	46x12	44x10	SURFACE	PRIME COAT	2
RC	PRICE	530	18X8	16x6	SURFACE	PRIME COAT	
EA	PRICE	PDDR	12x12	8"	SURFACE	WHITE	
EB	PRICE	PDDR	12x12	10x10	SURFACE	MILL	

NOTES: 1. PROVIDE WITH OPPOSED BLADE DAMPER, SPIRAL DUCT FRAME, FRONT BLADES PARALLEL TO LONG DIMENSION,
COUNTERSUNK SCREW HOLES

2. PROVIDE WITH OPPOSED BLADE DAMPER EPONT BLADES PARALLEL TO LONG DIMENSION, COUNTERSLINK SCREW

 PROVIDE WITH OPPOSED BLADE DAMPER FRONT BLADES PARALLEL TO LONG DIMENSION, COUNTERSUNK SCREW HOLES

*CONTRACTOR SHALL VERIFY CEILING TYPE PRIOR TO ORDERING DIFFUSERS.

VENTUATION SCHEDULE

					VENTILATIO	N	
UNIT	SPACE	AREA (S.F.)	PEOPLE/ 1000 S.F.	CFM/ PERSON	CFM/ S.F.	REQUIRED CFM	TOTAL OA CFM
RTU-1	CLASSROOM	1993	35	10	0.12	479*	500
	STORAGE	237	-	-	0.06	14	
RTU-2	CLASSROOM	1993	35	10	0.12	479*	500
	STORAGE	237	-	-	0.06	14	
RTU-3	SHOP AREA	3905	35	10	0.12	819*	825
RTU-4	CONF.	343	50	5	0.06	81*	275
	LOBBY	744	30	7.5	0.06	90*	
	VEST.	139	-	-	0.06	8	
	LOUNGE	352	30	7.5	0.06	96*	
RTU-5	SHOP AREA	3905	35	10	0.12	819*	825
RTU-6	CLASSROOM	1993	35	10	0.12	479*	500
	STORAGE	237	-	-	0.06	14	
RTU-7	CLASSROOM	1993	35	10	0.12	479*	500
	STORAGE	237	-	-	0.06	14	

\...../

CIRCULATION FAN SCHEDULE

											ELECTRICAL	-		
MARK	MANUFACTURER	MODEL	DIAMETER	# OF	AIRFLOW	SOUND	RPM	DRIVE	COLOR				HP/WATTS	NOTES
NO.			FT.	AIRFOILS	(CFM)	LEVEL (DBA)				VOLT	ø	HZ		
CF-1	GREENHECK	DC-5-12-13LV		5	44,605	45	92 }	DIRECT	MILL	115	1	60	206W	1
CF-2	GREENHECK	DC-5-12-13LV	12	5	44,605	45	92	DIRECT	MILL	115	1	60	206W	1
								<u>B\</u>					1	3
NOTES:	1. PROVIDE WITH STRUC	TURAL DELIGATE	D DESIGN MO	DUNTING BRA	ACKET WITH	FIELD VERIFIED	EXTENSION	RODS, ALUN	MINUM BLADE	S, STANDAR	D TOUCHSCI	RREEN CONT	ROL.	

CONDENSING UNIT SCHEDULE

				HEATING		SAT.			El	_ECTRIC <i>A</i>	\L	
MARK NO.	MANUFACTURER	MODEL	COOLING (MBH)	AT 5°F (MBH)	AMB. (°F)	SUCTION TEMP (°F)	STAGES	SEER	VOLT	ø	HZ	NOTES
CU-1	MITSUBISHI	PUZ-A18NKA7	18.0	19.0	105	45	1	18.5	208	1	60	1
CU-2	DAIKIN	4MXL36TVJU	36.0	21.6	95	45	1	16.9	208	1	60	1
NOTES:		 JNTING PAD, COMPRES CONTROL. PROVIDE W			COMPRES	 SOR TIME-OFF CO	NTROL, AND	COTTON W	OOD FILT	ER / HAIL	GUARD.	

FAN SCHEDULE

								EI	LECTRICA	AL		
MARK NO.	MANUFACTURER	MODEL	TYPE	AIRFLOW (CFM)	S.P. (IN W.G.)	RPM	DRIVE	VOLT	ø	HZ	HP/ WATTS	NO.
EF-1	GREENHECK	G070	DONWBLAST	150	0.25	1300	DIRECT	120	1	60	1/60	
EF-2	GREENHECK	G090	DONWBLAST	375	0.25	1300	DIRECT	120	1	60	1/25	
EF-3	GREENHECK	G070	DONWBLAST	150	0.25	1300	DIRECT	120	1	60	1/60	1
EF-4	GREENHECK	G070	DONWBLAST	150	0.25	1300	DIRECT	120	1	60	1/60	1
EF-5	GREENHECK	G070	DONWBLAST	250	0.25	1300	DIRECT	120	1	60	1/60	1

S: 1. PROVIDE WITH 14" ROOF CURB, DISCONNECT SWITCH, SPEED CONTROLLER
BIRD SCREEN, AND DAMPER.

2. PROVIDE WITH RATE OF RISE THERMOSTAT (SET AT 80f) FANTECH FAT10 ATTIC THERMOSTAT 120V

AIR CONDITIONING UNIT SCHEDULE

								E	LECTRICA	AL	
	MARK	MANUFACTURER	MODEL	ARRANGEMENT	AIRFLOW	COOLING	HEATING				NOTES
	NO.				CFM	MBH	MBH	VOLT	ø	HZ	
,	AC-1	,,,, MITSUBISHI,,,,,	PKA-A18HA7	WALL MOUNTED.	425	18,,	19	208	~1~	60	1
. {	AC-2	DAIKIN	FTXS18LVJU	WALL MOUNTED	580	18	21.6	208	1	60	1
3√	AC-3	DAIKIN	FTXS18LVJU	WALL MOUNTED	580	18	21.6	208	1	60	1
1						muuu	······	······	munu		

NOTES: 1 PROVIDE WITH DDC CONTROL INTERFACE, REMOTE SENSOR, AND DISCONNECT SWITCH.

UNIT HEATER SCHEDULE

					HEATING	(ELEC.)	EL	_ECTRIC/	AL				
MARK NO.	MANUFACTURER	MODEL	TYPE	AIRFLOW (CFM)	OUTPUT (MBH)	INPUT (KW*)	VOLT	ø	HZ	NOTES			
UH-1	BERKO	FRC1512F	WALL	100	5.1	1.5	120	1	60	1			
UH-2	BERKO	FRC1512F	WALL	100	5.1	1.5	120	1	60	1			
NOTES:	S: 1. PROVIDE WITH INTEGRAL THERMOSTAT, 14 GAUGE SECURITY FRONT COVER AND SURFACE MOUNTING												
	FRAME FOR SURFA	CE-MOUNT INST	ALLATION. CC	ORDINATE F	INISH WITH A	RCHITECT.							

FRAME FOR SURFACE-MOUNT INSTALLATION. COORDINATE FINISH WITH ARCHITECT.

2. ADD ALTERNATE BID

*HEATING KW IS NET CAPACITY AT VOLTAGE AND PHASE INDICATED.

GENERAL NOTES (TYPICAL ALL SHEETS)

- A. MECHANICAL CONTRACTOR IS RESPONSIBLE TO SEE THAT WORK MEETS AND IS IN ACCORDANCE WITH ALL REQUIREMENTS OF FEDERAL, STATE, AND LOCAL LAWS AND CODES AND/OR REQUIREMENTS, INCLUDING HEALTH CODES AND BUILDING OWNER.
- B. COORDINATE ALL WORK WITH OTHER TRADES PRIOR TO INSTALLATION TO AVOID ROUTING CONFLICTS
- CONFLICTS.

 C. MECHANICAL CONTRACTOR SHALL AIR BALANCE ALL GRILLES TO CFM'S SHOWN ON PLAN.
- D. INSTALL ELASTOMERIC JOINT SEALER AROUND ALL DUCTS, PIPES, ETC. PASSING THRU INTERIOR NON-RATED CONCRETE AND MASONRY WALLS, GYPSUM-BOARD PARTITIONS, AND CONCRETE FLOOR/ROOF SLABS. FOR FIRE RATED INTERIOR CONCRETE AND MASONRY WALLS, GYPSUM-BOARD PARTITIONS, AND CONCRETE FLOOR/ROOF SLABS SEAL ALL DUCTS, PIPES, ETC. INSTALL FIRESTOP MATERIALS IN ALL GAPS PRIOR TO SEALANT APPLICATION. INSTALL SEALER ACCORDING TO MANUFACTURER'S WRITTEN INSTRUCTIONS.
- E. ALL CABLE TIES FOR LOW VOLTAGE SYSTEMS LOCATED IN PLENUMS UTILIZED FOR AIR MOVEMENT THAT ARE NOT INSTALLED IN CONDUIT SHALL BE 25/50 FLAME AND SMOKE RATED, HELLERMANN TYTON T50R2C2UL OR EQUIVALENT.

MECHANICAL SYMBOLS

	MOAL OT MIDOLO
+	NEW DUCTWORK
 	FLEX DUCT
\boxtimes	SUPPLY DUCT
	RETURN DUCT
	EXHAUST DUCT
\boxtimes	SUPPLY DIFFUSER
	RETURN GRILLE
\square	EXHAUST GRILLE
† D R/D †	RISE OR DROP IN DUCT
	SUPPLY DUCT DOWN
	SUPPLY DUCT UP
	RETURN DUCT DOWN
	RETURN DUCT UP
<u> </u>	EXHAUST DUCT DOWN
<u> </u>	EXHAUST DUCT UP
_	WALL MOUNTED DIFFUSER/GRILLE
$\widehat{\mathbb{T}}$	MANUAL VOLUME DAMPER THERMOSTAT

CONDENSATE DRAIN

EQUIPMENT TYPE AND DESIGNATION

DIFFUSER OR GRILLE TYPE MARK AND CFM

TYPE MARK: (S) SUPPLY, (R) RETURN, (E) EXHAUST

6-24224 POFESSIONALITITION OF 23 05.23.2023



924 FRANCIS ST. ST. JOSEPH, MO 64501 P: 816-233-8003 F: 816-233-7793 www.ellison-auxier.com

NO. REVISION DESCRIPTION

ADDENDUM #3

MISSOURI WESTERN UNIVERSITY FB24-001 CTAC BUILDING 4525 DOWNS DRIVE

ECHANICAL SCHEDULES, ENERAL NOTES, & YMBOLS CHEET:

+ associates

1730 Walnut Street
Kansas City, Missouri 64108

COPYRIGHT © 2023 LANKFORD| FENDLER+ ASSOCIATES, INC.

L|F+a Project No. 22.7184.00

P03 EXTEND NEW WASTE PIPE 5'-0" OUTSIDE THE BUILDING. COORDINATE WITH CIVIL CONTRACTOR ON EXACT LOCATION AND DEPTH PRIOR TO CONSTRUCTION.





924 FRANCIS ST. ST. JOSEPH, MO 64501 P: 816-233-8003 F: 816-233-7793 www.ellison-auxier.com

NO. ISSUE DESCRIPTION DATE

3 ADDENDUM #3 05.23.2023

NO. REVISION DESCRIPTION DATE

NO. REVISION DESCRIPTION DA

ISSOURI WESTERN STATE
NIVERSITY
25 DOWNS DRIVE
USEPH, MO 64507

LEVEL 1 - WASTE/VENT

Lankford Fender

+ associates


1730 Walnut Street
Kansas City, Missouri 64108 Fax: 816.221.1411
Kansas City, Missouri 64108 Fax: 816.221.1429


COPYRIGHT © 2023 LANKFORD [FENDLER+ ASSOCIATES, INC.

L | F+a Project No. 22.7184.00

SHEET:

PATE: 05.01.2023

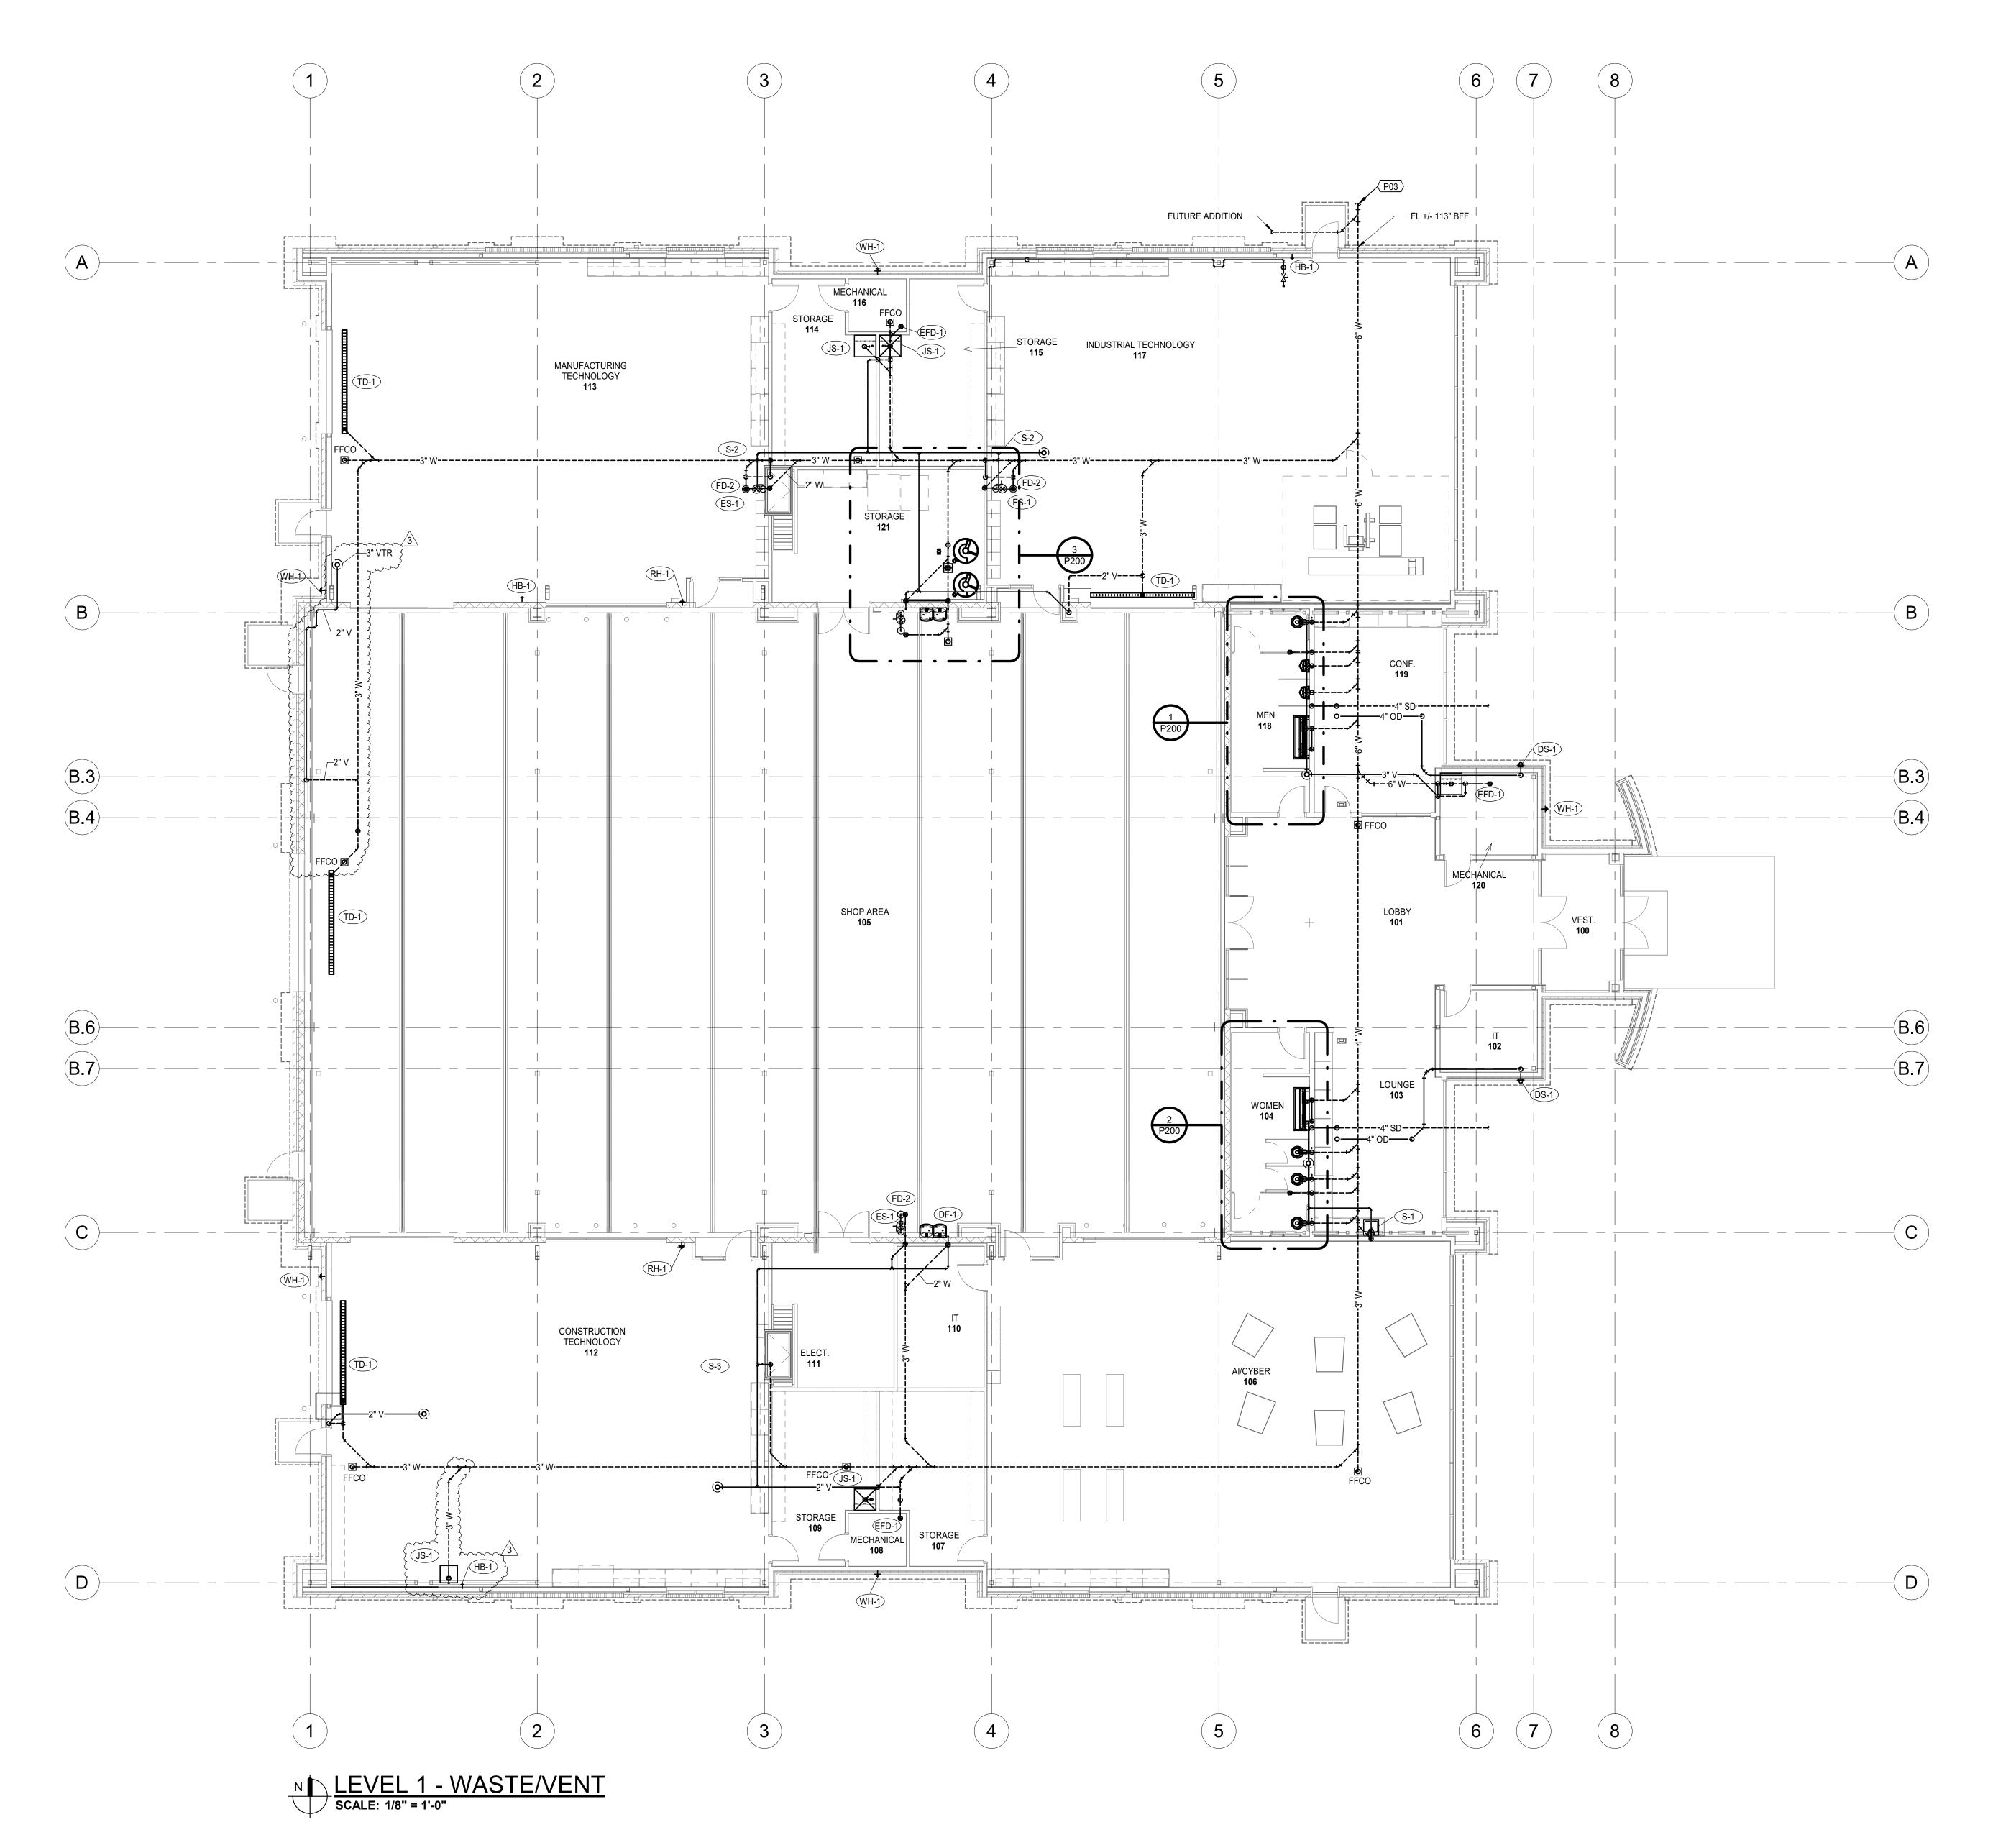

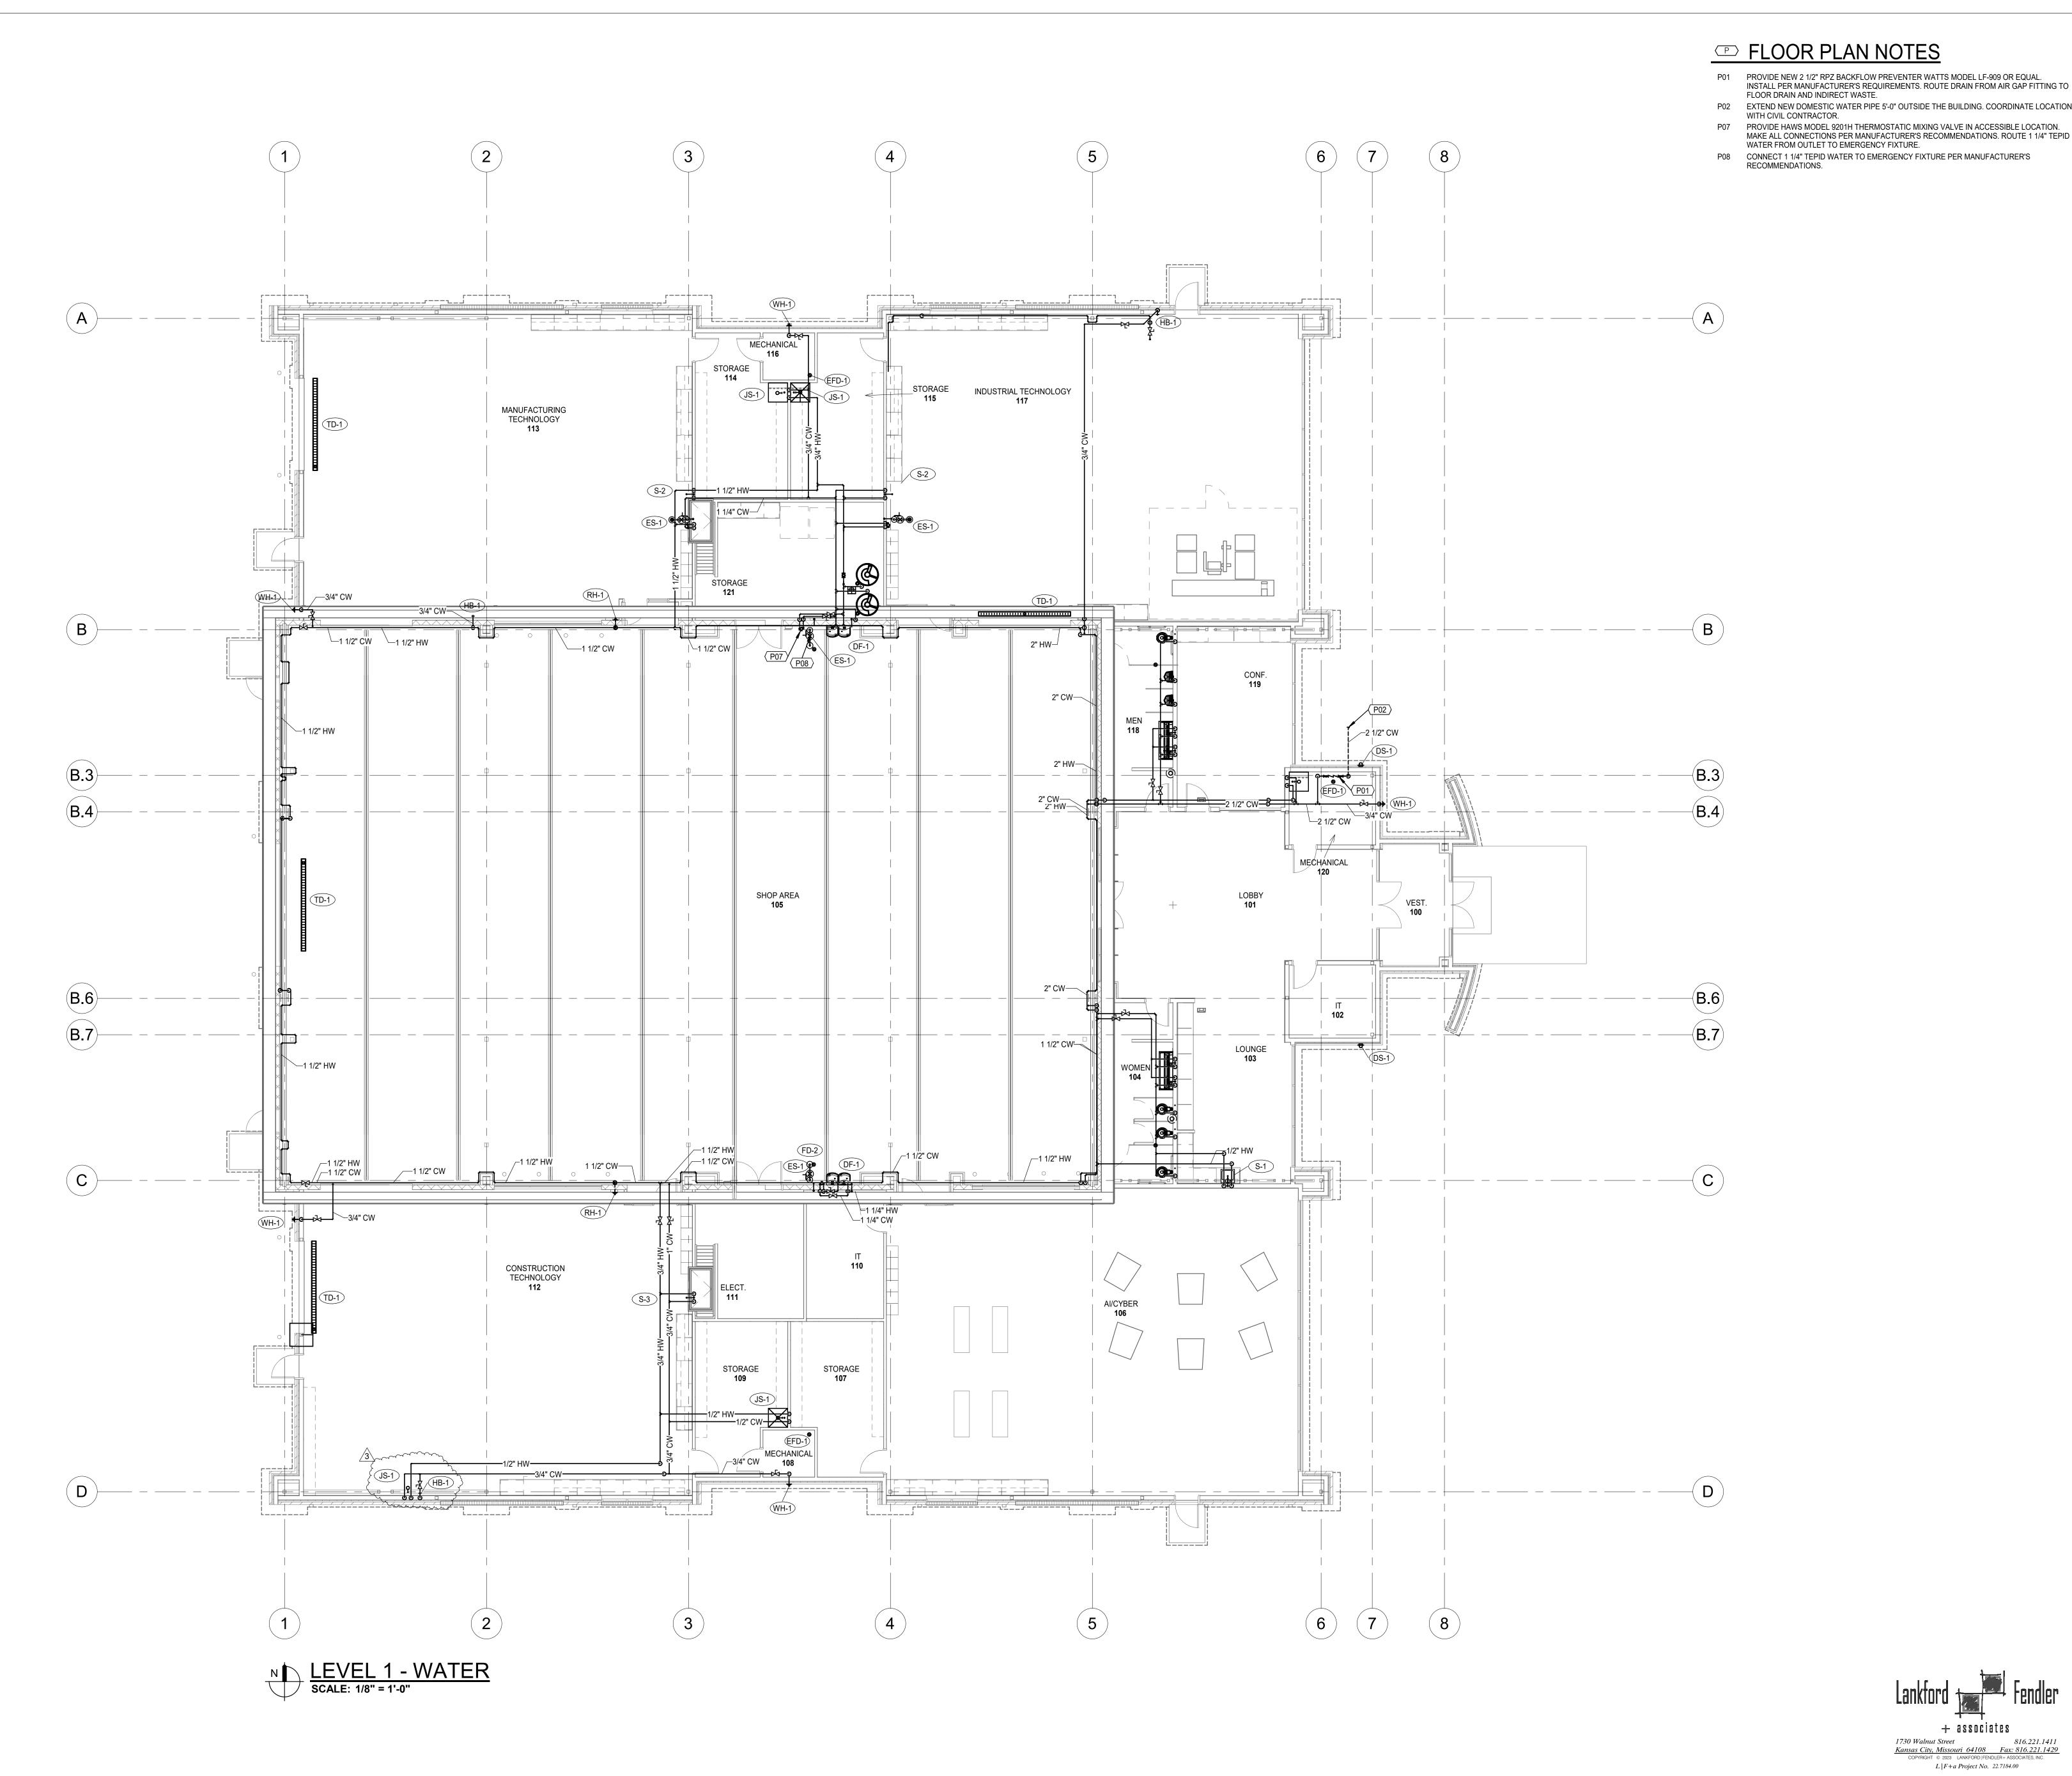





924 FRANCIS ST. ST. JOSEPH, MO 64501 P: 816-233-8003 F: 816-233-7793 www.ellison-auxier.com


NO. ISSUE DESCRIPTION DATE
3 ADDENDUM #3 05.23.2023

NO. REVISION DESCRIPTION DATE

OJECT:
ISSOURI WESTERN STATE
NIVERSITY
S24-001 CTAC BUILDING
25 DOWNS DRIVE
T. JOSEPH, MO 64507

LEVEL 1 - WATER



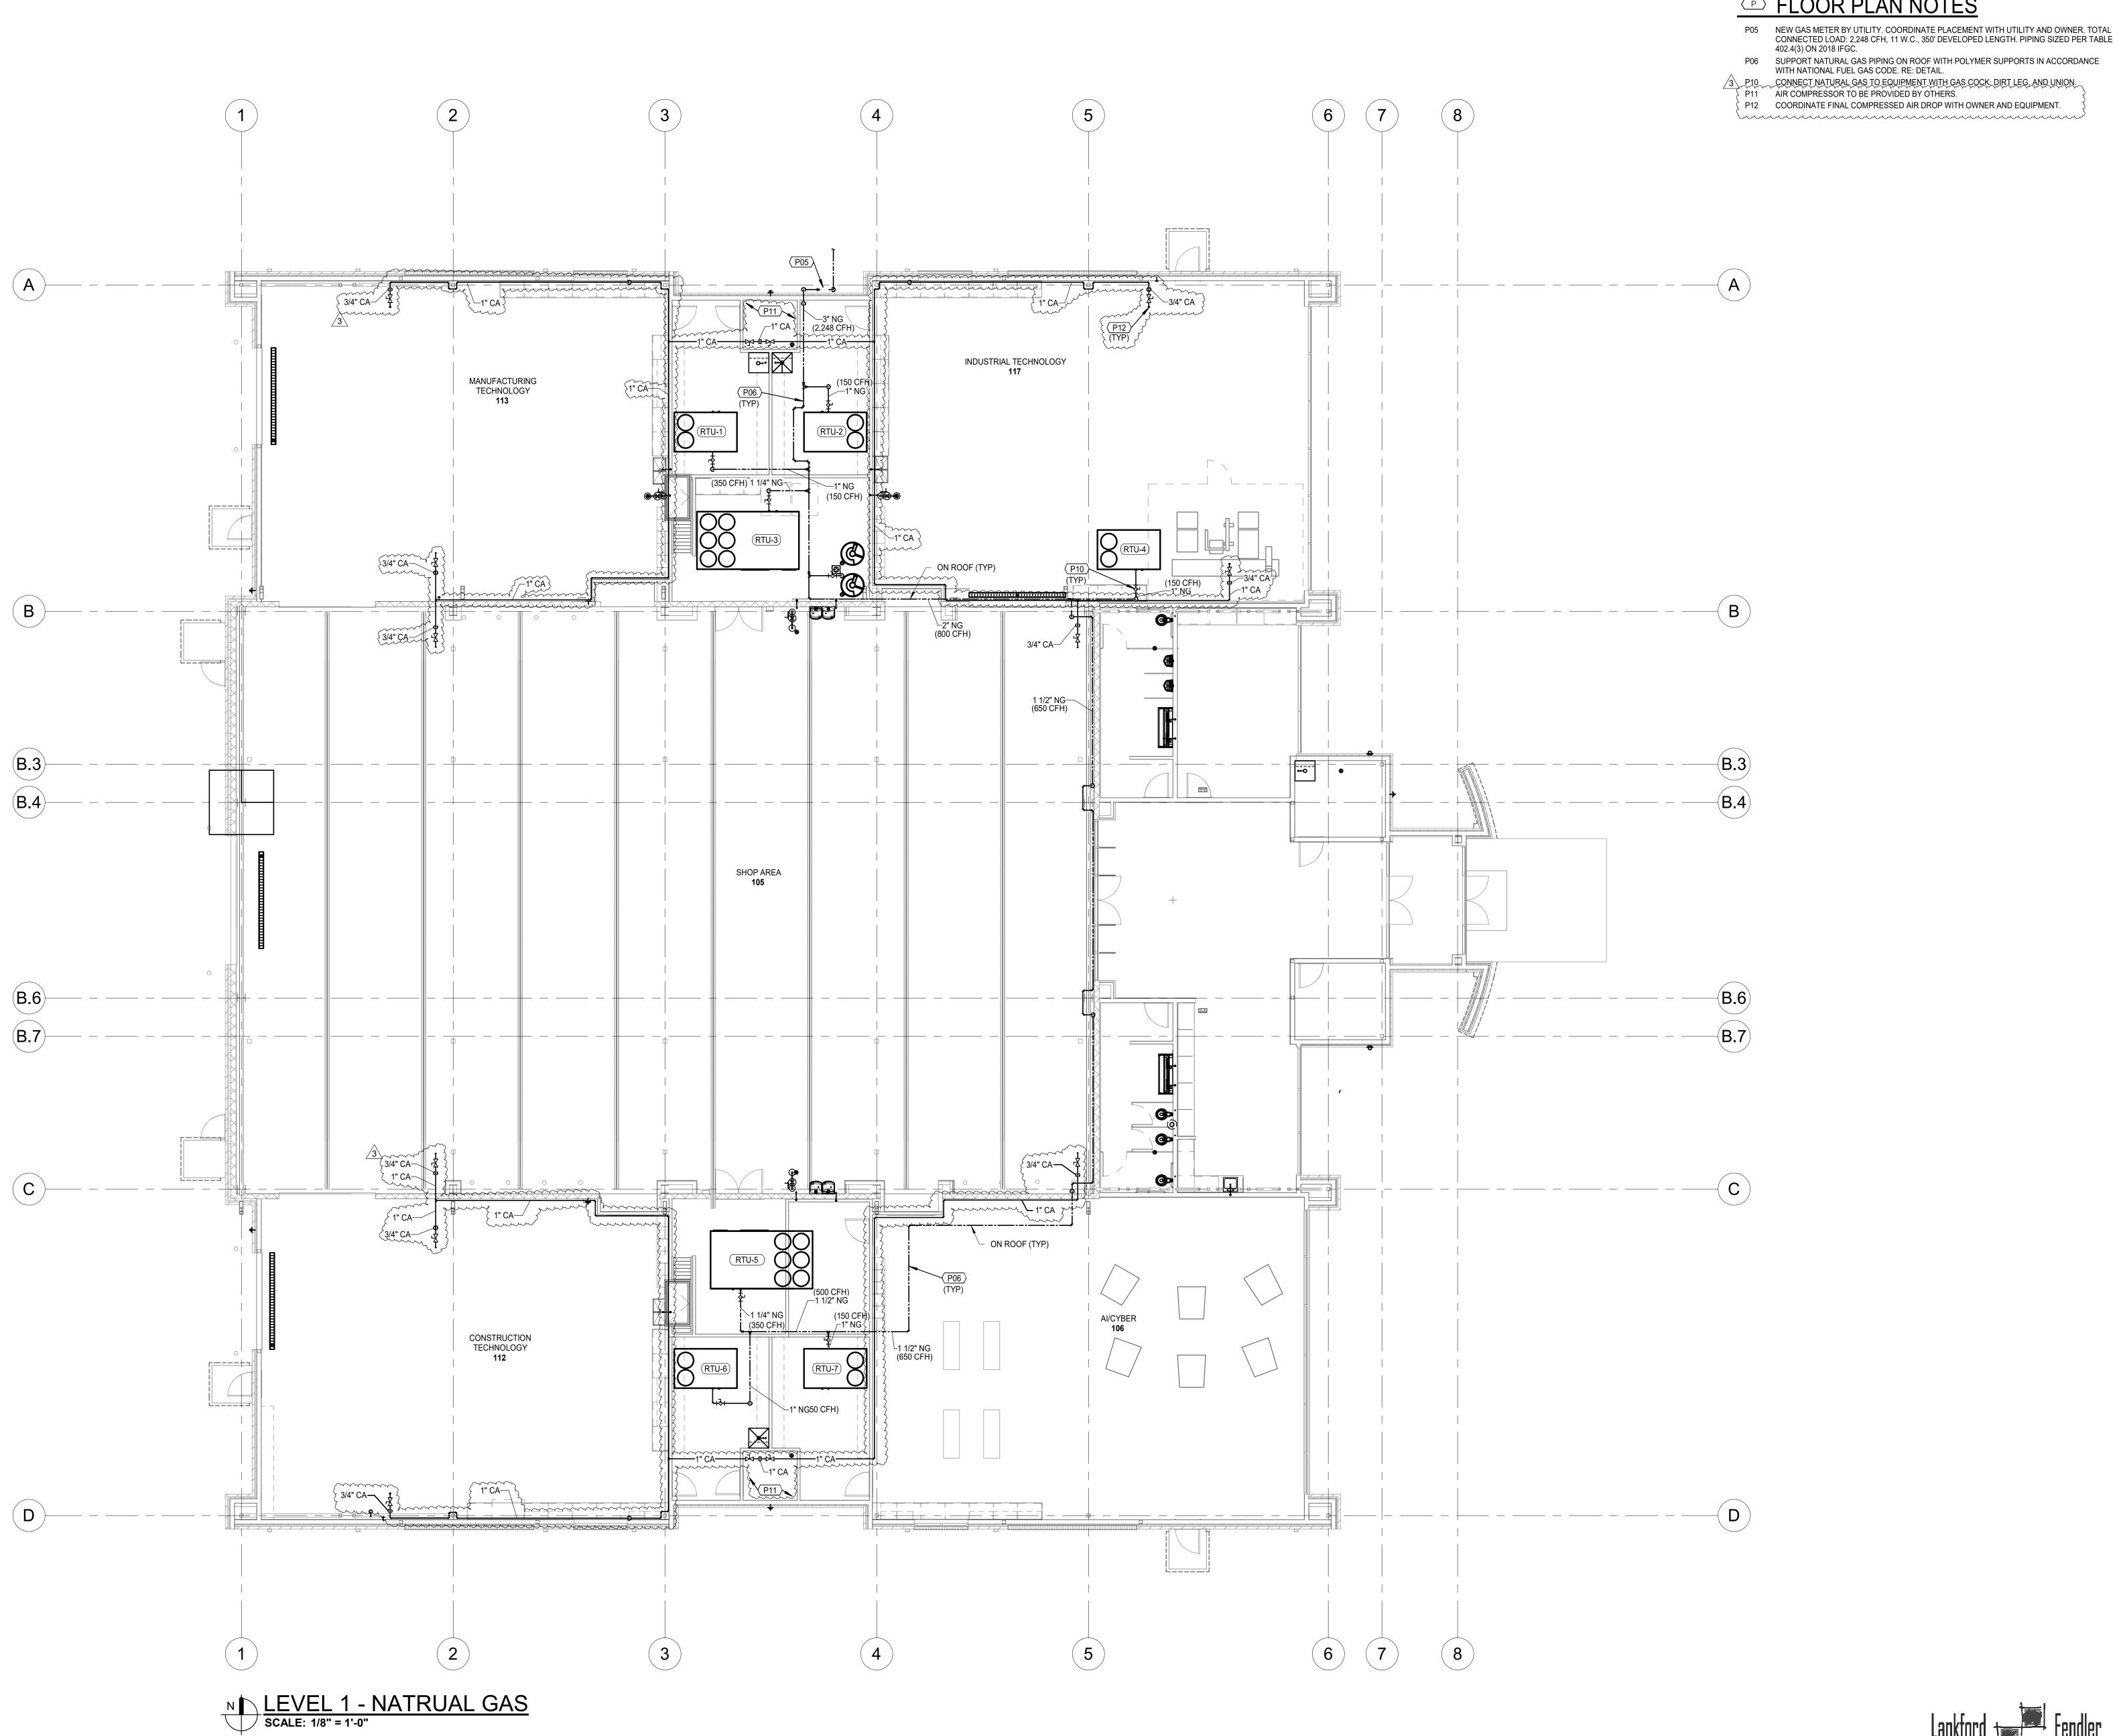



P06 SUPPORT NATURAL GAS PIPING ON ROOF WITH POLYMER SUPPORTS IN ACCORDANCE WITH NATIONAL FUEL GAS CODE. RE: DETAIL.

P12 COORDINATE FINAL COMPRESSED AIR DROP WITH OWNER AND EQUIPMENT.



LANKFORD




ARCHITECTS

924 FRANCIS ST. ST. JOSEPH, MO 64501 P: 816-233-8003 F: 816-233-7793 www.ellison-auxier.com

CONSULTANTS

3 ADDENDUM #3

LEVEL 1 - NATRUAL GAS

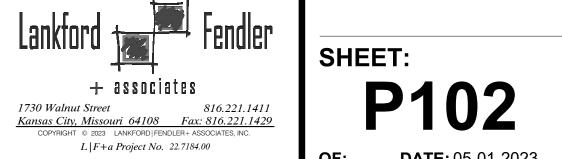

MARK NO.	FIXTURE TYPE	MANUFACTURER	MODEL NO.	DESCRIPTION	cw	HW	WASTE	VENT
WC-1	WATER CLOSET (ADA)	AMERICAN-STANDARD	3043.001 "MADERA"	FLOOR MOUNTED FLUSH VALVE, WHITE VITREOUS CHINA, HIGH EFFICIENCY, DIRECT FED SIPHON JET ACTION, FULLY GLAZED 2" TRAP WAY, ELONGATED BOWL, WITH 1-1/2" TOP SPUD, 16-1/2" RIM HEIGHT. SLOAN "OPTIMA" 8111-1.28 (1.28 GPF) BATTERY OPERATED ELECTRONIC DIAPHRAGM FLUSH VALVE WITH MANUAL RELEASE, VACUUM BREAKER AND ANGLE STOP. ACCESSORIES: CHURCH 9500SSCT WHITE OPEN FRONT SEAT LESS COVER WITH SELF SUSTAINING CHECK HINGES, BOLTS AND CAPS. NOTE: MOUNT FLUSH VALVE TO WIDE SIDE OF FIXTURE.	1"	- -	4"	2"
WC-2	WATER CLOSET	AMERICAN-STANDARD	2234.001 "MADERA"	FLOOR MOUNTED FLUSH VALVE, WHITE VITREOUS CHINA, HIGH EFFICIENCY, DIRECT FED SIPHON JET ACTION, FULLY GLAZED 2" TRAP WAY, ELONGATED BOWL, WITH 1-1/2" TOP SPUD. 15" RIM HEIGHT. SLOAN "OPTIMA" 8111-1.28 (1.28 GPF) BATTERY OPERATED ELECTRONIC DIAPHRAGM FLUSH VALVE WITH MANUAL RELEASE, VACUUM BREAKER AND ANGLE STOP. ACCESSORIES: CHURCH 9500SSCT WHITE OPEN FRONT SEAT LESS COVER WITH SELF SUSTAINING CHECK HINGES, BOLTS AND CAPS.	1"	-	4"	2"
U-1	URINAL (ADA)	AMERICAN-STANDARD	6590.001 "WASHBROOK"	WHITE VITREOUS CHINA, WALL-HUNG, HIGH EFFICIENCY WASHOUT FLUSH ACTION, INTEGRAL FLUSHING RIM, 3/4" TOP SPUD, 2" OUTLET. SLOAN "OPTIMA PLUS" 8186-0.5 (0.5 GPF) BATTERY OPERATED ELECTRONIC FLUSH VALVE WITH MANUAL RELEASE, VACUUM BREAKER AND ANGLE STOP. ACCESSORIES: J. R. SMITH URINAL SUPPORT. NOTE: MOUNT FIXTURE RIM 17" ABOVE FINISHED FLOOR.	3/4"	-	2"	1-1/2"
U-2	URINAL	AMERICAN-STANDARD	6590.001 "WASHBROOK"	WHITE VITREOUS CHINA, WALL-HUNG, HIGH EFFICIENCY WASHOUT FLUSH ACTION, INTEGRAL FLUSHING RIM, 3/4" TOP SPUD, 2" OUTLET. SLOAN "OPTIMA PLUS" 8186-0.5 (0.5 GPF) BATTERY OPERATED ELECTRONIC FLUSH VALVE WITH MANUAL RELEASE, VACUUM BREAKER AND ANGLE STOP. ACCESSORIES: J. R. SMITH URINAL SUPPORT. NOTE: MOUNT FIXTURE RIM 24" ABOVE FINISHED FLOOR.	3/4"	-	2"	1-1/2"
L-1	LAVATORY (ADA)	BRADLEY	LD-5010	WALL HUNG TWO STATION BRADLEY OMNIDECK WITH WASHBAR. WB1 CHROME-PLATED WASHBAR FAUCET WITH INFRARED CONTROL. ACCESSORIES: PROVIDE LEONARD 170-LF LEAD FREE BRONZE THERMOSTATIC MIXING VALVE WITH 0.25 GPM MINIMUM FLOW RATE, INTEGRAL CHECK VALVES, DISCHARGE SET AT 105 F, MOUNTED DOWNSTREAM OF FIXTURE STOPS, WITH HOT AND COLD WATER PIPED TO VALVE, TEMPERED AND COLD WATER TO LAVATORY. CHICAGO FAUCETS MODEL 327-XCP GRID DRAIN, 1-1/4" X 1-1/2" 17 GA. SEMI-CAST BRASS P-TRAP WITH CLEANOUT AND CHROME-PLATED RISERS WITH LOOSE KEY ANGLE STOPS. PROVIDE WITH FULLY MOLDED FLEXIBLE VINYL INSULATION KIT TO COVER TRAP, SUPPLIES AND STOPS, TRUBRO E-Z LAV GUARD.	1/2"	1/2"	1-1/2"	1-1/2"
S-1	SINK (ADA)	ELKAY	LRAD-1918	SINGLE COMPARTMENT SELF RIMMING SINK, 18 GA, TYPE 304 STAINLESS STEEL, 6-1/2" DEEP BOWL. CHICAGO FAUCETS MODEL 786-GR2E35V317XKAB DECK MOUNTED FAUCET WITH CERAMIC OPERATING CARTRIDGE, 4" WRIST BLADE HANDLES, 5-1/4" RESTRICTED SWING GOOSENECK SPOUT WITH VANDAL RESISTANT 1.5 GPM AERATOR. ACCESSORIES: ELKAY LK-35 STRAINER WITH 1-1/2" TAILPIECE, 1-1/2" 17 GA. SEMI-CAST BRASS P-TRAP WITH CLEANOUT, CHROME-PLATED RISERS WITH LOOSE KEY ANGLE STOPS.	1/2"	1/2"	2"	1-1/2"
S-2	SINK	ELKAY	EWMA4820C	MULTI-STATION WASH SINK WITH 2" FLAT APRON, 14 GA, TYPE 304 STAINLESS STEEL, 9-1/8" DEEP BOWL. ELKAY MODEL LK940GN05T4H SINK/WALL MOUNTED FAUCETS (TWO FAUCETS) WITH 4" WRIST BLADES, 5" SWING HIGH GOOSENECK SPOUT, VANDAL-RESISTANT ANTI-HOSE AERATOR. ACCESSORIES: ELKAY LK18B PERFORATED STRAINER GRID WITH 1-1/2" TAILPIECE, 1-1/2" 17 GA. SEMI-CAST BRASS P-TRAP WITH CLEANOUT, CHROME-PLATED RISERS WITH LOOSE KEY ANGLE STOPS.	1/2"	1/2"	2"	1-1/2'
S-3	SINK	ELKAY	EWMA4820C	MULTI-STATION WASH SINK WITH 2" FLAT APRON, 14 GA, TYPE 304 STAINLESS STEEL, 9-1/8" DEEP BOWL. ELKAY MODEL LK940GNO5T4H SINK/WALL MOUNTED FAUCETS (TWO FAUCETS) WITH 4" WRIST BLADES, 5" SWING HIGH GOOSENECK SPOUT, VANDAL-RESISTANT ANTI-HOSE AERATOR. PROVIDE WITH DECK MOUNTED EYEWASH ON SINK, GUARDIAN MODEL G1100 OR EQUAL. ACCESSORIES: ELKAY LK18B PERFORATED STRAINER GRID WITH 1-1/2" TAILPIECE, 1-1/2" 17 GA. SEMI-CAST BRASS P-TRAP WITH CLEANOUT, CHROME-PLATED RISERS WITH LOOSE KEY ANGLE STOPS.	1/2"	1/2"	2"	1-1/2
JS-1	JANITOR SINK	STERN-WILLIAMS	MTB-2424	SIZE 24" X 24" X 10", TERRAZZO SERVICE SINK WITH CAST BRASS DRAIN, STAINLESS STEEL STRAINER, 3" DRAIN CONNECTION. CHICAGO FAUCETS MODEL 897-CCP WITH QUATURN OPERATING CARTRIDGE, VACUUM BREAKER SPOUT WITH PAIL HOOK AND WALL BRACE, 3/4" MALE HOSE THREAD OUTLET, 369 LEVER HANDLES, FLANGED ADJUSTABLE SUPPLY ARM AND INTEGRAL SUPPLY STOPS AND CHECK VALVES. ACCESSORIES: V-70 EXTRUDED VINYL BUMPER GUARDS ON EXPOSED SIDES, T-35 36" RUBBER HOSE WITH STAINLESS STEEL WALL BRACKET.	1/2"	1/2"	3"	2"
FD-1	FLOOR DRAIN	J.R. SMITH	2005YA-NB	GENERAL PURPOSE, DUCO CAST IRON BODY WITH FLASHING COLLAR, ADJUSTABLE STRAINER HEAD, ROUND NICKEL BRONZE STRAINER, AND SEEPAGE OPENINGS. OUTLET SIZE PER PLANS. PROVIDE WITH SQUARE GRATE WHERE DRAIN IS INSTALLED IN TILE FLOORS. NOTE: PROVIDE WITH TRAP PRIMER CONNECTION WHERE REQUIRED BY LOCAL CODE OR AS INDICATED ON DRAWINGS.	-	-	2"	1-1/2
FD-2	FLOOR DRAIN	J.R. SMITH	2005YA-NB	GENERAL PURPOSE, DUCO CAST IRON BODY WITH FLASHING COLLAR, ADJUSTABLE STRAINER HEAD, ROUND NICKEL BRONZE STRAINER, AND SEEPAGE OPENINGS. OUTLET SIZE PER PLANS. PROVIDE WITH SQUARE GRATE WHERE DRAIN IS INSTALLED IN TILE FLOORS. NOTE: PROVIDE WITH TRAP PRIMER CONNECTION WHERE REQUIRED BY LOCAL CODE OR AS INDICATED ON DRAWINGS.	-	-	3"	2"
EFD-1	EQUIPMENT FLOOR DRAIN	J.R. SMITH	2210Y	MEDIUM CAPACITY, MEDIUM DUTY DUCO CAST IRON BODY, SEDIMENT BUCKET AND GRATE, NO HUB OUTLET. PROVIDE WITH 3591 OVAL FUNNEL WHERE DRAIN RECEIVES INDIRECT WASTE.	-	-	3"	2"
WH-1	WALL HYDRANT	WOODFORD	67	EXPOSED, FREEZELESS WALL HYDRANT, CHROME PLATED BRASS, 3/4" INLET AND HOSE CONNECTION, INTEGRAL ASSE DOUBLE CHECK BACKFLOW PREVENTER, LOOSE KEY, STEM LENGTH AS REQUIRED.	3/4"	-	-	-
RH-1	ROOF HYDRANT	WOODFORD	67	EXPOSED, FREEZELESS WALL HYDRANT, CHROME PLATED BRASS, 3/4" INLET AND HOSE CONNECTION, INTEGRAL ASSE DOUBLE CHECK BACKFLOW PREVENTER, LOOSE KEY, STEM LENGTH AS REQUIRED.	3/4"	-	-	-
HB-1	HOSE BIBB	WOODFORD	26 FAUCET	INTERIOR, CHROME PLATED BRASS, 3/4" INLET AND HOSE CONNECTION, MOUNTING FLANGE, INTEGRAL ASSE DOUBLE CHECK BACKFLOW PREVENTER, METAL WHEEL HANDLE.	3/4"	-	-	-
DF-1	DRINKING FOUNTAIN (ADA)	ELKAY	EZSTL8WS	BI-LEVEL CABINET WITH BOTTLE FILLER, ADA BARRIER-FREE BI-LEVEL COOLER, 8.0 G.P.H. (50° F WATER WITH 90° F AIR TEMPERATURE), PUSH BAR ACTIVATION, STAINLESS STEEL COOLER TOP, HEAVY GAUGE VINYL CLAD STEEL CABINET WITH GREY FINISH, CANE APRON ON UPPER BOWL, ELECTRONIC ACTUATED INTEGRAL BOTTLE FILLER STATION ON LOWER FOUNTAIN. 120V/1PH/60HZ.	1/2"	-	1-1/2"	1-1/2
				ACCESSORIES: 17 GA. SEMI-CAST BRASS P-TRAP WITH CLEANOUT, CHROME-PLATED SUPPLY AND STOP, J.R. SMITH FLOOR MOUNTED TYPE SUPPORT WITH "PRO-SET" UPRIGHTS. NOTES: MOUNT WITH LOWER LEVEL SPOUT 35" ABOVE FINISH FLOOR.				
ES-1	EMERGENCY FREE STANDING SHOWER AND EYE WASH (ADA)	HAWS	8309WC	GALVANIZED STEEL STAND WITH FLOOR MOUNTING FLANGE, 1-1/4" WATER INLET AND DRAIN, SHOWER WITH ABS SHOWER HEAD WITH 20 GPM FLOW CONTROL, 1" BALL VALVE AND PULL ROD, STAINLESS STEEL EYE WASH BOWL, BALL VALVE AND OPERATOR, WASH HEAD AND DUST COVER AND EMERGENCY SIGNAGE. ACCESSORIES: 1-1/4" WATER SUPPLY WITH WALL ESCUTCHEON, 1-1/4" X 1-1/2" 17 GA. SEMI-CAST BRASS P-TRAP WITH CLEAN-OUT. HAWS MODEL 9201H LEAD-FREE EMERGENCY THERMOSTATIC HOT AND COLD WATER 31 GPM MIXING VALVE.	1-1/4"	-	2"	2"
FS-1	SANITARY FLOOR SINK	J.R. SMITH	3100Y	MEDIUM CAPACITY SANITARY FLOOR SINK, 8½" ROUND TOP, 6" DEEP CAST IRON BODY WITH ACID RESISTANT COATED INTERIOR, NICKEL BRONZE GRATE, ALUMINUM DOME STRAINER, ANCHOR FLANGE, SEEPAGE HOLES, FLASHING CLAMP. NO HUB OUTLET. PROVIDE 3/4 TOP WHERE DRAIN RECEIVES INDIRECT WASTE.	-	-	3"	2"
RD-1	ROOF DRAIN	J.R. SMITH	1310-Y OR 1320-Y	12" DIAMETER GENERAL PURPOSE TYPE WITH DUCO CAST IRON BODY AND ALUMINUM DOME, COMBINED FLASHING CLAMP AND GRAVEL STOP, UNDERDECK CLAMP AND NO-HUB OUTLET. PROVIDE WITH EXTENSION, SUMP RECEIVER AND SECONDARY FLASHING CLAMP AS REQUIRED BY APPLICATION. WHERE DRAINS HAVE NO HORIZONTAL OFFSET, PROVIDE WITH J. R. SMITH 1710 EXPANSION JOINT FITTING. SEE PLAN FOR OUTLET SIZE.	-	-	-	-
OD-1	ROOF OVERFLOW DRAIN	J.R. SMITH	1310-Y WD OR 1320-Y WD	12" DIAMETER GENERAL PURPOSE TYPE WITH WATER DAM, DUCO CAST IRON BODY AND ALUMINUM DOME, COMBINED FLASHING CLAMP AND GRAVEL STOP, UNDERDECK CLAMP AND NO-HUB OUTLET. OVERFLOW DRAINS WITH DAMS SHALL BE SET WITH INLET 2" ABOVE REGULAR DRAINS AND/OR PROVIDED WITH EXTENSION RING. PROVIDE WITH EXTENSION, SUMP RECEIVER AND SECONDARY FLASHING CLAMP AS REQUIRED BY APPLICATION. WHERE DRAINS HAVE NO HORIZONTAL OFFSET, PROVIDE WITH J. R. SMITH 1710 EXPANSION JOINT FITTING. SEE PLAN FOR OUTLET SIZE.	-	-	-	-
DS-1	DOWNSPOUT NOZZLE	J.R. SMITH	1770	CAST BRONZE NOZZLE AND WALL FLANGE. SEE PLAN FOR OUTLET SIZE.	-	-	-	-
TD-1	TRENCH DRAIN	SMITH ACO	9818	6" WIDE PRE-SLOPED MODULAR POLYMER CONCRETE TRENCH SYSTEM, STEEL POWER COATED FRAME AND ALL REQUIRED HARDWARE. 39" SECTION LENGTHS, TOTAL LENGTH 26'-0", CUT SECTIONS TO LENGTH. PROVIDE WITH MODULAR SLOTTED DUCTILE IRON CLASS C GRATE SECTIONS WITH VANDAL PROOF LOCKDOWN SYSTEM, PROVIDE WITH END CAPS AND DRAIN CONNECTION FITTINGS, LOCATION AS INDICATED ON DRAWINGS.	-	-	-	-

				TANK			MIN.	VENT		l	ELECTRICAL		
MARK NO.	MANUFACTURER	MODEL NO.	TANK LINING	CAPACITY (GAL)	RECOVERY (GPH @ 85 F)	INPUT (MBH)	THERMAL EFF, %	SIZE (IN)	THERMAL EXPANSION TANK MODEL NO.	VOLT	ø	HZ	NOTI
DWH-1	AO SMITH	BTH-400A MXI	GLASS	119	541	399.9	95	4	PLT-35	120	1	60	1,2,
DWH-2	AO SMITH	BTH-400A MXI	GLASS	119	541	399.9	95	4	PLT-35	120	1	60	1,2,

PLU	MBING P	UMP	SCHEDUL	.E								
									ELEC1	RICAL		
MARK	MANUFACTURER	MODEL	USE	TYPE	FLOW	HEAD	RPM					NOTES
NO.					(GPM)	(FT.)		VOLT	Ø	HZ	HP	
CP-1	BELL & GOSSETT	PL30B	RECIRC	INLINE	4	10	2450	120	1	60	1/12	1
NOTES:	1. PROVIDE WITH AQ	UASTAT AND A	AUTOMATIC TIMER KIT.	1	1					I		•

 NEW PIPING
 CW - COLD WATER
 HW - HOT WATER
 HWR - HOT WATER RETURN
 NG - NATURAL GAS
 V - SANITARY VENT ABOVE GR

T ABOVE GRD./FLOOR ABOVE V - SANITARY VENT BELOW GROUND W - SANITARY WASTE ABOVE GRD./FLOOR ABOVE ---- W - SANITARY WASTE BELOW GROUND

SD - PRIMARY STORM DRAINAGE ABOVE GRD./FLOOR ABOVE SD - PRIMARY STORM DRAINAGE BELOW GROUND OD - SECONDARY STORM DRAINGE ABOVE GRD./FLOOR ABOVE BALANCE VALVE GAS SHUT-OFF COCK

3. PROVIDE SEALED COMBUSTION WITH CONCENTRIC ROOF VENT KIT.


SHUT-OFF VALVE FLOOR DRAIN PIPE DROP/ PIPE RISE **→ → BOTTOM OUTLET TEE** HOSE BIBB WH O H WALL HYDRANT WALL CLEANOUT FFCO 🖸

FINISHED FLOOR CLEANOUT VTR 🔘 VENT THROUGH ROOF DWH-1 **EQUIPMENT TYPE AND DESIGNATION** PLUMBING FIXTURE TYPE AND DESIGNATION


RD 🔘 **ROOF DRAIN OVERFLOW DRAIN**

GENERAL NOTES (TYPICAL ALL SHEETS)

- A. PLUMBING CONTRACTOR IS RESPONSIBLE TO SEE THAT WORK MEETS AND IS IN ACCORDANCE WITH ALL REQUIREMENTS OF FEDERAL, STATE, AND LOCAL LAWS AND CODES AND/OR REQUIREMENTS, INCLUDING HEALTH CODES AND BUILDING OWNER.
- B. COORDINATE ALL WORK WITH OTHER TRADES PRIOR TO INSTALLATION TO AVOID ROUTING
- C. INSTALL ELASTOMERIC JOINT SEALER AROUND ALL PIPES PASSING THRU INTERIOR NON- RATED CONCRETE AND MASONRY WALLS, GYPSUM-BOARD PARTITIONS, AND CONCRETE FLOOR/ROOF SLABS. FOR FIRE RATED INTERIOR CONCRETE AND MASONRY WALLS, GYPSUM-BOARD PARTITIONS, AND CONCRETE FLOOR/ROOF SLABS SEAL ALL PIPES. INSTALL FIRESTOP MATERIALS IN ALL GAPS PRIOR TO SEALANT APPLICATION. INSTALL SEALER ACCORDING TO MANUFACTURER'S WRITTEN INSTRUCTIONS.
- D. PLUMBING CONTRACTOR SHALL MAKE FINAL CONNECTION TO ALL EQUIPMENT BY OTHERS. VERIFY CONNECTIONS SIZES AND REQUIREMENTS.
- E. PIPING ROUTED BELOW COUNTER IN CABINETS SHALL BE ROUTED AS NOTED. NOT TO INTERFERE WITH DRAWERS, SHELVES, EQUIPMENT, ETC., AND SUPPORT FROM BACK WALL OF
- F. PLUMBING CONTRACTOR SHALL SCAN FLOOR UTILIZING GROUND PENETRATING RADAR PRIOR TO ANY CORE DRILLING OR SAW CUTTING OF SLAB AND SHALL VERIFY PLACEMENT WITH BUILDING OWNER'S REPRESENTATIVE PRIOR TO DRILLING.
- G. PLUMBING CONTRACTOR SHALL PROVIDE PRO-SET SYSTEMS 'TRAP GUARD' IN ALL FLOOR DRAIN TRAPS WITHIN PROJECT SCOPE OF WORK.
- H. PLUMBING CONTRACTOR SHALL VERIFY WALL THICKNESS WITH ARCHITECT PRIOR TO ORDERING FREEZE PROOF WALL HYDRANTS.
- I. UPON REQUEST FOR ELECTRONIC FILES, CONTRACTOR SHALL FILL OUT, SIGN AND RETURN ELECTRONIC MEDIA RELEASE FORM FROM ENGINEER AND PROVIDE PAYMENT FOR FEES STIPULATED ON ELECTRONIC MEDIA RELEASE FORM. UPON RECEIPT OF COMPLETED RELEASE FORM AND PAYMENT, ELECTRONIC FILES WILL BE RELEASED.
- J. ALL CABLE TIES FOR LOW VOLTAGE SYSTEMS LOCATED IN PLENUMS UTILIZED FOR AIR MOVEMENT THAT ARE NOT INSTALLED IN CONDUIT SHALL BE 25/50 FLAME AND SMOKE RATED, HELLERMANN TYTON T50 R2C2UL OR EQUIVALENT.

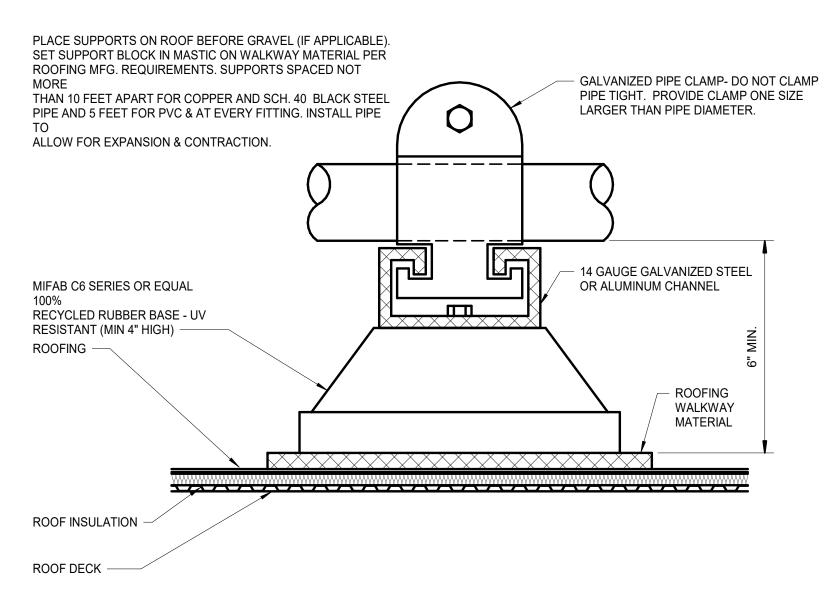

PREFAB ROOF PIPE SUPPORT DETAIL NOT TO SCALE

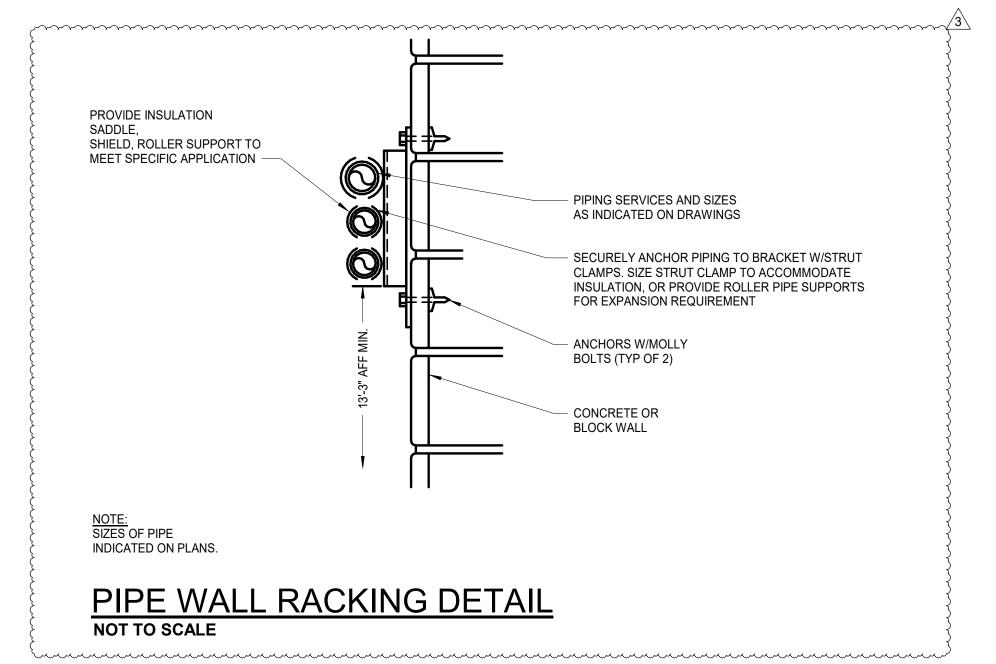







ARCHITECTS

924 FRANCIS ST. ST. JOSEPH, MO 64501 P: 816-233-8003 F: 816-233-7793

www.ellison-auxier.com

CONSULTANTS

L|F+a Project No. 22.7184.00

GENERAL NOTES, &

PLUMBING SCHEDULES,


NO. ISSUE DESCRIPTION

NO. REVISION DESCRIPTION DATE

ADDENDUM #3

DATE

05.23.2023

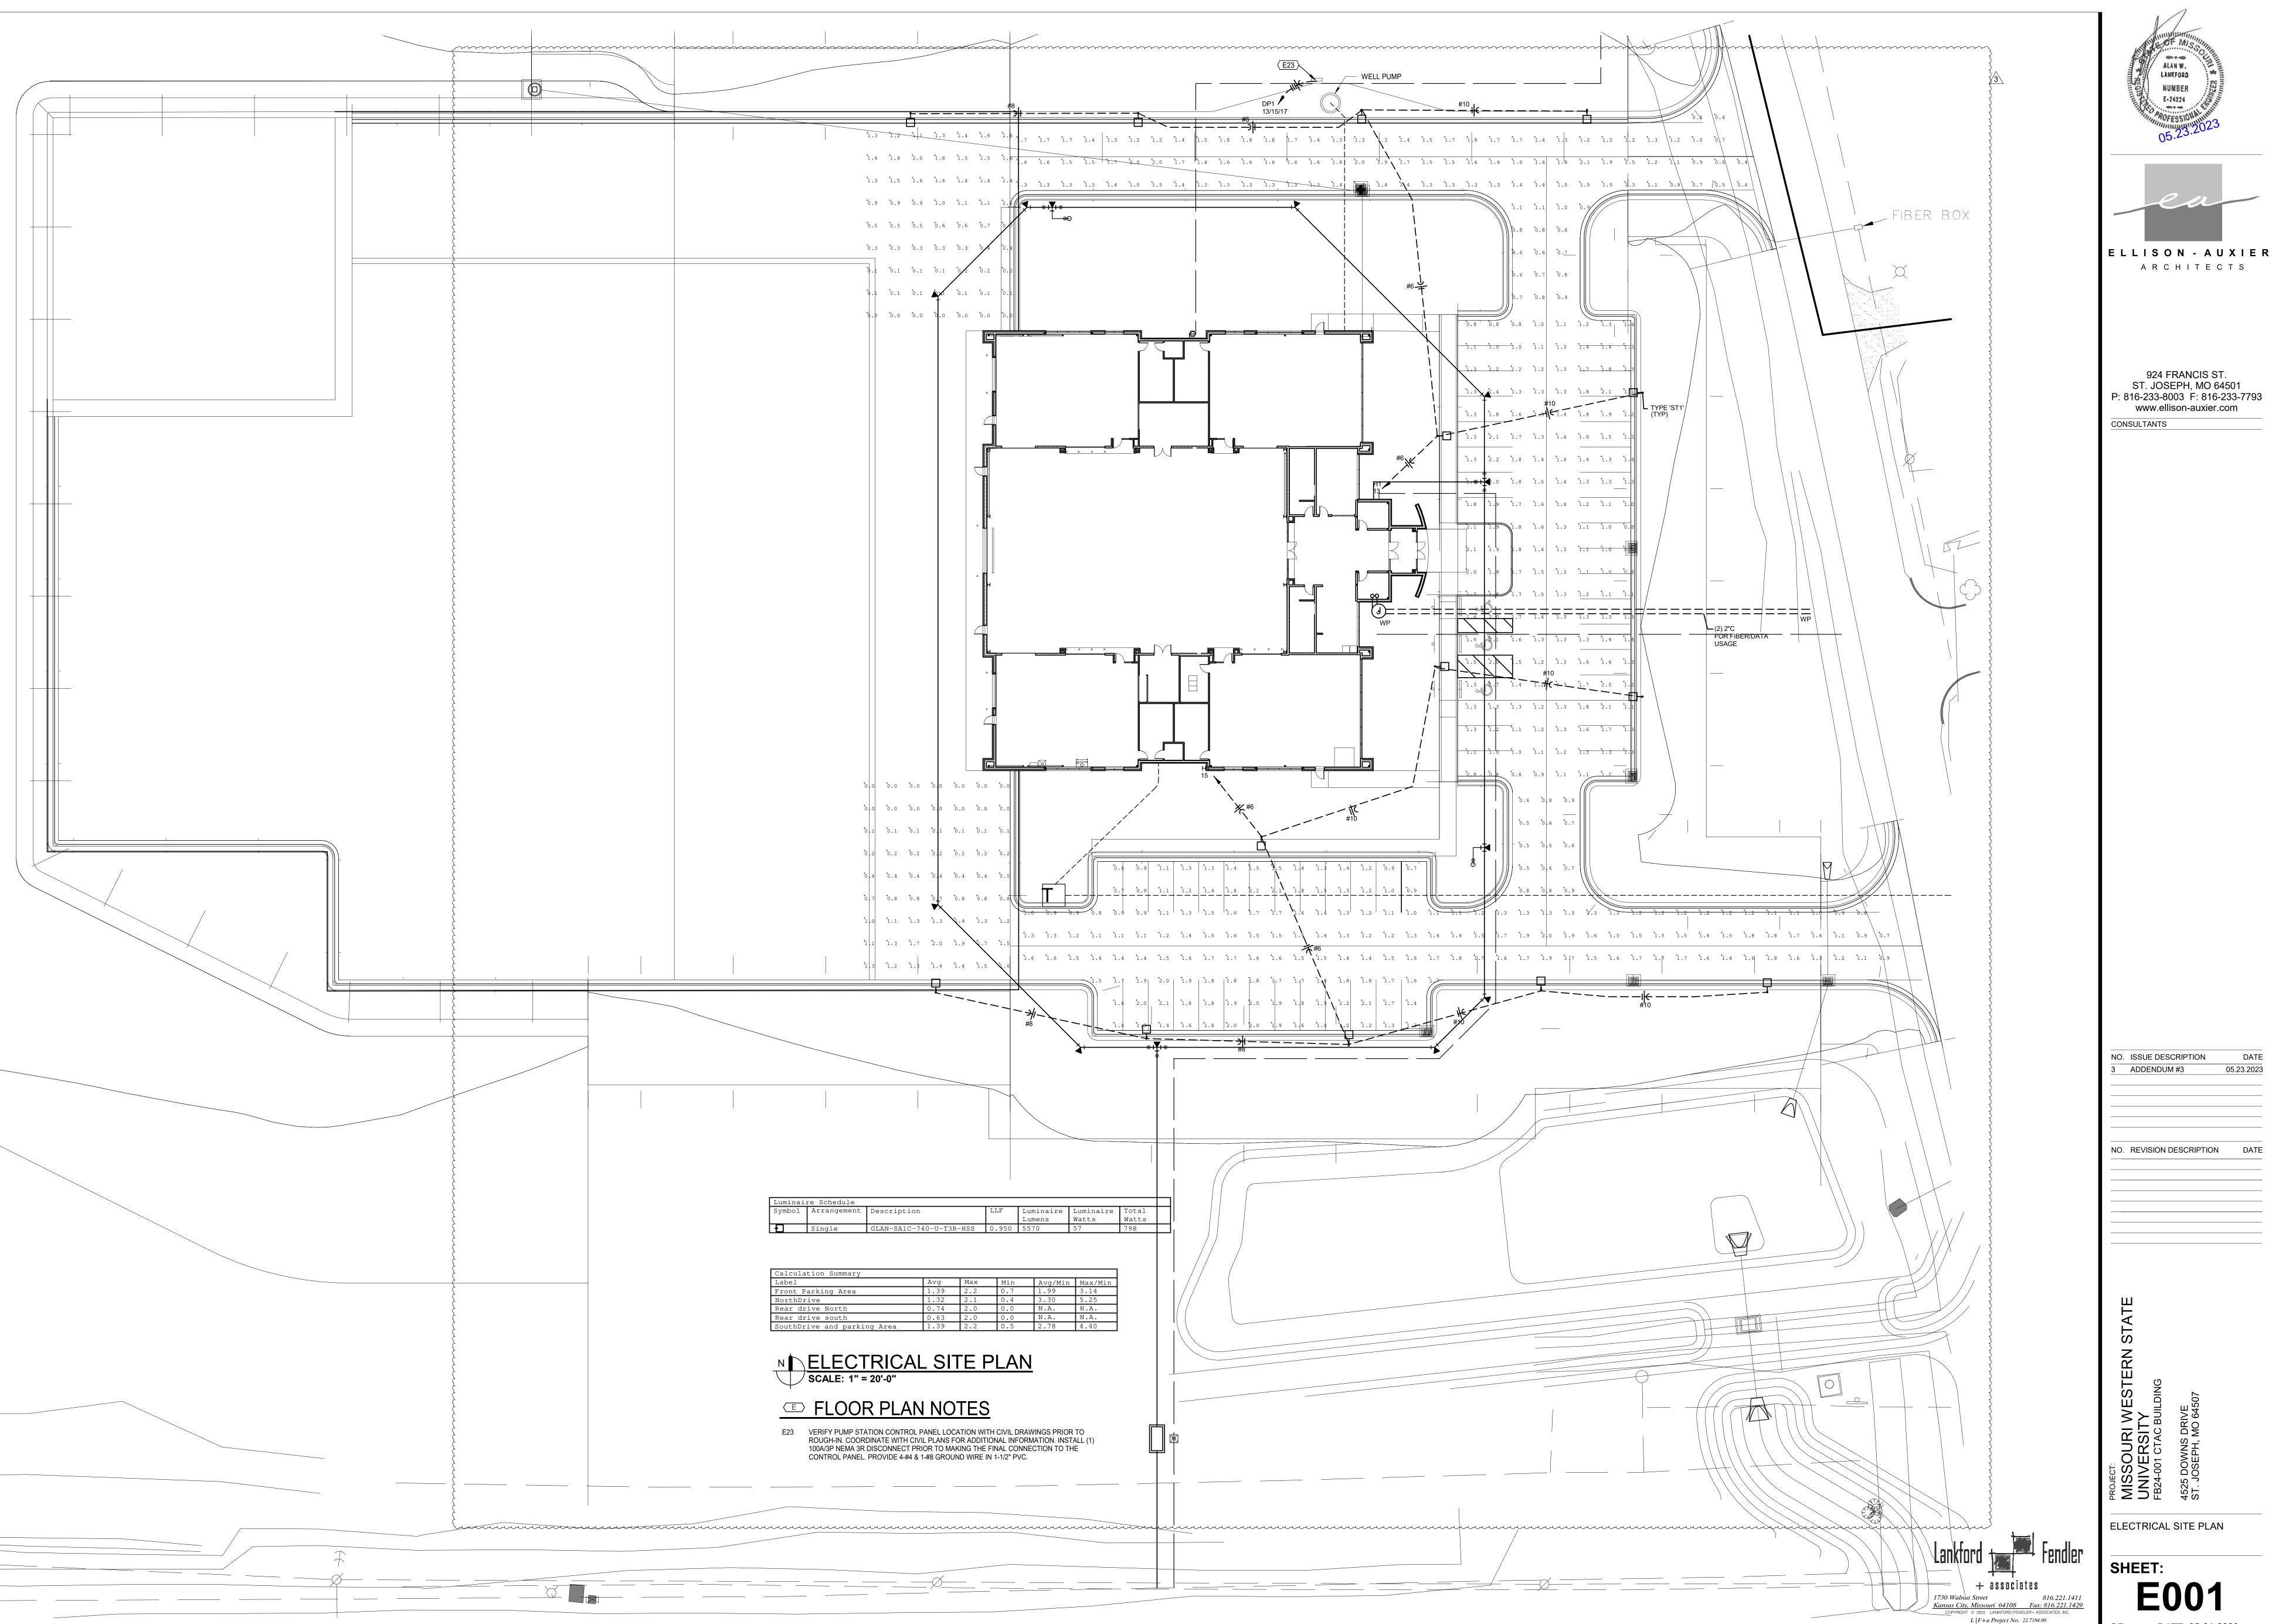






924 FRANCIS ST. P: 816-233-8003 F: 816-233-7793

NO. REVISION DESCRIPTION DATE

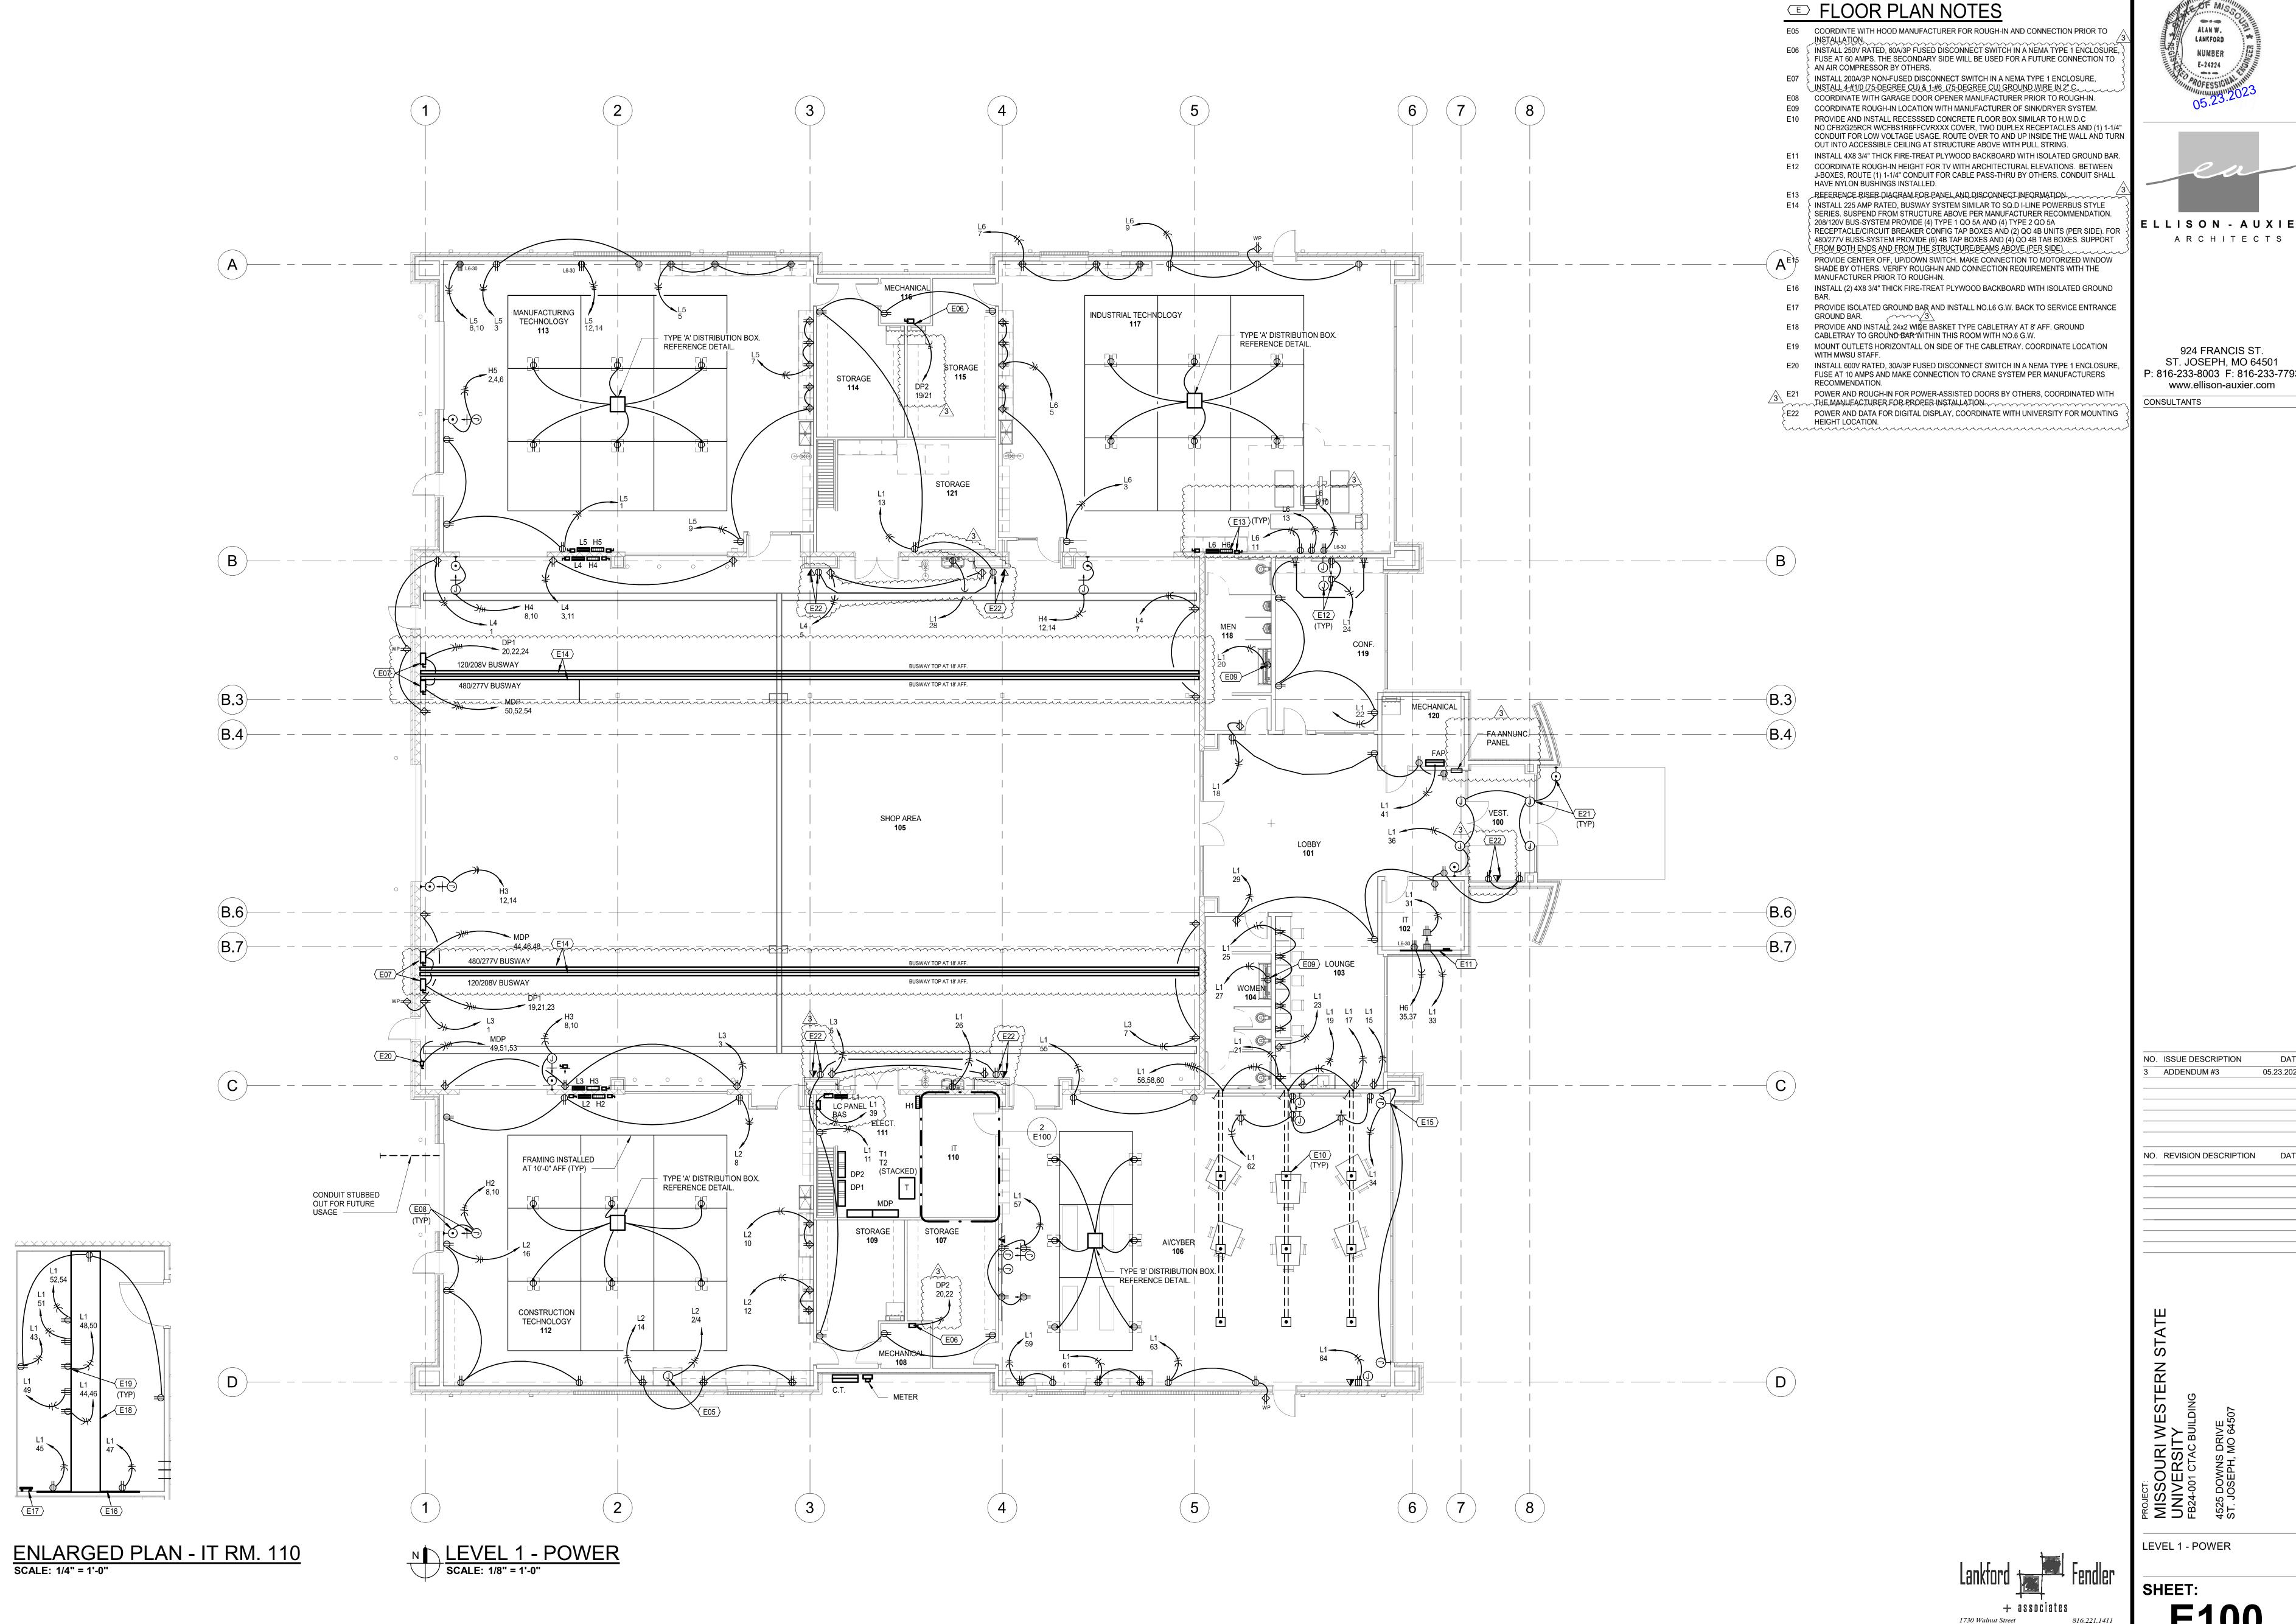





924 FRANCIS ST. ST. JOSEPH, MO 64501 P: 816-233-8003 F: 816-233-7793

CONSULTANTS

NO. REVISION DESCRIPTION DATE

LEVEL 1 - POWER


Kansas City, Missouri 64108 Fax: 816.221.1419

COPYRIGHT © 2023 LANKFORD|FENDLER+ ASSOCIATES, INC. $L \mid F+a \text{ Project No. } 22.7184.00$



FLOOR PLAN NOTES

- E01 INSTALL FIXTURES ON BOTTOM JOIST.
- E02 SUSPEND FIXTURES FROM CEILING/ JOIST ABOVE AT 26' AFF.E03 LIGHTING/CONTROL CIRCUIT ROUTED THRU LIGHTING CONTROL PANEL
- E04 INSTALL PHOTO-CELL ON ROOF AND FACE NORTH.

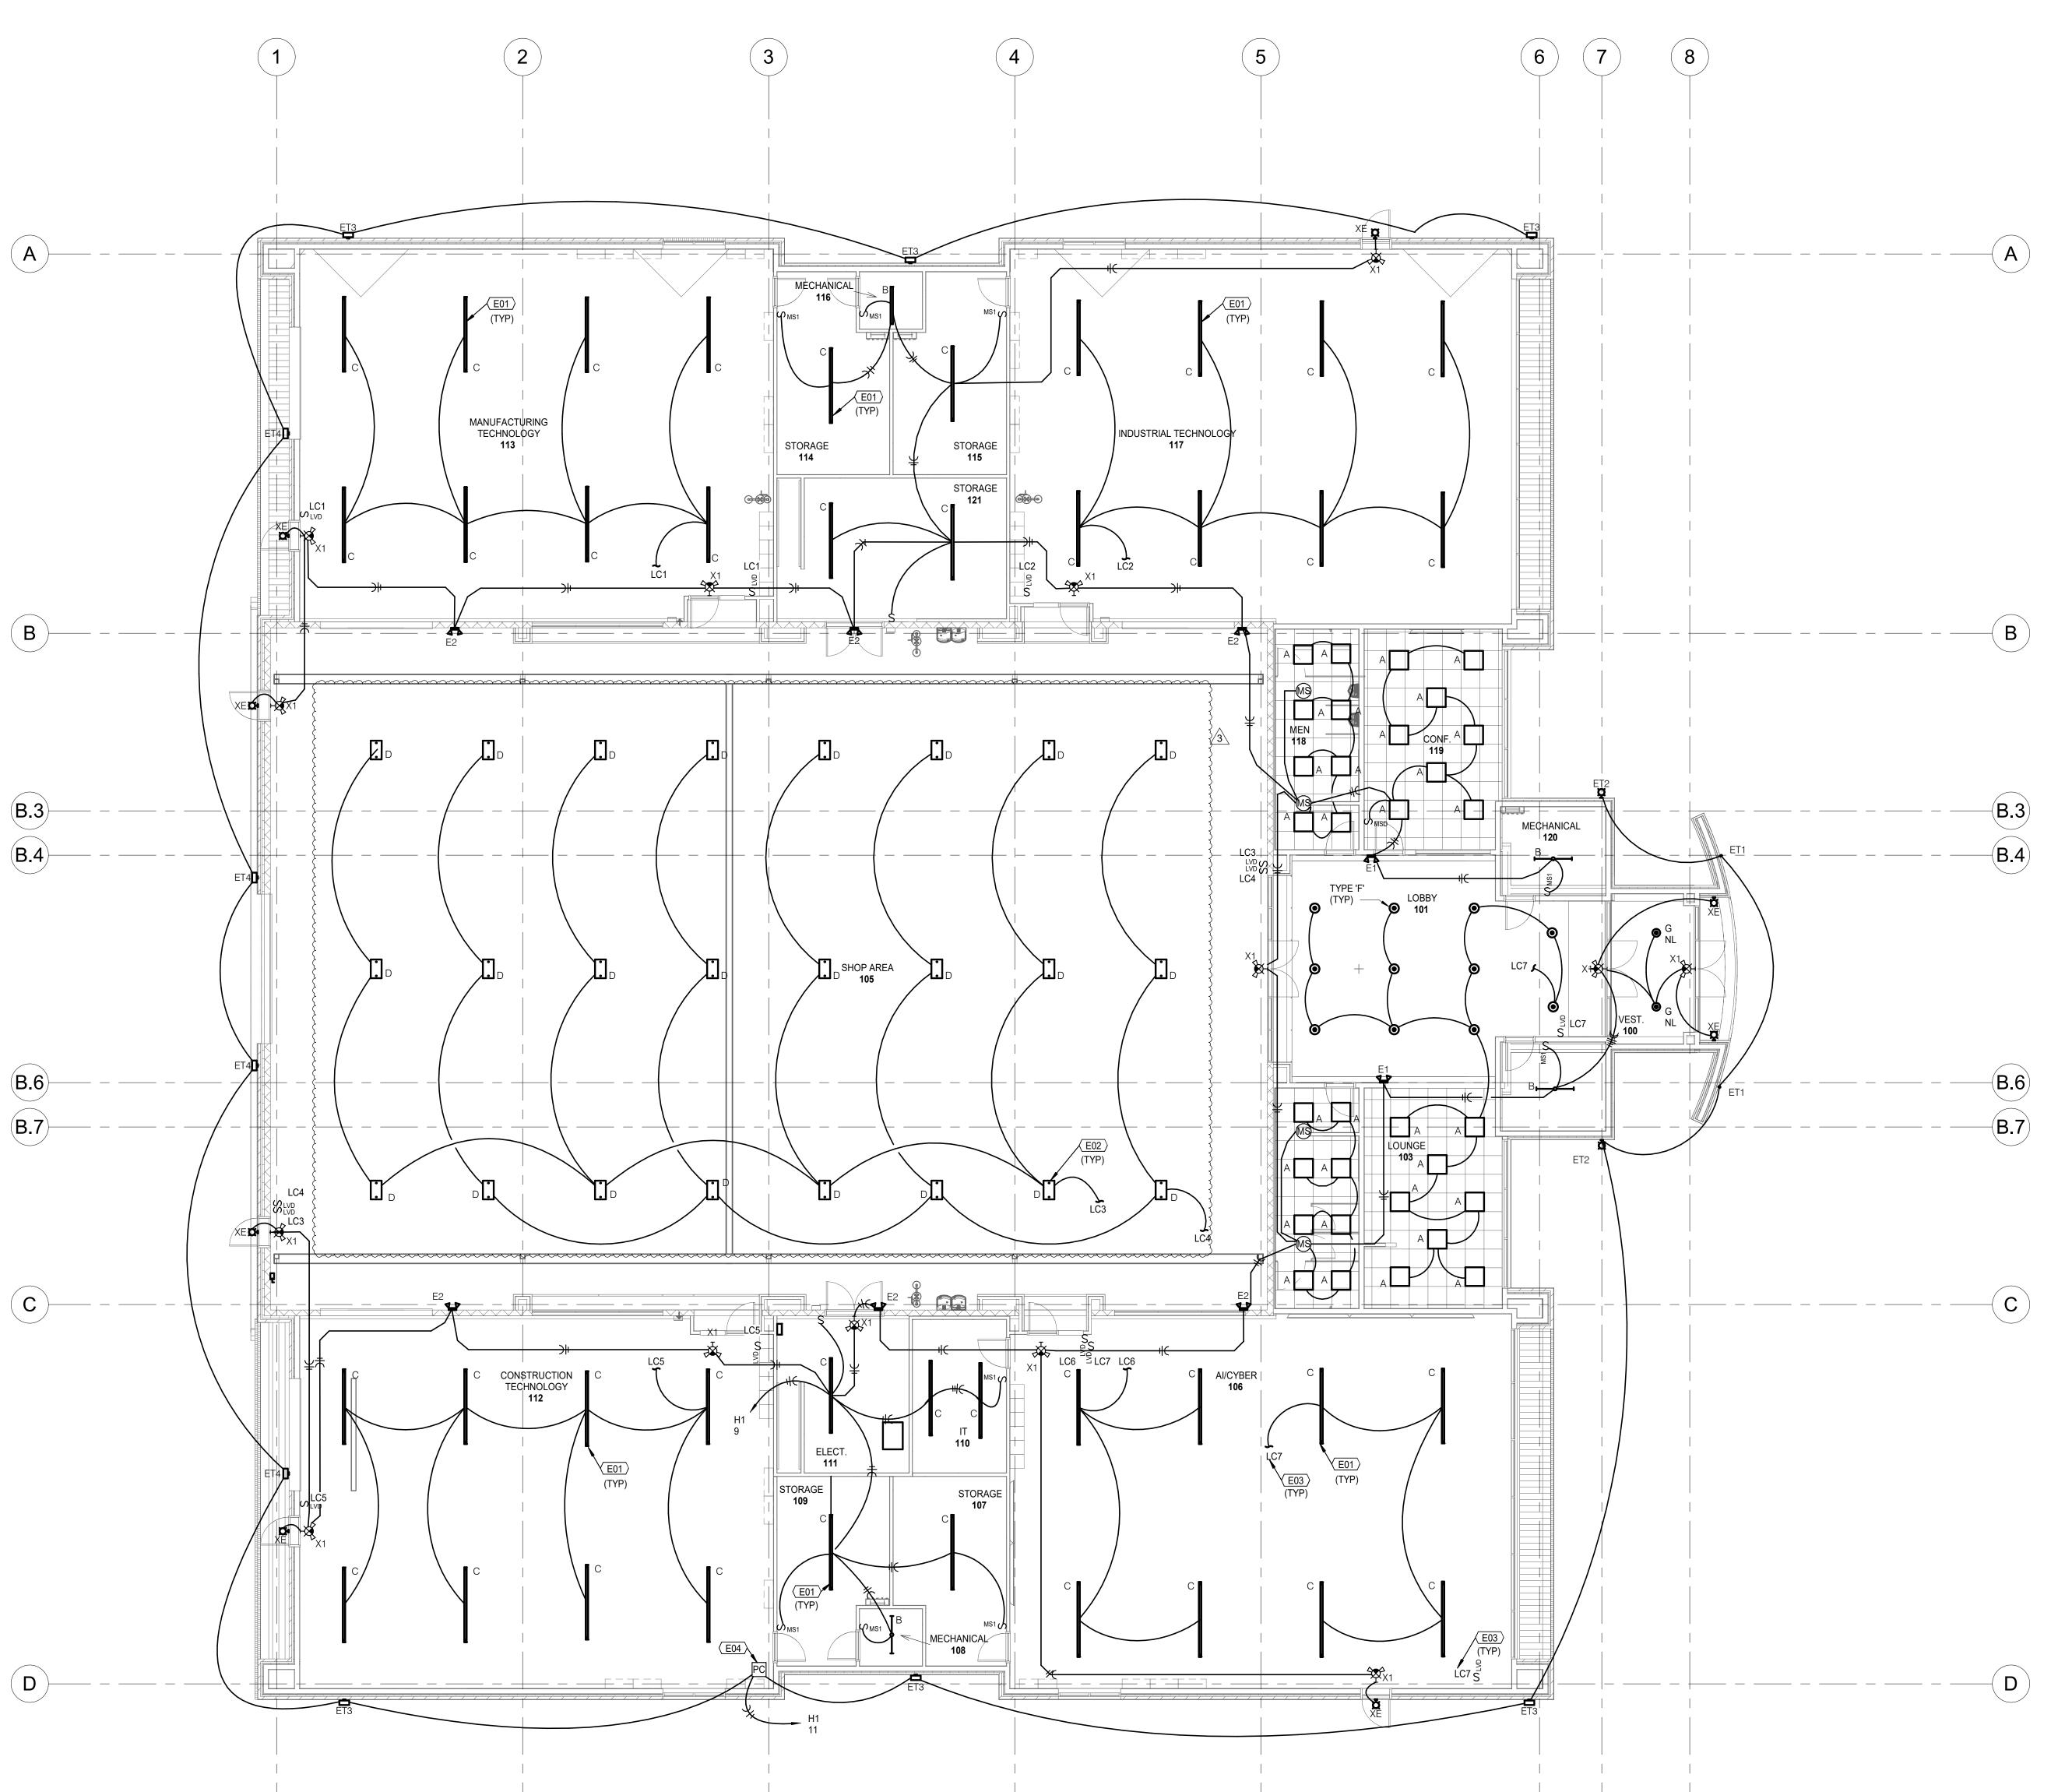

2

N LEVEL 1 - LIGHTING
SCALE: 1/8" = 1'-0"







ARCHITECTS

924 FRANCIS ST. ST. JOSEPH, MO 64501 P: 816-233-8003 F: 816-233-7793 www.ellison-auxier.com

CONSULTANTS

NO. ISSUE DESCRIPTION DATE
3 ADDENDUM #3 05.23.202

NO. REVISION DESCRIPTION DATE

SOURI WESTERN STATE VERSITY

VERSITY


-001 CTAC BUILDING

DOWNS DRIVE

OSEPH, MO 64507

LEVEL 1 - LIGHTING

SHEET: **E200**

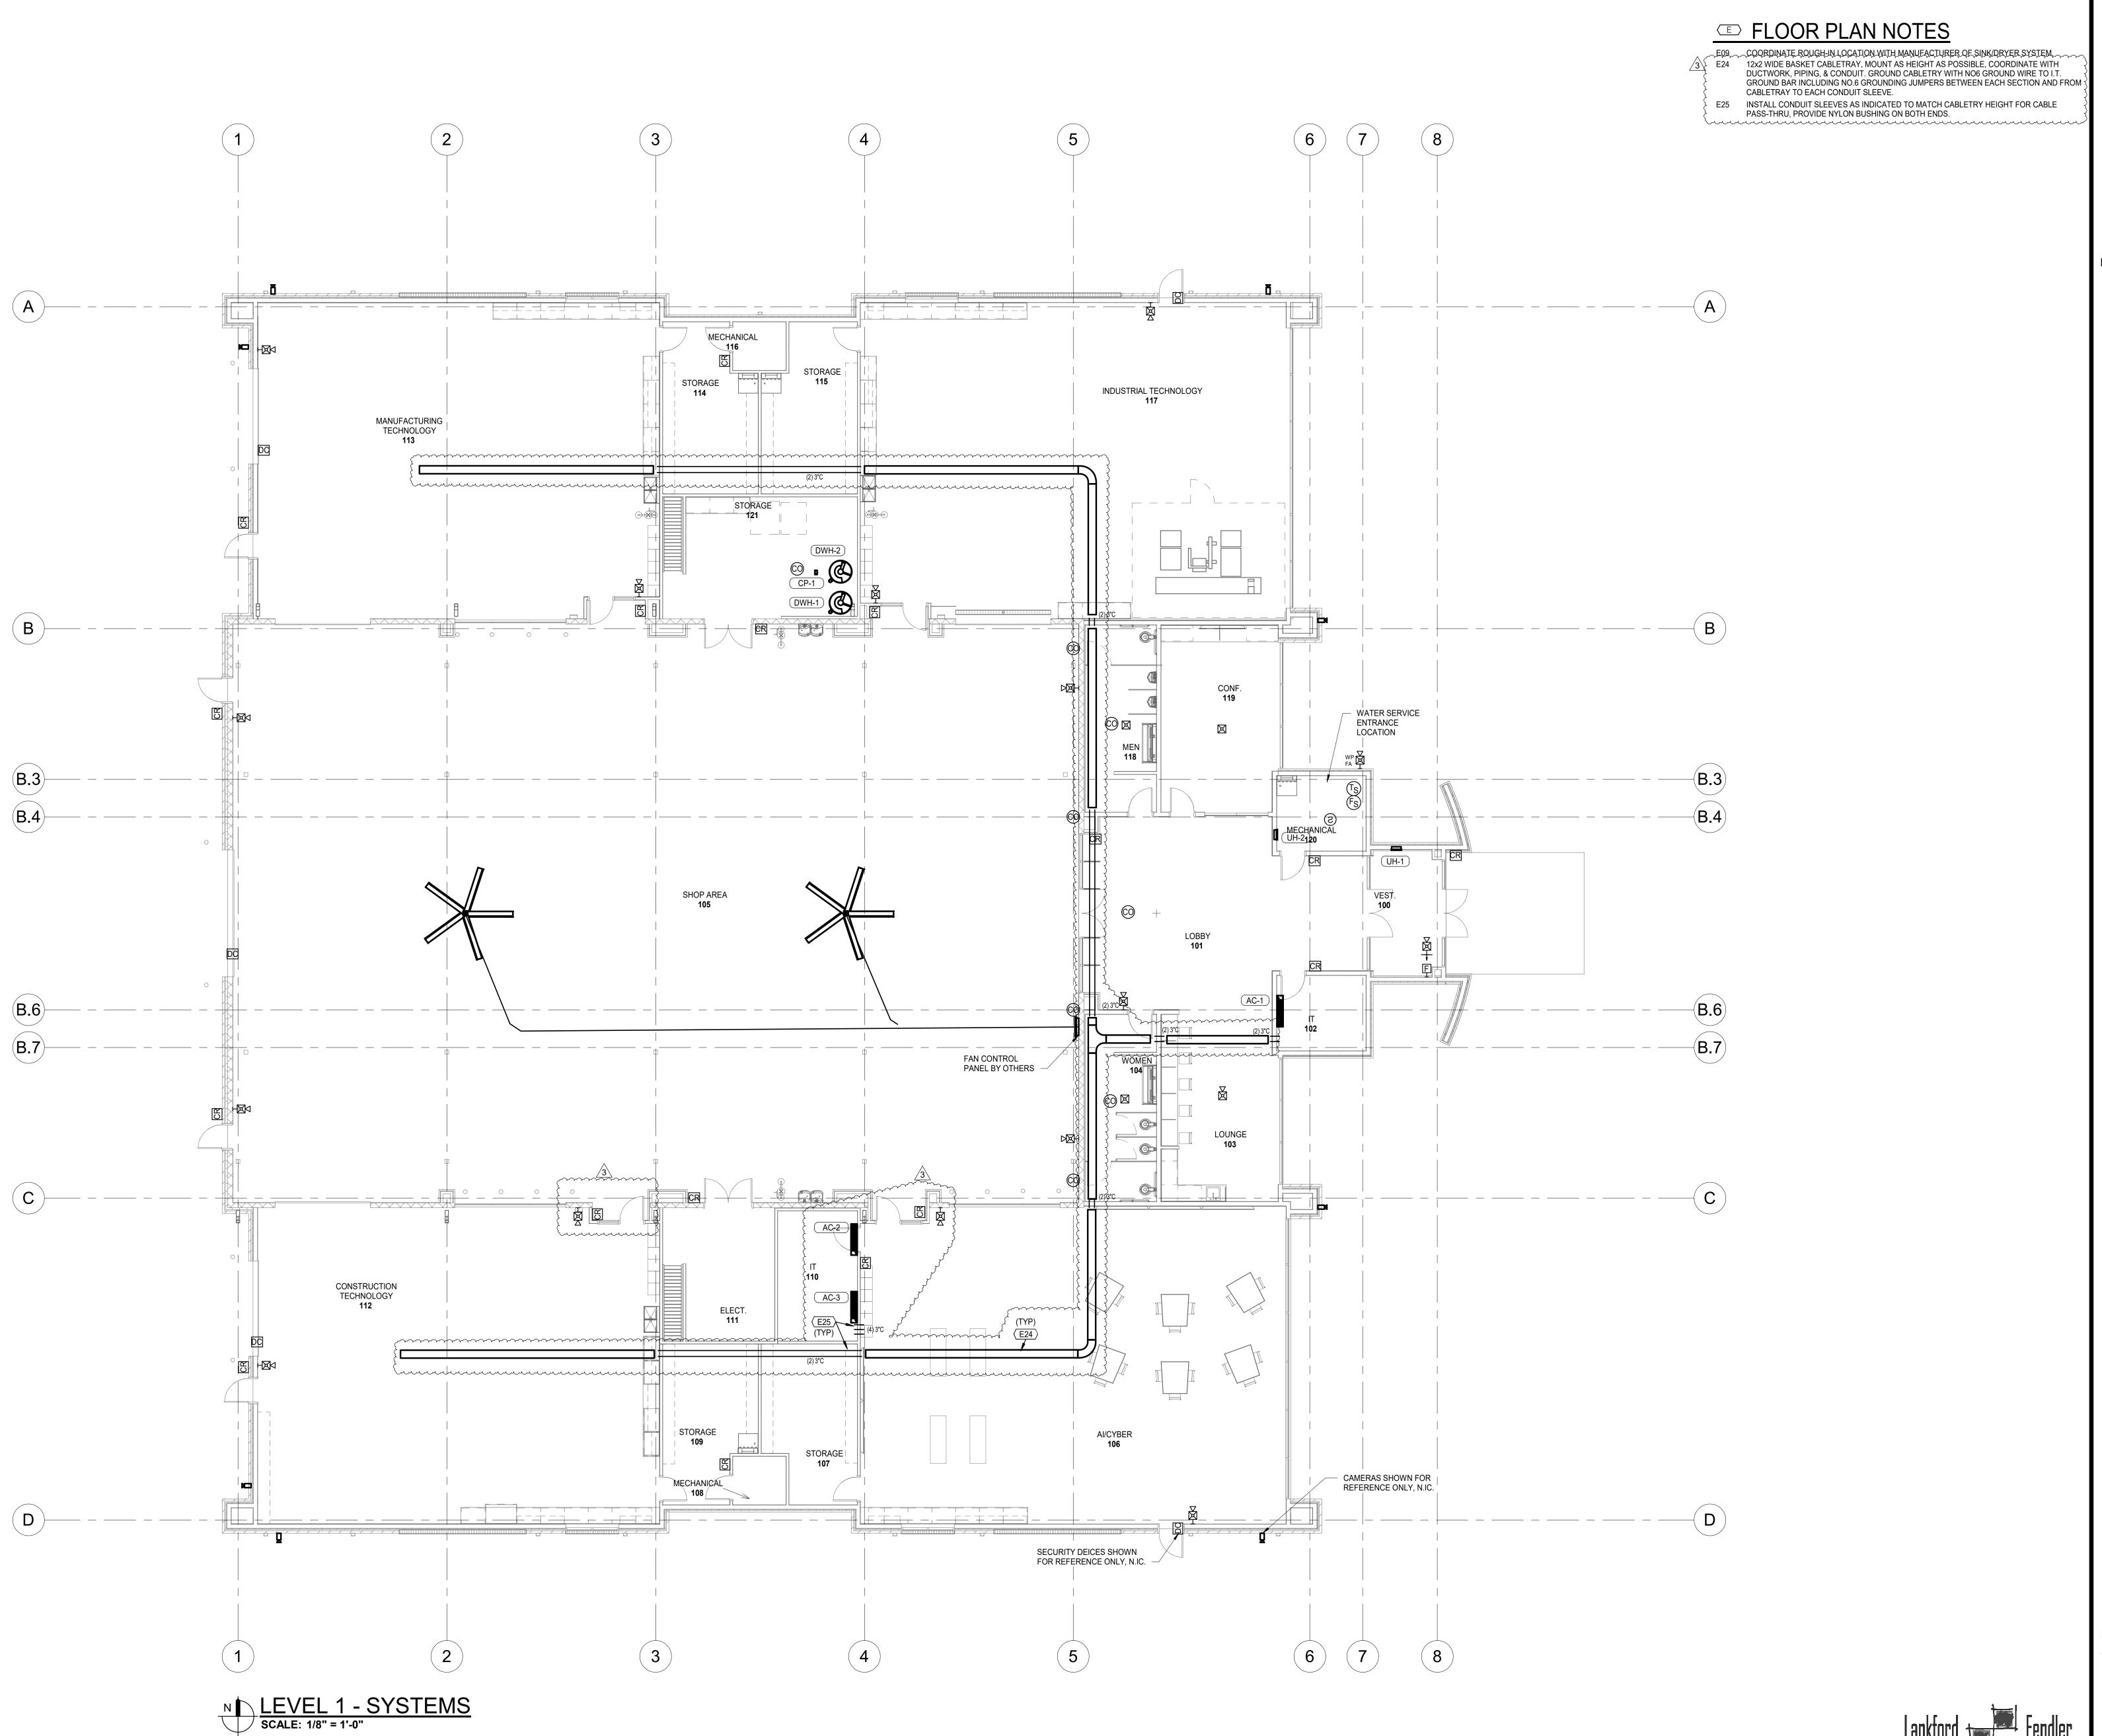

ALAN W.
LANKFORD
NUMBER
E-24224
05.23.2023

ELLISON - AUXIER
ARCHITECTS

924 FRANCIS ST. ST. JOSEPH, MO 64501 P: 816-233-8003 F: 816-233-7793 www.ellison-auxier.com

CONSULTANTS

NO. ISSUE DESCRIPTION DATE 3 ADDENDUM #3 05.23.20


NO. REVISION DESCRIPTION DATE

SSOURI WESTERN STATE
IVERSITY
4-001 CTAC BUILDING
DOWNS DRIVE
JOSEPH, MO 64507

MIS UN FB2,

LEVEL 1 - SYSTEMS




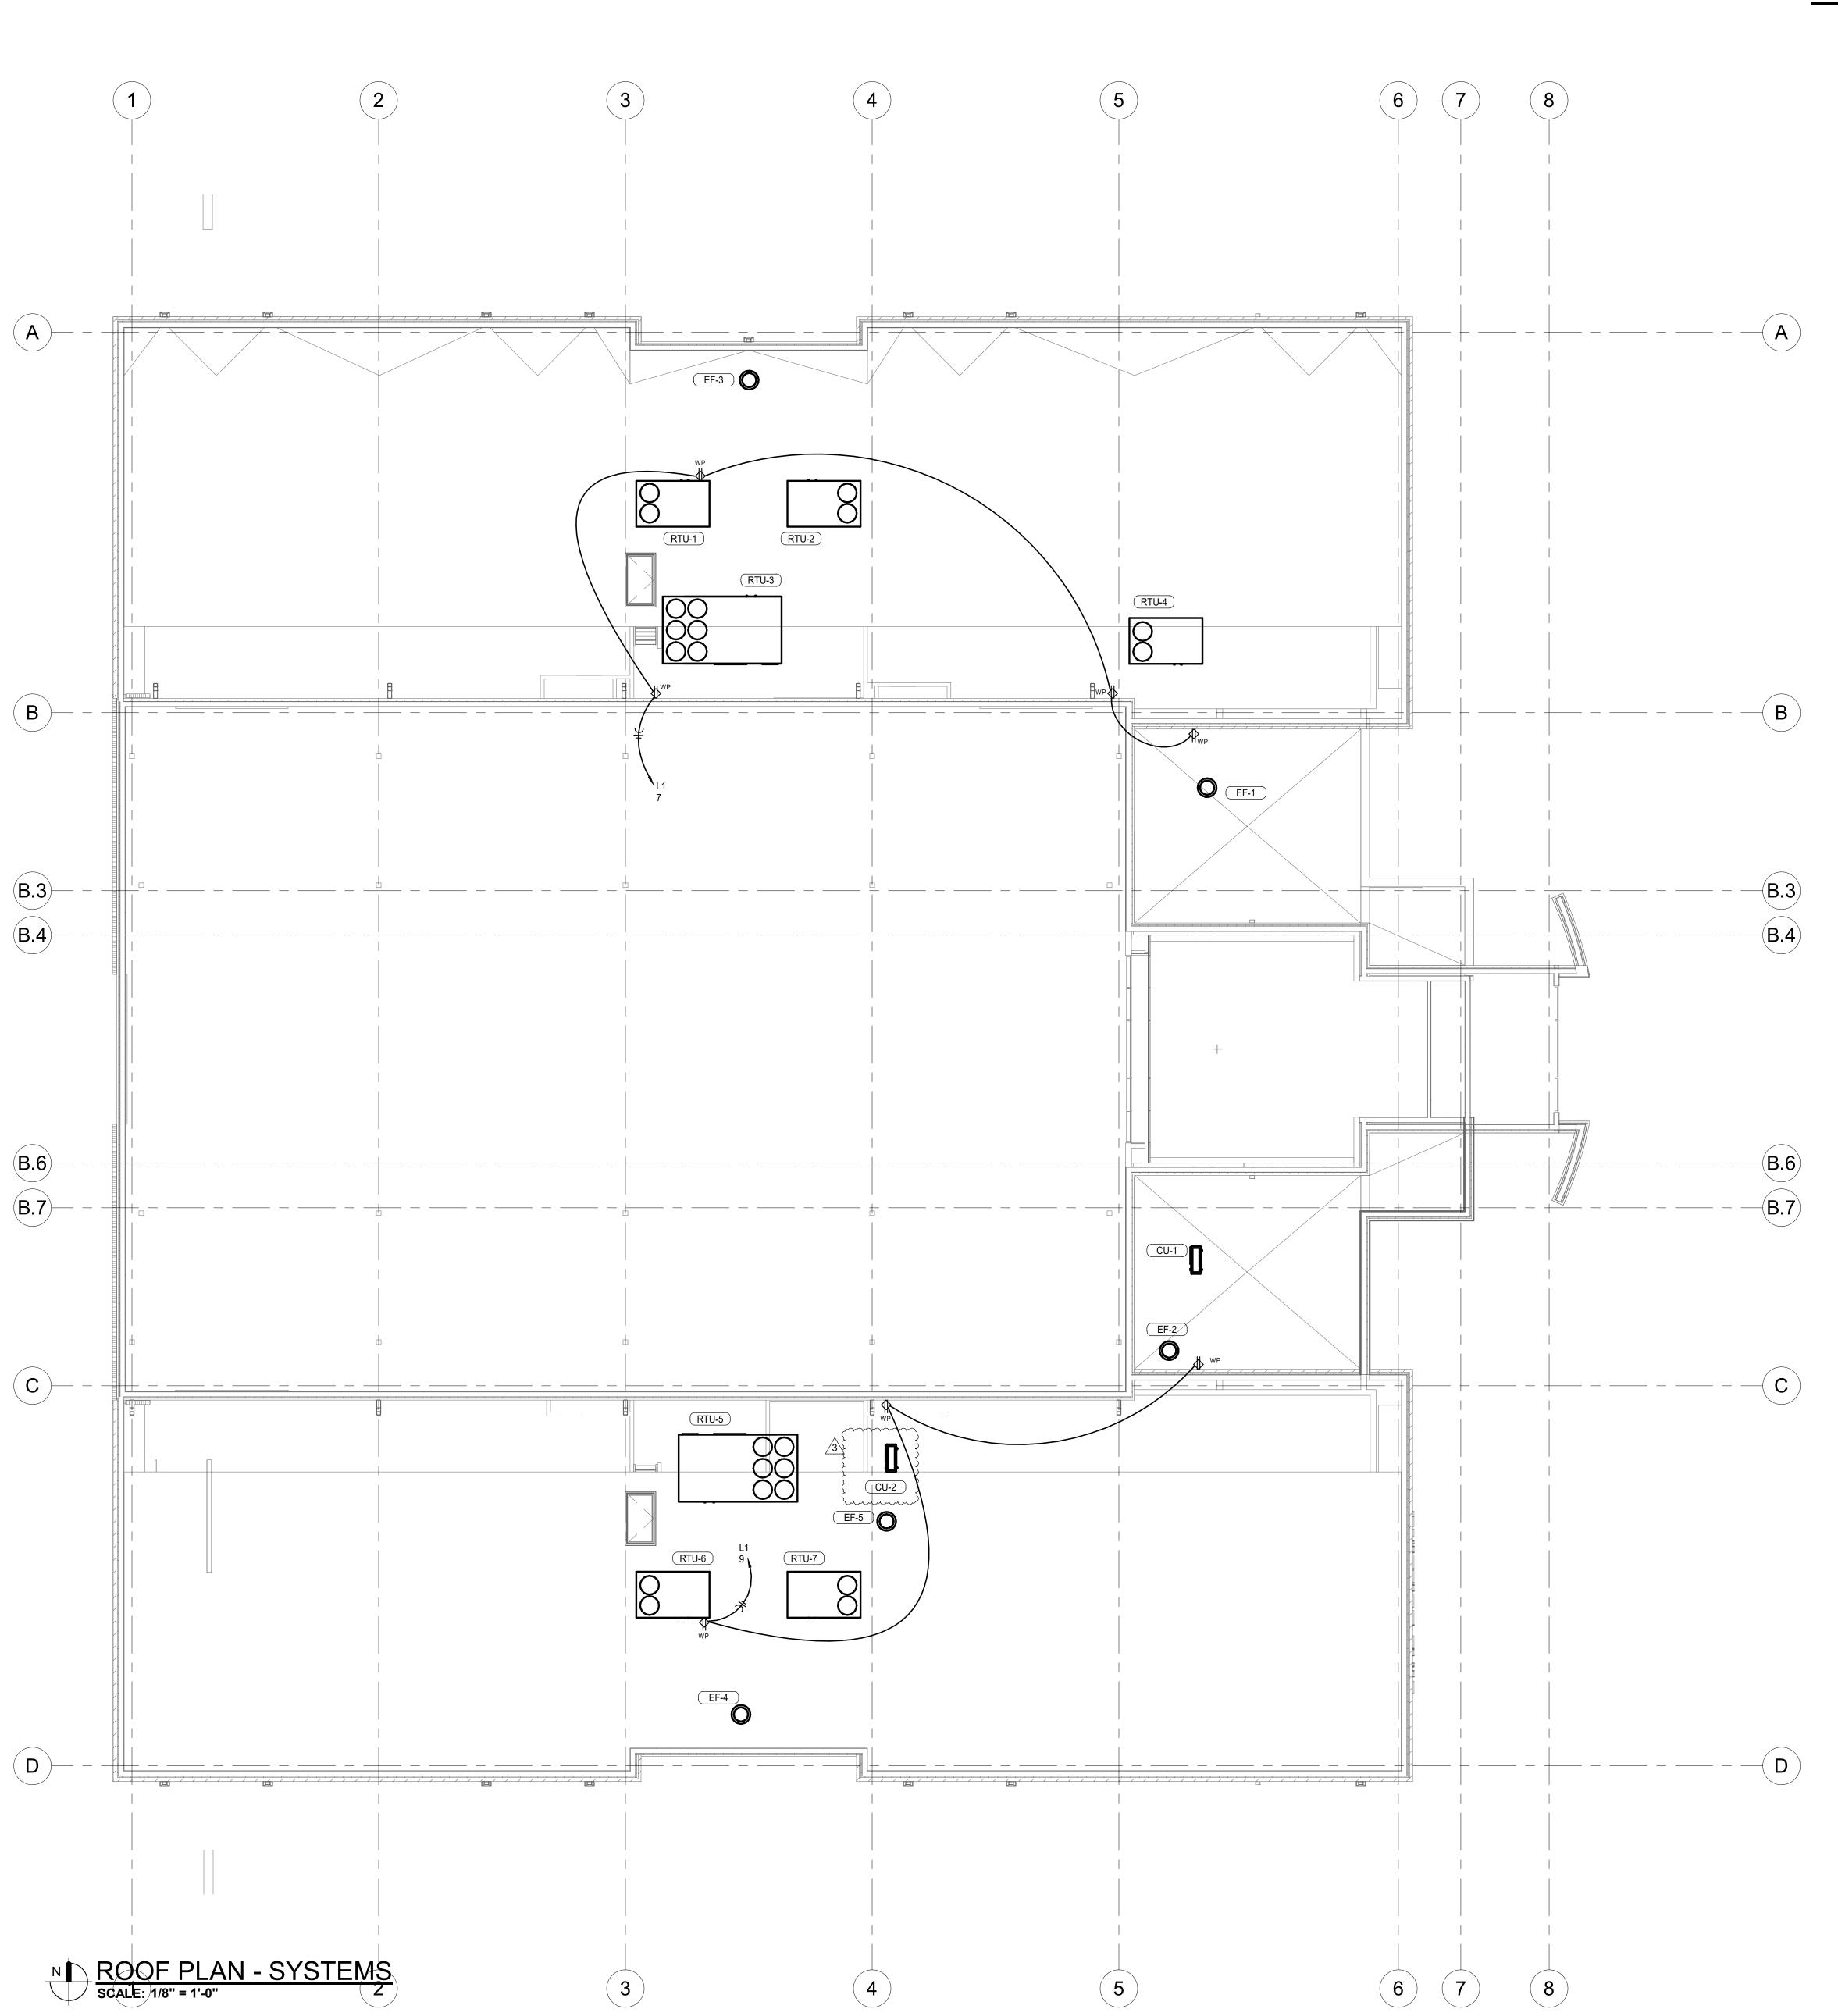








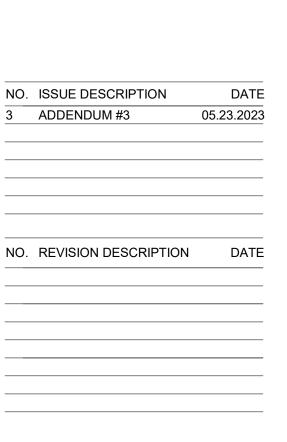


MISSOURI WESTERN ST,
UNIVERSITY
FB24-001 CTAC BUILDING
4525 DOWNS DRIVE
ST. JOSEPH, MO 64507

ROOF PLAN - SYSTEMS



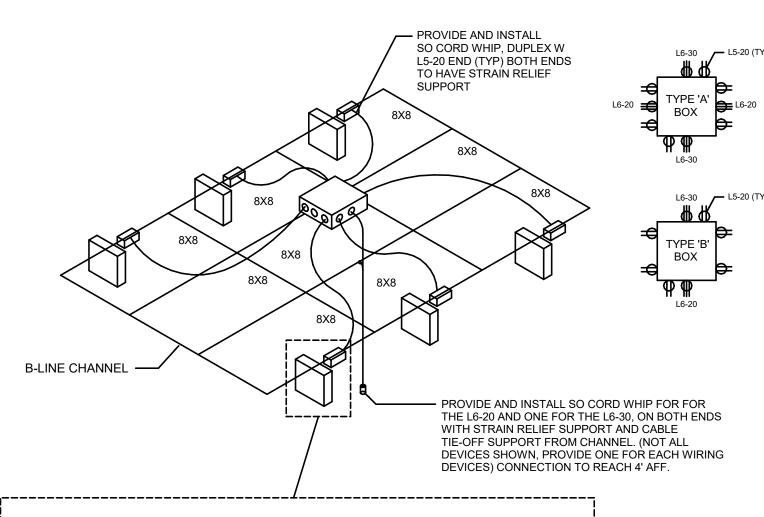

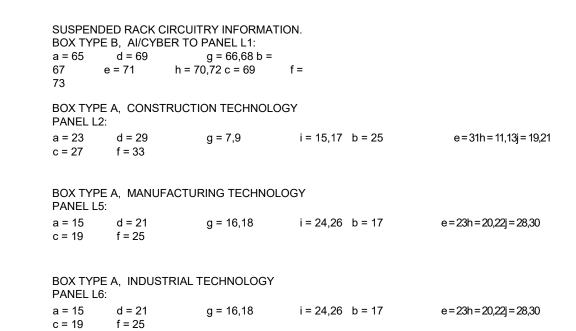

PLAN VIEW CEILING FRAMING STUD (TYP) WHEN MOUNTING DATA/PHONE AND RECEPTACLE DEVICES TOGETHER FLOOR COMMUNICATION OUTLET

TYPICAL MOUNTING OUTLET DETAIL

NOT TO SCALE

MAIN SERVICE ENTRANCE GROUNDING DETAIL NOT TO SCALE

SERVICE ENTRANCE WITH SIZE AND QUANTITY

- GROUND WIRE TO PANELBOARD. SIZE AS NOTED

ALL WIRING SHALL BE TYPE THHN/THWN.
 MAIN GROUP RODS ARE TO BE LOCATED AT

PER SPECIFICATIONS.

GROUNDING PLATE LOCATED

CONCRETE ENCASED ELECTRODE (UFER)

MAIN ELECTRICAL GROUND

- GROUND WIRE SIZE PER NEC 250. (TYP)

IN COMMUNICATION ROOM PER PLAN

TO MAIN WATER PIPE. ————

CONNECT AHEAD OF MAIN

SHUT OFF VALVE

TO BUILDING STEEL -

COPPER CLAD —

TYPICAL, 5/8"x10'

GROUND ROD

B-LINE END CAP B-LINE CHANNEL B-LINE SNAP CLOSURE B-LINE SNAP-IN OUTLET BOX FURNISH DUPLEX RECEPTACLE PROVIDE AND INSTALL 20 AMP RATED CORD REEL SIMILAR TO HUBBELL HBL145123R220M1 NOTES: 1. ALL PARTS SHALL BE B-LINE OR APPROVED EQUAL. 2. ALL EXPOSED EDGES OF T-BAR SHALL BE COVERED WITH GROMMET EDGING.

SUSPENDED WIRING DEVICE DETAIL NOT TO SCALE

CEILING GRID

—ELECTRIC STRIKE 1/2" C

TO LAN ROOM = — —

SECURE SIDE

PRE-DRILL 3/4" DIAMETER HOLE THROUGH HEADER

PROVIDE 2"X4" SINGLE GANG JUNCTION BOX FOR

(3) PROVIDE 1" EMPTY CONDUIT HOMERUN WITH PULL

(4) EXTEND 1/2" CONDUIT WITH PULL STRING TO MIDDLE

HINGE (FOR TOUCH-BAR WHERE APPLICABLE).

BACK TO LAN ROOM AND BUSH.

(5) PROVIDE 1/2" CONDUIT WITH PULL STRING.

STRING WHERE CEILING IS NOT ACCESSIBLE. ROUTE

PROVIDE 8"X6"X4" JUNCTION BOX WITH BLANK COVER.

PROVIDE 2"X4' SINGLE GANG JUNCTION BOX FOR AUTOMATIC DOOR OPENER WHERE SHOWN ON PLANS.

PROVIDE 2"X4" SINGLE GANG JUNCTION BOX FOR REX WHERE THERE IS AN EXIT SIGN, MOUNT REX BELOW

CARD ACCESS SYSTEM


ROUGH-IN DETAIL

NO SCALE


PROVIDE 3/4" CONDUIT WITH TWO PULL STRINGS.

CARD ACCESS NOTES


CARD READER.

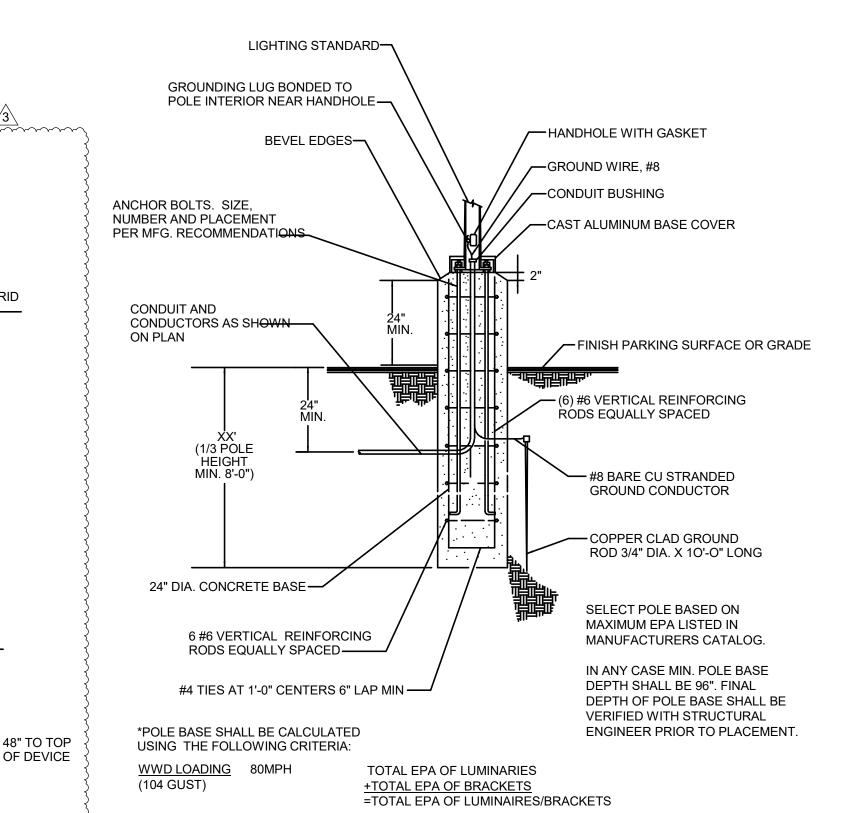

LIGHTING POLE BASE DETAIL
NO SCALE

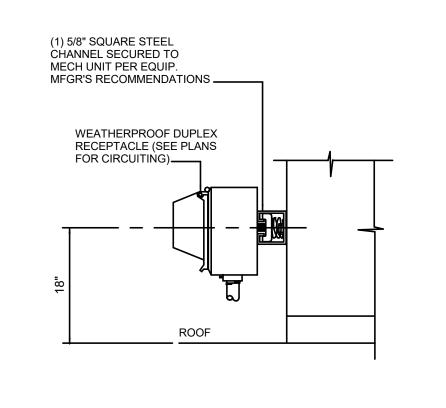


RECEPTACLE MOUNTING
ON ROOF DETAIL
NO SCALE

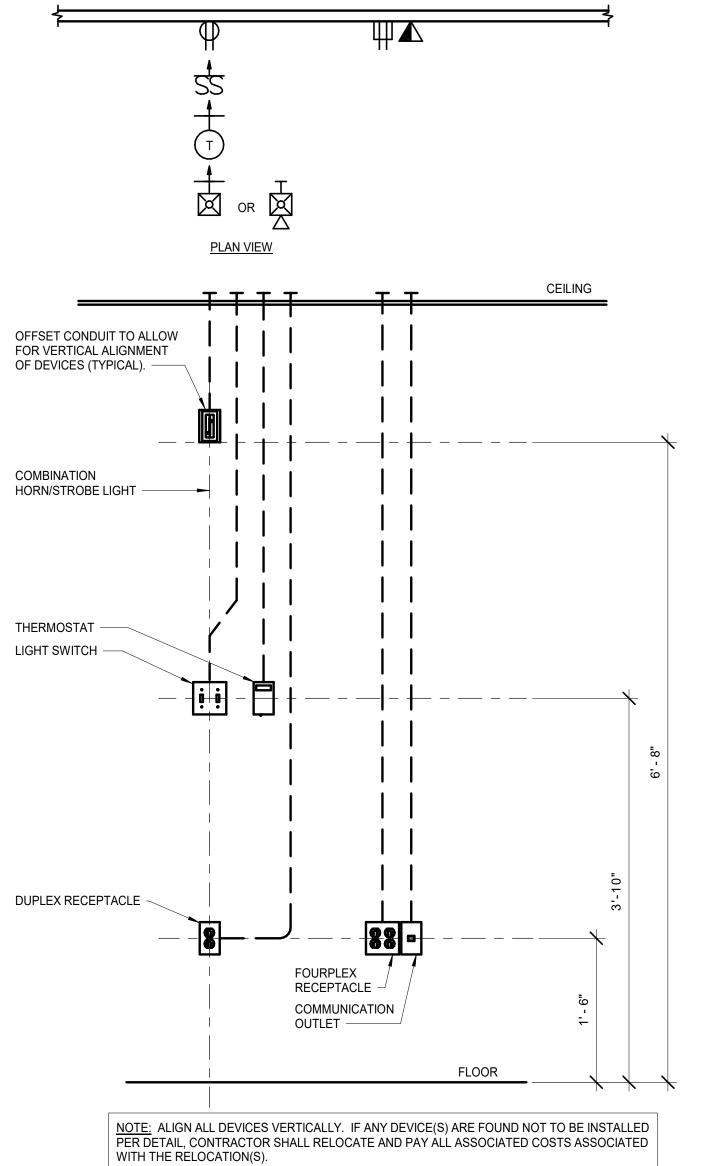


TYPICAL WALL MOUNTING DEVICE DETAIL

NOT TO SCALE

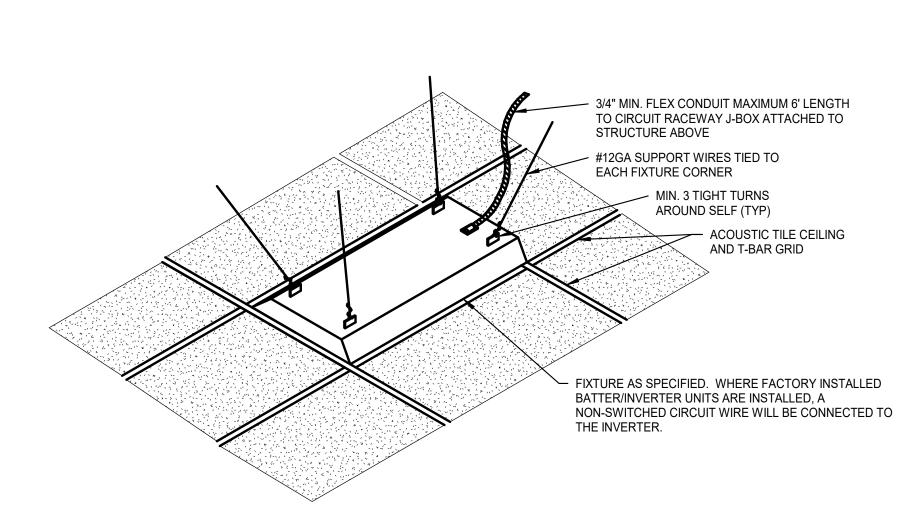

LIGHT FIXTURE MOUNTING AND BRACING DETAIL NOT TO SCALE

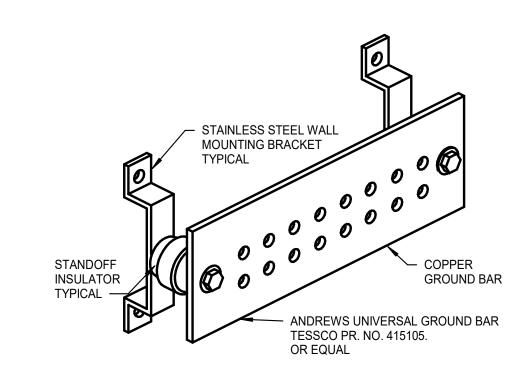

GROUND BAR DETAIL







924 FRANCIS ST. ST. JOSEPH, MO 64501 P: 816-233-8003 F: 816-233-7793 www.ellison-auxier.com

NO. ISSUE DESCRIPTION DAT
3 ADDENDUM #3 05.23.202

NO. REVISION DESCRIPTION DATE

STERN STATE

MISSOURI WESTERI UNIVERSITY FB24-001 CTAC BUILDING 4525 DOWNS DRIVE ST. JOSEPH, MO 64507

ELECTRICAL DETAILS

SHEET: **E400**

		NEW PANELBOA BUS AMPS: 800A MAIN SIZE / TYPE: 500A VOLTS/PHASE: 208Y/				SCCR: NEMA TYPE: MOUNTING: LOCATION:		1	FULLY RATED MAI	NUFA(MFG	TYPE: CTURER: MODEL: PPTIONS:		
	CKT#	CIRCUIT DECRIPTION	СВ		LOAD	A	В	C	LOAD	ТР	CB	CIRCUIT DECRIPTION	CKT#
	0		AMPS	•	VA	VA	VA	VA	VA		AMPS		J. C. T.
	1		7		12,000	24,000			12,000		7		2
	3	SHOP AREA BUS #1	200	3	12,000	24,000	24,000		12,000	3	200	SHOP AREA BUS #2	4
	5		200	Ü	12,000	_	21,000	24,000	12,000	"	200	STOT FINE TEST	6
	7				21,350	34,590			13,240				8
\triangle	9	PANEL 1	200	3	18,430	,,,,,,,,,,,,,,,,,,,,,,,,,,,,,,,,,,,,,,,	32,360		13,930	3	150	PANEL L2	10
3	~41~	-	~~~~~~~~~~~~~~~~~~~~~~~~~~~~~~~~~~~~~~~	~~~		***************************************	·	~31,570~	10,380				12
}	13				5,400	5,400		·	₹ 0	1	20	SPARE	14
∑ A3	15	PUMP STATION	60	3	5,400		5,400		3 0	1	20	SPARE	16
}	17				5,400			5,400	₹ 0	1	20	SPARE	18
Lu	~ 19 ~	SPACEONLY		m	mom	moun	fuuuuut		0			SPACE ONLY	20
	21	SPACE ONLY			0		0		0			SPACE ONLY	22
	23	SPACE ONLY			0			0	0			SPACE ONLY	24
	25	SPACE ONLY			0	0			0			SPACE ONLY	26
	27	SPACE ONLY			0		0		0			SPACE ONLY	28
	29	SPACE ONLY			0		,	0	0			SPACE ONLY	30
	31	SPACE ONLY			0	0			0			SPACE ONLY	32
	33	SPACE ONLY			0		0		0			SPACE ONLY	34
	35	SPACE ONLY			0		, <u> </u>	0	0			SPACE ONLY	36
	37	SPACE ONLY			0	0			0			SPACE ONLY	38
	39	SPACE ONLY			0		0		0			SPACE ONLY	40
	41	SPACE ONLY			0			0	0			SPACE ONLY	42
			PER PHASE (CONI	NECTED - VA	63,990	61,760	60,970				TOTAL CONNECTED - VA 186,720	
			PER PHASE CON	NNE	CTED - AMPS	533	515	508				TOTAL CONNECTED - AMPS 518	
		NOTES:										TOTAL DEMAND - VA 160,178	
												NEC TOTAL DEMAND - AMPS 445	
		*REFER TO THE BRANCH CIRCUIT C	CODDED CONDUICTO	7 P A				PDANCII		1004.6	ND 1 E00		

	BUS AMPS: 800A					PER STUDY	F	ULLY RATED			DISTRIBUTION PANELBOARD		
	MAIN SIZE / TYPE: 500A				NEMA TYPE:			MAI		CTURER:			
	VOLTS/PHASE: 208Y/12	0V, 3PH, 4W			MOUNTING:					MODEL:			
					LOCATION:				C	PTIONS:			
CKT#	CIRCUIT DECRIPTION	СВ	P	LOAD	Α	В	С	LOAD	Р	СВ	CIRCUIT DECRIPTION		CKT
		AMPS		VA	VA	VA	VA	VA		AMPS			
1				6,900	13,800			6,900					2
3	PANEL L3	150	3	6,540		12,900		6,360	3	150	PANEL L4		4
5				6,360			12,720	6,360					6
7				14,200	26,060			11,860					8
9	PANEL L5	150	3	13,040		26,080		13,040	3	150	PANEL L6		10
11				13,660		_	25,520	11,860					12
13				0	0			0					14
15	FUTURE (OUTBLDG)	100	3	0		0		0	3		SPACE ONLY		16
~1 7 ~		mannan.	4	~~~			- white	_		~~~~		~~~~~~	~18
19	DISC. MECH. 116	60	2	2,912	5,824	5.004		2,912	2	60	DISC. MECH. 108		20
21	CDACE ONLY			2,912		5,824		2,912	4 . 4 . 4				22 ~24
	SPACE ONLY SPACE ONLY			0							SPACE ONLY		
	SPACE ONLY			0	0	0		0			SPACE ONLY		26 28
	SPACE ONLY			0	_	0	0	0			SPACE ONLY		30
	SPACE ONLY			0	0	1 L		0			SPACE ONLY		32
	SPACE ONLY			0		0		0			SPACE ONLY		34
35	SPACE ONLY			0	+		0	0			SPACE ONLY		36
	SPACE ONLY			0	0]		0			SPACE ONLY		38
	SPACE ONLY			0		0		0			SPACE ONLY		40
	SPACE ONLY			0			0	0			SPACE ONLY		42
		PER PHASE	CONN	IECTED - VA	45,684	44,804	38,240				TOTAL CONNECTED - VA	128,728	
		PER PHASE CC	NNEC	TED - AMPS	381	373	319				TOTAL CONNECTED - AMPS	357	
	NOTES:							_			TOTAL DEMAND - VA	111,188	
											NEC TOTAL DEMAND - AMPS	309	1

1	UH-1	20	1	1,500	2,790	VA	VA	1,290	2	20	AC/CU-1	
	UH-2	20	_	1,500	2,790	2,790	1	1,290		20		
	UH-3		1			2,790	2.040	· ·	2	20	AC 2 2/CH 2	
		20	1	1,500 720	2,030	1	2,810	1,310	2	20	AC-2-3/CU-2 }	~~~{
	REC; ROOF	20	1	540	2,030	540	1	~~1,310~~ 0	1	20	SPARE	
	·		1			540	720		· -	20	SPARE	1
	REC; ELEC. RM/STOR RMS	20	1	720	700	1	720	0	1	20		1
	REC; N.SIDE STORAGE RMS	20	1	720	720	4.000	7	0	1	20	SPARE	1
	REC; LOUNGE VENDING	20	1	1,000		1,000	1 000	0	1	20 20	SPARE RÉC; GEN M.RR/LOBBY/MECH.RM	1
	REC; LOUNGE VENDING	20	1	1,000	0.000	1	1,900	900	1		,	
	REC; LOUNGE CTR TOP	20	1	800	2,300	4.700	7	1,500	1	20	REC. M.RR SINK/DRYER	2
	REC; LOUNGE CTR TOP	20	1	800		1,700	4.400	900	1	20	REC; CONF ROOM	2
	REC; LOUNGE CTR TOP	20	1	800	4.700	1	1,100	300	1	20	REC; CONF ROOM TV	2
	REC; LOUNGE USB'S	20	1	900	1,700	0.000	٦	800	1	20	REC; N. DRINKING F.	2
	REC; W.RR SINK/DRYER	20	1	1,500		2,300	4.000	800	1	20	REC; S. DRINKING F.	2
	REC; GEN RR/LOBBY/IT	20	1	900		7	1,300	400	1	20	EX'S FANS 1-5	3
	REC; IT ROOM	20	1	500	800		7	300	1	20	WATER HEATERS/RECIR PUMP	3
	REC; IT ROOM	20	1	500		860		360	1	20	MOTORIZED SHADE	3
	REC; IT ROOM	30	2	1,800		1	2,800	1,000	1	20	FRONT PWR ASSIST DOORS	3
~37~			····	,	1,800		٦	0	1	20	SPARE	3
	BAS AND LC PANEL	20	1	400	}	400		0	1	20	SPARE	4
	FIRE ALARIN PANEL		_	~~1,000~~			1,000	0	1	20	SPARE	4
	REC; AI/CYBER IT ROOM	20	1	540	2,340		٦	1,800	2	30	REC; AI/CYBER IT RM CABLE TRAY	4
	REC; AI/CYBER IT ROOM	20	1	500		2,300		1,800				4
	REC; AI/CYBER IT ROOM	20	1	500		1	2,300	1,800	2	30	REC; AI/CYBER IT RM CABLE TRAY	4
	REC; AI/CYBER IT RM CABLE TRAY	20	1	360	2,160		7	1,800				5
	REC; AI/CYBER IT RM CABLE TRAY	20	1	360		2,160		1,800	2	30	REC; AI/CYBER IT RM CABLE TRAY	5
	SPARE	20	1	0		-	1,800	1,800				5
	REC; AI/CYBER TVS AI SIDE	20	1	300	1,380		7	1,080	1	20	REC; AI/CYBER	5
	REC; AI/CYBER	20	1	360		1,440		1,080	1	20	REC; AI/CYBER	5
	REC; AI/CYBER	20	1	360		-	1,440	1,080	1	20	REC; AI/CYBER	6
	REC; AI/CYBER	20	1	360	810		-	450	1	20	REC; AI/CYBER TVS CYBER SIDE	6
	REC; AI/CYBER	20	1	360		720		360	1	20	REC; AI/CYBER	6
	REC; AI/CYBER CEILING RACK	20	1	360		-	2,160	1,800	2	30	REC; AI/CYBER CEILING RACK	6
	REC; AI/CYBER CEILING RACK	20	1	360	2,160		-	1,800				6
69	REC; AI/CYBER CEILING RACK	20	1	360		1,860		1,500	2	20	REC; AI/CYBER CEILING RACK	7
71	REC; AI/CYBER CEILING RACK	20	1	360		-	1,860	1,500				7
73	REC; AI/CYBER CEILING RACK	20	1	360	360		-	0	1	20	SPARE	7
	REC; AI/CYBER CEILING RACK	20	1	360		360		0	1	20	SPARE	7
	SPACE ONLY			0		-	0	0			SPACE ONLY	7
	SPACE ONLY			0	0		-	0			SPACE ONLY	8
81	SPACE ONLY			0		0		0			SPACE ONLY	8
83	SPACE ONLY			0			0	0			SPACE ONLY	8
	Pl	ER PHASE	CON	NECTED - VA	21,350	18,430	21,190				TOTAL CONNECTED - VA 60,970	
				CTED - AMPS	178	154	177				TOTAL CONNECTED - AMPS 169	\dashv
	NOTES:			,							TOTAL DEMAND - VA 43,203	+
	110120.										NEC TOTAL DEMAND - AMPS 120	\dashv
	BHR=BREAKER HANDLE SHALL BE RED										NEO TOTAL DEMAND - AMI O 120	
	GF = GROUND FAULT CIRCUIT INTERRUPTE	:D										
				ND 00115: ::=	01711-10 0111-	T FOR 6:=:::	0.00444644	DOLUTO 55	1001 ==	. ====		
	*REFER TO THE BRANCH CIRCUIT COPPER	CONDUCT	OR A	ND CONDUIT	SIZING CHAF	KT FOR SIZIN	G BRANCH C	KCUITS OF	100A OR	LESS		

SCCR: PER STUDY

VA

7,000

VA___

6,000

1,800

MOUNTING: SURFACE

A B

NEMA TYPE: 1

LOCATION:

VA

7,000

1,500 1,500

PER PHASE CONNECTED - VA 13,240 13,930 10,380

PER PHASE CONNECTED - AMPS 110 116 87

*REFER TO THE BRANCH CIRCUIT COPPER CONDUCTOR AND CONDUIT SIZING CHART FOR SIZING BRANCH CIRCUITS OF 100A OR LESS

CB P LOAD

100 3 6,000

6,000

6,000 30 2 1,800 2,160

1,800

1,500

20 1 360 360

20 1 360 360

20 1 360

20 1 360

AMPS

SCCR: PER STUDY

AMPS VA VA VA VA AMPS

MOUNTING: SURFACE

NEMA TYPE: 1

LOCATION:

CB P LOAD A B C

FULLY RATED TYPE: BRANCH CIRCUIT PANELBOARD

FULLY RATED TYPE: BRANCH CIRCUIT PANELBOARD

0 1 20 SPARE 360 1 20 REC; CONST. TECH RM

360 1 20 REC; CONST. TECH RM

SPACE ONLY

TOTAL CONNECTED - VA 37,550

TOTAL DEMAND - VA 33,775

TOTAL CONNECTED - AMPS 104

NEC TOTAL DEMAND - AMPS 94

CIRCUIT DECRIPTION

CKT#

MANUFACTURER:

LOAD P CB

VA

1,000

MFG MODEL:

1,000 2 20 HOOD

0 1 20 SPARE

1 20 SPARE

OPTIONS:

AMPS

CIRCUIT DECRIPTION

CKT#

MANUFACTURER:

LOAD P CB

MFG MODEL:

OPTIONS:

PANELBOARD L1

VOLTS/PHASE: 208Y/120V, 3PH, 4W

BUS AMPS: 225A

BUS AMPS: 225A MAIN SIZE / TYPE: MLO

CIRCUIT DECRIPTION

7 REC; CONST. TECH RM CLG RACK

11 REC; CONST. TECH RM CLG RACK

15 REC; CONST. TECH RM CLG RACK

19 REC; CONST. TECH RM CLG RACK

23 REC; CONST. TECH RM CLG RACK

25 REC; CONST. TECH RM CLG RACK

27 REC; CONST. TECH RM CLG RACK

29 REC; CONST. TECH RM CLG RACK

31 REC; CONST. TECH RM CLG RACK

33 REC; CONST. TECH RM CLG RACK

3 DISC. SWITCH

35 SPACE ONLY

37 SPACE ONLY

39 SPACE ONLY


41 SPACE ONLY

NOTES:

VOLTS/PHASE: 208Y/120V, 3PH, 4W

MAIN SIZE / TYPE: MLO

CIRCUIT DECRIPTION

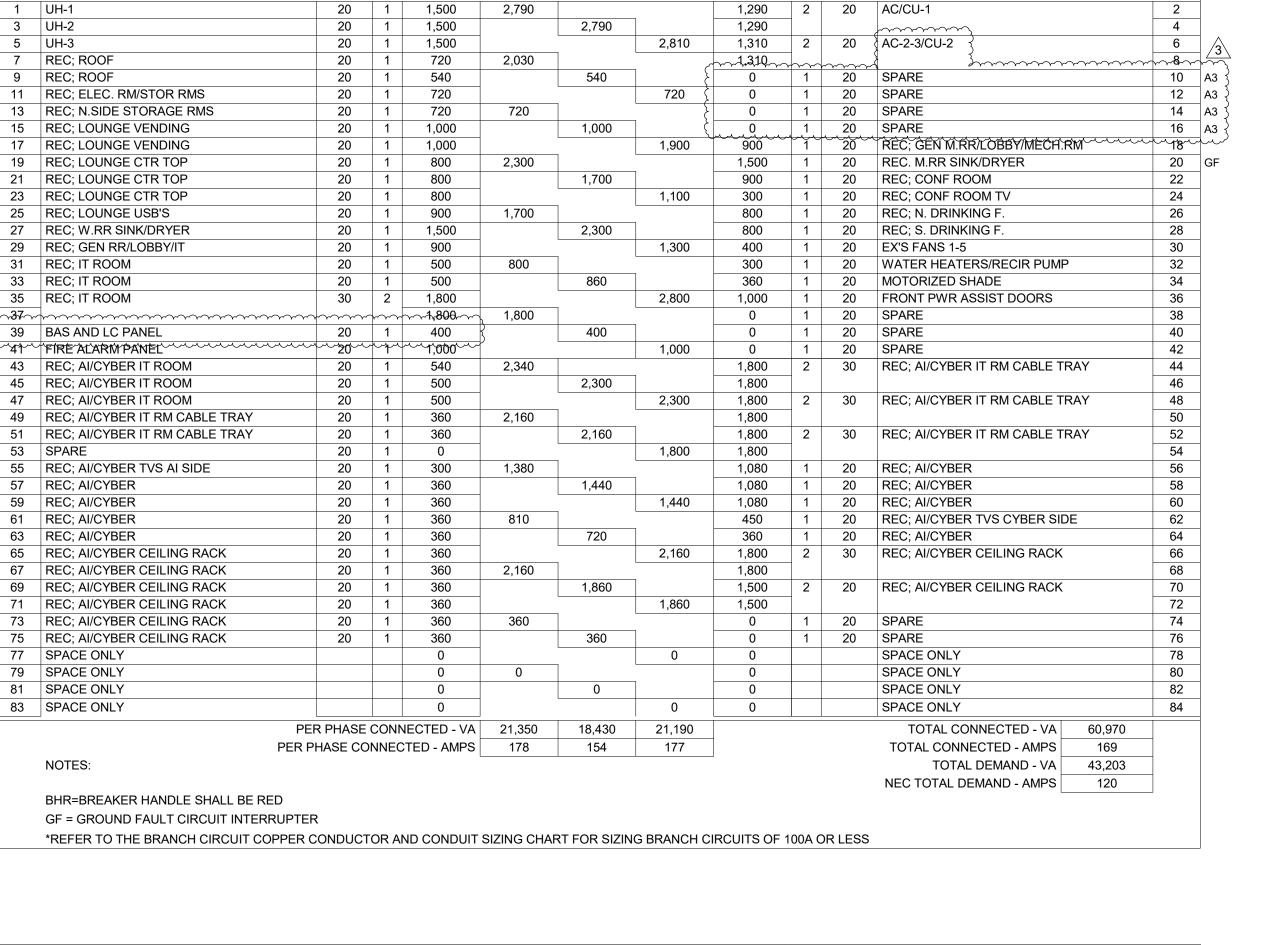





924 FRANCIS ST. ST. JOSEPH, MO 64501 P: 816-233-8003 F: 816-233-7793 www.ellison-auxier.com

CONSULTANTS

DATE NO. ISSUE DESCRIPTION 05.23.2023 3 ADDENDUM #3

NO. REVISION DESCRIPTION DATE

ELECTRICAL SCHEDULES



	BUS AMPS: 225A					PER STUDY	F	ULLY RATED			BRANCH CIRCUIT PANELBOARD	
	MAIN SIZE / TYPE: MLO				NEMA TYPE:			MAN		CTURER:		
	VOLTS/PHASE: 208Y/120	V, 3PH, 4W			MOUNTING:	SURFACE				MODEL:		
					LOCATION:					OPTIONS:		
KT#	CIRCUIT DECRIPTION	СВ	Р	LOAD	Α	В	С	LOAD	Р	СВ	CIRCUIT DECRIPTION	CKT
		AMPS		VA	VA	VA	VA	VA		AMPS		
1	REC; SHOP AREA S.WALL	20	1	540	6,540			6,000				2
3	REC; SHOP AREA S.WALL	20	1	540		6,540]	6,000	3	100	DISC. SWITCH	4
5	REC; SHOP AREA S.WALL	20	1	360			6,360	6,000				6
7	REC; SHOP AREA S.WALL/FAN CTRL	20	1	360	360		_	0	1	20	SPARE	8
9	SPARE	20	1	0		0		0	1	20	SPARE	10
11	SPARE	20	1	0			0	0	1	20	SPARE	12
13	SPARE	20	1	0	0		_	0	1	20	SPARE	14
15	SPACE ONLY			0		0		0			SPACE ONLY	16
17	SPACE ONLY			0		•	0	0			SPACE ONLY	18
19	SPACE ONLY			0	0		•	0			SPACE ONLY	20
21	SPACE ONLY			0		0		0			SPACE ONLY	22
23	SPACE ONLY			0		,	0	0			SPACE ONLY	24
25	SPACE ONLY			0	0	_	•	0			SPACE ONLY	26
27	SPACE ONLY			0		0		0			SPACE ONLY	28
29	SPACE ONLY			0		1	0	0			SPACE ONLY	30
31	SPACE ONLY			0	0		1	0	-		SPACE ONLY	32
33	SPACE ONLY			0		0		0	-		SPACE ONLY	34
35	SPACE ONLY			0		1	0	0			SPACE ONLY	36
37	SPACE ONLY			0	0	0	1	0			SPACE ONLY	38
39	SPACE ONLY			0		0		0	-		SPACE ONLY	40
41	SPACE ONLY			0			0	0			SPACE ONLY	42
		PER PHASE			6,900	6,540	6,360				TOTAL CONNECTED - VA 19,800	_
	F	PER PHASE CO	NNEC	CTED - AMPS	58	55	53	_			TOTAL CONNECTED - AMPS 55	
	NOTES:										TOTAL DEMAND - VA 19,800	
											NEC TOTAL DEMAND - AMPS 55	1

	BUS AMPS: 225A MAIN SIZE / TYPE: MLO VOLTS/PHASE: 208Y				SCCR: NEMA TYPE: MOUNTING:		F	ULLY RATED MAN	NUFA	TYPE: CTURER: : MODEL:	BRANCH CIRCUIT PANELBOARD	
	VOLTS/ITIAGE. 2001	/120V, 31 11, 4VV			LOCATION:	JOIN ACL			_	PTIONS:		
CKT#	CIRCUIT DECRIPTION	СВ	Р	LOAD	А	В	С	LOAD	Р	СВ	CIRCUIT DECRIPTION	CKT #
		AMPS		VA	VA	VA	VA	VA		AMPS		
1	REC; MANUF. TECH	20	1	540	6,540			6,000				2
3	REC; MANUF. TECH	20	1	360		6,360]	6,000	3	100	DISC. SWITCH	4
5	REC; MANUF. TECH	20	1	540	'		6,540	6,000	1			6
7	REC; MANUF. TECH	20	1	540	2,340			1,800	2	30	REC; MANUF. TECH	8
9	REC; MANUF. TECH	20	1	360		2,160		1,800	1			10
11	SPARE	20	1	0			1,800	1,800	2	30	REC; MANUF. TECH	12
13	SPARE	20	1	0	1,800			1,800	1			14
15	REC; MANUF. TECH CLG RACK	20	1	360		2,160		1,800	2	30	REC; MANUF. TECH CLG RACK	16
	REC; MANUF. TECH CLG RACK	20	1	360			2,160	1,800				18
	REC; MANUF. TECH CLG RACK	20	1	360	1,360		_	1,000	2	20	REC; MANUF. TECH CLG RACK	20
	REC; MANUF. TECH CLG RACK	20	1	360		1,360		1,000				22
	REC; MANUF. TECH CLG RACK	20	1	360			2,160	1,800	2	30	REC; MANUF. TECH CLG RACK	24
	REC; MANUF. TECH CLG RACK	20	1	360	2,160		_	1,800				26
	SPARE	20	1	0		1,000		1,000	2	20	REC; MANUF. TECH CLG RACK	28
	SPARE	20	1	0			1,000	1,000				30
	SPACE ONLY			0	0		-	0			SPACE ONLY	32
	SPACE ONLY			0		0		0			SPACE ONLY	34
35	SPACE ONLY			0		•	0	0			SPACE ONLY	36
37	SPACE ONLY			0	0		•	0			SPACE ONLY	38
	SPACE ONLY			0		0		0			SPACE ONLY	40
41	SPACE ONLY			0			0	0			SPACE ONLY	42
		PER PHASE	CONN	NECTED - VA	14,200	13,040	13,660				TOTAL CONNECTED - VA 40,900	
		PER PHASE CO	NNEC	TED - AMPS	118	109	114	1			TOTAL CONNECTED - AMPS 114	7
	NOTES:			•	·		•	•			TOTAL DEMAND - VA 34,450	7
											NEC TOTAL DEMAND - AMPS 96	7

					-:				\(\frac{\sqrt{3}}{\cdot\}\)	~~~~~~	~~~~~~~~~~~~~~~~~~~~~~~~~~~~~~~~~~~~~~	,,,,,,,,,,,,,,,,,,,,,,,,,,,,,,,,,,,,,,	~~~~~~~	~~~~~~~~~~~~~~~~~~~~~~~~~~~~~~~~~~~~~~	~~~~~
	SCCR: NEMA TYPE:	PER STUDY	' F	ULLY RATED MAI		TYPE	BRANCH CIRCUIT PANELBOARD			BRANC	CH CIRCUIT (COPPER CO	ONDUCTOR	<u> </u>	
	MOUNTING: LOCATION:				MF	G MODEL	:		}	A	AND CONDUI	T SIZING C	HART*		
LOAD VA	A VA	B VA	C VA	LOAD VA	Р	CB AMPS	CIRCUIT DECRIPTION	CKT#	OVERCURRENT PROTECTION DEVICE	REQUIRED CONDUCTOR	EQUIPMENT GROUNDING	SINGLE PHASE 2 WIRE + GND.	SINGLE PHASE 3 WIRE + GND.	THREE PHASE 3 WIRE + GND.	THREE PHAS WIRE + GNE
540	6,540		_	6,000				2	RATING (AMPS)	SIZE	CONDUCTOR SIZE	CONDUIT SIZE	CONDUIT SIZE	CONDUIT SIZE	CONDUIT SIZ
360	_	6,360	0.540	6,000	3	100	DISC. SWITCH	4	5 15	12 AWG	12 AWG	3/4"	3/4"	3/4"	3/4"
540 540	2,340	1	6,540	6,000 1,800	1 2	30	REC; MANUF. TECH	6 8	20	12 AWG	12 AWG	3/4"	3/4"	3/4"	3/4"
360	2,010	2,160	7	1,800	┪		1120, 110 1101 1 12011	10	25	10 AWG	10 AWG	3/4"	3/4"	3/4"	3/4"
0		_	1,800	1,800	2	30	REC; MANUF. TECH	12	30	10 AWG	10 AWG	3/4"	3/4"	3/4"	3/4"
0	1,800		_	1,800				14	{						
360	4	2,160	0.400	1,800	2	30	REC; MANUF. TECH CLG RACK	16	{ 35	8 AWG	10 AWG	3/4"	3/4"	3/4"	3/4"
360 360	1,360	1	2,160	1,800 1,000	2	20	REC; MANUF. TECH CLG RACK	18 20	{ 40	8 AWG	10 AWG	3/4"	3/4"	3/4"	3/4"
360	1,300	1,360	1	1,000	┤	20	INEC, MANOT: TECH CEG NACK	22	4 5	6 AWG	10 AWG	3/4"	3/4"	3/4"	1"
360	†	.,,,,,,	2,160	1,800	2	30	REC; MANUF. TECH CLG RACK	24	50	6 AWG	10 AWG	3/4"	3/4"	3/4"	1"
360	2,160		_	1,800				26	60	4 AWG	10 AWG	1"	1"	1"	1-1/4"
0	1	1,000		1,000	2	20	REC; MANUF. TECH CLG RACK	28	ξ <u>70</u>	4 AWG	8 AWG	1"	1"	1"	1-1/4"
0	0	٦	1,000	1,000	+		SPACE ONLY	30	80			1"	4 4/4"	'	1-1/4"
0	1 0	0	7	0	+	 	SPACE ONLY	34	}	3 AWG	8 AWG	l	1-1/4"	1-1/4"	·
0	1		0	0	+	+	SPACE ONLY	36	} <u>90</u>	2 AWG	8 AWG	1"	1-1/4"	1-1/4"	1-1/4"
0	0	1		0	+	<u> </u>	SPACE ONLY	38	100	1 AWG	8 AWG	1-1/4"	1-1/2"	1-1/2"	1-1/2"
0		0	7	0			SPACE ONLY	40	*						
0	1	•	0	0			SPACE ONLY	42	* = UNLESS OTHER						
TED - VA	14,200	13,040	13,660			-	TOTAL CONNECTED - VA 40,900		* = UNLESS OTHER	WISE NOTED ON T	HE DRAWINGS, ALL BRAI	NCH CIRCUITS AND FE	EDERS TO BE PROV	IDED WITH A NEUTI	RAL WIRE.
D - AMPS	118	109	114				TOTAL CONNECTED - AMPS 114				POWER RISER DIAGRAM CEWAY OR CABLE. COND				
							TOTAL DEMAND - VA 34,450 NEC TOTAL DEMAND - AMPS 96	\exists			ACEWAY OR CABLE.				2 1 31 OI
									}						

	CH CIRCUIT (<u>Z</u>		ALAN W. LANKFORD NUMBER E-24224 05.23.2023
REQUIRED CONDUCTOR SIZE	EQUIPMENT GROUNDING CONDUCTOR SIZE	SINGLE PHASE 2 WIRE + GND. CONDUIT SIZE	SINGLE PHASE 3 WIRE + GND. CONDUIT SIZE	THREE PHASE 3 WIRE + GND. CONDUIT SIZE	THREE PHASE 4 WIRE + GND. CONDUIT SIZE	
12 AWG	12 AWG	3/4"	3/4"	3/4"	3/4"	



924 FRANCIS ST. ST. JOSEPH, MO 64501 P: 816-233-8003 F: 816-233-7793

www.ellis	on-auxier.com
CONSULTANTS	

	BUS AMPS: 225A MAIN SIZE / TYPE: MLO				SCCR: NEMA TYPE:	PER STUDY 1	F	ULLY RATED MAI		:TYPE :CTURER	BRANCH CIRCUIT PANELBOARD	
	VOLTS/PHASE: 208Y/120V, 3P	H. 4W			MOUNTING:					MODEL:		
		,			LOCATION:					OPTIONS:		
CKT#	CIRCUIT DECRIPTION	СВ	Р	LOAD	А	В	С	LOAD	Р	СВ	CIRCUIT DECRIPTION	CKT#
$\sim\sim$	~~~~~~~~~~~~~~~~~~~~~~~~~~~~~~~~~~~~~~~	AMPS	~~	$\sim\sim$ \sqrt{A}	~~~XX~~~~	~~~VA~~~~	$\sim\sim$	~~~QQ~~~	+	AMPS		\sim
1	SPARE	20	1	0	6,000			6,000	İ	Ì		2
3	REC; INDUST. TECH	20	1	360	,	6,360		6,000	3	100	DISC. SWITCH	4
5	REC; INDUST. TECH	20	1	540			6,540	6,000	1			6
7	REC; INDUST. TECH	20	1	540	2,340] '		1,800	2	30	REC; INDUST. TECH	8
9	REC; INDUST. TECH	20	1	360		2,160		1,800	1			10
11	REC; INDUST. TECH	20	1	0			0	0	1	20	SPARE	12
13	REC; INDUST. TECH	20	1	0	0			0	1	20	SPARE	14
15	REC; INDUSTR. TECH CLG RACK	20	1	360		2,160		1,800	2	30	REC; INDUST. TECH CLG RACK	16
17	REC; INDUSTR. TECH CLG RACK	20	1	360			2,160	1,800				18
19	REC; INDUSTR. TECH CLG RACK	20	1	360	1,360		•	1,000	2	20	REC; INDUST. TECH CLG RACK	20
21	REC; INDUSTR. TECH CLG RACK	20	1	360		1,360		1,000				22
23	REC; INDUSTR. TECH CLG RACK	20	1	360		_	2,160	1,800	_ 2	30	REC; INDUST. TECH CLG RACK	24
25	REC; INDUSTR. TECH CLG RACK	20	1	360	2,160		•	1,800				26
27	SPARE	20	1	0		1,000		1,000	2	20	REC; INDUST. TECH CLG RACK	28
29	SPARE	20	1	0			1,000	1,000	1			30
	SPACEONLY	······	~~~	moun	and the same	 	ı				SPACEONLY	_
33	SPACE ONLY			0		0		0			SPACE ONLY	34
35	SPACE ONLY			0		,	0	0	1		SPACE ONLY	36
	SPACE ONLY			0	0		1	0	-		SPACE ONLY	38
39	SPACE ONLY			0		0		0		-	SPACE ONLY	40
41	SPACE ONLY			0			0	0			SPACE ONLY	42
	PE	R PHASE	CON	NECTED - VA	11,860	13,040	11,860				TOTAL CONNECTED - VA 36,760	
	PER P	HASE CO	NNEC	CTED - AMPS	99	109	99				TOTAL CONNECTED - AMPS 102	
	NOTES:							-			TOTAL DEMAND - VA 32,380	
											NEC TOTAL DEMAND - AMPS 90	

REC REC SPA SPA SPA SPA SPA SPA	C; SHOP AREA N.WALL C; SHOP AREA N.WALL C; SHOP AREA N.WALL C; SHOP AREA N.WALL ARE ARE ARE ACE ONLY	20 20 20 20 20 20 20 20	1 1 1 1 1	540 360 360 360 0 0	6,540 360	6,360	6,360	6,000 6,000 6,000 0	3 1 1	100 20 20	DISC. SWITCH SPARE SPARE	
REC SPA SPA SPA SPA SPA SPA	C; SHOP AREA N.WALL C; SHOP AREA N.WALL ARE ARE ARE ACE ONLY	20 20 20 20	1	360 360 0 0	360			6,000 0	1	20	SPARE	
REC SPA SPA SPA SPA SPA	C; SHOP AREA N.WALL ARE ARE ARE ACE ONLY	20 20 20	1	360 0 0	360	0		0	_			
SPA SPA SPA SPA SPA	ARE ARE ARE ACE ONLY	20 20		0	360	0			_			
SPA SPA SPA SPA	ARE ARE ACE ONLY	20	1 1 1	0		0		0	1	20	CDADE	_
SPA SPA SPA SPA	ARE ACE ONLY		1				_			20	SPARE	
SPA SPA SPA	ACE ONLY	20	1	^			0	0	1	20	SPARE	
SPA				U	0]		0	1	20	SPARE	
SPA	ACE ONLY			0		0		0			SPACE ONLY	
	ACE ONLY			0			0	0			SPACE ONLY	
	ACE ONLY			0	0			0			SPACE ONLY	
SPA	ACE ONLY			0		0		0			SPACE ONLY	
	ACE ONLY			0			0	0			SPACE ONLY	
SPA	ACE ONLY			0	0		_	0			SPACE ONLY	
' SPA	ACE ONLY			0		0		0			SPACE ONLY	
SPA	ACE ONLY			0			0	0			SPACE ONLY	
	ACE ONLY			0	0			0			SPACE ONLY	
SPA	ACE ONLY			0		0		0			SPACE ONLY	
SPA	ACE ONLY			0			0	0			SPACE ONLY	
	ACE ONLY			0	0		_	0			SPACE ONLY	
SPA	ACE ONLY			0		0		0			SPACE ONLY	
SPA	ACE ONLY			0			0	0			SPACE ONLY	
	PEF	R PHASE (CONN	IECTED - VA	6,900	6,360	6,360				TOTAL CONNECTED - VA 19,620	
	PER PI	HASE CON	NNEC	TED - AMPS	58	53	53				TOTAL CONNECTED - AMPS 54	1
NO	DTES:			L		ı		J			TOTAL DEMAND - VA 19,620	7
											NEC TOTAL DEMAND - AMPS 54	┪
											NEO TOTAL BEIMAND ANN O	

SCCR: PER STUDY

NEMA TYPE: 1

LOCATION:

Α

LOAD

MOUNTING: SURFACE

	ZONE/		TYPE OF	LAMP	LOAD	VOLT.			LOAD		ZONE/	1	TYPE OF	LAMP	LOAD	VOLT.			LOAD
NOTE	CRT#	DESCRIPTION	CONTROLS	SOURCE	TYPE		Р	AMP	WATTS	NOTE	CRT#	DESCRIPTION	CONTROLS	SOURCE	TYPE		Р	AMP	WATT
1	1	MANUF. TECH.	0-10V DIM	LED	NORM	277	1	20	512	3	2	SHOP AREA	0-10V DIM	LED	NORM	277	1	20	1068
2	3	INDUSTRIAL TECH.	0-10V DIM	LED	NORM	277	1	20	512	3	4	SHOP AREA	0-10V DIM	LED	NORM	277	1	20	1068
2	5	CONSTR. TECH	0-10V DIM	LED	NORM	277	1	20	512	1,4	6	AI/CYBER	0-10V DIM	LED	NORM	277	1	20	256
1	7	LOBBY	ON/OFF	LED	NORM	277	1	20	542	1,4	8	AI/CYBER	0-10V DIM	LED	NORM		1	20	256
	9	SPARE		-	-	277	1	20			10	SPACE / PROVISION		-	-				
	11	SPACE / PROVISION		-	-						12	SPACE / PROVISION		-	-				
	13	SPACE / PROVISION		-	-						14	SPACE / PROVISION		-	-				
5	15	RR EXH. FANS	ON/OFF	-	NORM	120	1	20	160		16	SPACE / PROVISION		_	_				

FULLY RATED TYPE: BRANCH CIRCUIT PANELBOARD

CIRCUIT DECRIPTION

MANUFACTURER:

MFG MODEL:

OPTIONS:

1 SINGLE POINT ENTRY DIMMING CONTROLLER. 2 TWO POINT ENTRY DIMMING CONTROLLER.

NEW PANELBOARD L4

MAIN SIZE / TYPE: MLO

CIRCUIT DECRIPTION

BUS AMPS: 225A

VOLTS/PHASE: 208Y/120V, 3PH, 4W

- 3 THREE POINT ENTRY CONTROLLER WITH TWO ZONES IN EACH LOCATION.
- 4 PROVIDE SECOND CONTROLLER AT TEACHER LOCATION.

- A: PROGRAM FOR BUILDING WIDE SWEEP TO TURN LIGHTS OFF. LIGHTS SHALL FLASH ONCE TO INDICATE LIGHTS SHALL TURN OFF IN 5 MINS. IF BUTTON IS NOT PRESSED, AFTER HOURS DEFAULT TO BE SET FOR 1 HOUR SWEEPS.
- ZONE 15 SHALL TURN OFF WHEN ALL LIGHTS HAVE BEEN TURNED OFF.
- B: PROVIDE CONTROLS AND WIRING PER MANUFACTURERS INSTALLATION INSTRUCTIONS LVD = LOW VOLTAGE DIMMER (0-10V), LV = LOW VOLTAGE SWITCH ON/OFF

TAG	DESCRIPTION	ELECTRICAL - MOTOR			ELECTRICAL - DISCONNECT SWITCH EL							ECTRICAL - GENERAL		
		SIZE HP	KW	AMPS	VOLTS/PH	SIZE	VOLTAGE RATING	NUMBER OF POLES	NEMA TYPE	MOCP (NOTE 2)	NOTE 1	NEUTRAL WIRE	FEED BY PANEL	NOTES
EQUIPMENT	•			•	•	<u> </u>		•	•			•		•
RTU-1	ROOF TOP EQUIPMENT	-			480/3					25	23/23/26	N	MDP	
RTU-2	ROOF TOP EQUIPMENT	-			480/3					25	23/23/26	N	MDP	
RTU-3	ROOF TOP EQUIPMENT	-			480/3					50	23/23/26	N	MDP	4
RTU-4	ROOF TOP EQUIPMENT	-			480/3					25	23/23/26	N	MDP	4
RTU-5	ROOF TOP EQUIPMENT	-			480/3					50	23/23/26	N	MDP	
RTU-6	ROOF TOP EQUIPMENT	-			480/3					25	23/23/26	N	MDP	
RTU-7	ROOF TOP EQUIPMENT	-			480/3					25	23/23/26	N	MDP	
CU-1	HEAT PUMP			12.2	208/1	30	250	2	3R	20	26/26/26	N	L1	3,5
AC-1	WALL MOUNTED AC		-	0.2	208/1	20	250	2	 	20	26/26/26	Y	L1	3,5
		-	-		 	_			1					
CU-2	HEAT PUMP		-	12.2	208/1	30 20	250	2	3R	20	26/26/26	N Y	<u>L1</u>	3,5
AC-2	WALL MOUNTED AC		-	0.2	208/1		250	<u> </u>	1	20	26/26/26	Y	<u>L1</u>	3,5
AC-3	WALL MOUNTED AC		-	0.2	208/1	20	250	2	1	20	26/26/26	Y	L1	3,5
UH-1	UNIT HEATER	-	1.5	24.1	120	20	250	1	1	20	26/26/26	Y	L1	3
UH-2	UNIT HEATER	-	1.5	24.1	120	20	250	1	1	20	26/26/26	Y	L1	3
CF-1	CIRCULATION FAN	3/4	-	1.4	480/3	30	600	3	1	15	23/23/26	Y	H1	3, 7
CF-1	CIRCULATION FAN	3/4	-	1.4	480/3	30	600	3	1	15	23/23/26	Y	H1	3,7
EF-1	EXHAUST FAN	-	-	1.5	120/1	-	250	1	1	20	23/23/28	Y	L1	3, 6, 8
EF-2	EXHAUST FAN	-	-	1.5	120/1	-	250	1	1	20	23/23/28	Υ	L1	3, 6, 8
EF-3	EXHAUST FAN	-	-	1.5	120/1	-	250	1	1	20	23/23/28	Υ	L1	3, 6, 9
EF-4	EXHAUST FAN	-	-	1.5	120/1	-	250	1	1	20	23/23/28	Υ	L1	3, 6, 9
EF-5	EXHAUST FAN	-	-	1.5	120/1	-	250	1	1	20	23/23/28	Y	L1	3, 6, 9
DWH-1	DOMETIC WATER HEATER	-	-	-	120	20	250	1	1	20	26/26/26	Y	L1	-
DWH-2	DOMETIC WATER HEATER	-	-	-	120	20	250	1	1	20	26/26/26	Y	L1	
RCP-1	RECIRCULATION PUMP			_	120	20	250	1	1	20	26/26/26	Y	L1	

22 = PLUMBING CONTRACTOR.

 $\frac{\sqrt{2}}{\sqrt{2}}$

ELECTRICAL NOTES:

- X = FURNISHED BY DIVISION (22, 23 OR 26)
- Y = INSTALLED BY DIVISION (22, 23 OR 26)
- 23 = MECHANICAL CONTRACTOR. Z = CONNECTED BY DIVISION (22, 23 OR 26) 26 = ELECTRICAL CONTRACTOR.
- E2. MAXIMUM OVERCURRENT PROTECTION FUSE OR HVACR CIRCUIT BREAKER PER MANUFACTURER'S LABEL.
- E3. PROVIDE DISCONNECT MOUNTED TO OR NEXT TO THE UNIT. E4. PROVIDE DUCT MOUNTED SMOKE DETECTORS IN THE SUPPLY AND RETURN AIR.
- E5. PACKAGED UNIT, POWER FED TO CONDENSER AND BACK TO MATCHING HEAT PUMP.
- E6. TOGGLE DISCONNECT SWITCH, HP RATED.
- E7. PROVIDE CONDUIT BACK TO THE CONTROLLER AND 120V CIRCUIT FROM PANEL L3
- E8. FAN FOR RESTROOM CONTROLLED BY LIGHTING CONTROL SYSTEM FOR ON/OFF CONTROL. E9. FAN PROVIDED WITH RATE OF RAISE THERMOSTAT BY M.C. INSTALLED BY E.C.

DATE NO. ISSUE DESCRIPTION 05.23.2023 3 ADDENDUM #3 NO. REVISION DESCRIPTION DATE

ELECTRICAL SCHEDULES

SHEET:

TYPE	MANUFACTURER	LAMPS	WATTS VOLTS	DIMMING PROTOCOL	DESCRIPTION			
Α	EiKO - VOL SERIES	LED	VOLIS	PROTOCOL	2X2 RECESSED LED TROFER, WHITE TRIM, CENTER DROP-DOWN DIFFUSER			
A	VOL22-PS40-840-U	4000K	26	ON/OFF/DIM	PROVIDE 0-10V DIMMING IN CONR. ROOM			
	(NO EQUALS)	400010	277	PER DWG				
	(,,,,,,,,,,,,,,,,,,,,,,,,,,,,,,,,,,,,,,			~~~~~~~	$\frac{\sqrt{3}}{}$			
В	EIKO LIGHTING	LED			4' LED STRIP FIXTURE, WHITE HOUSING, ROUND LENS.			
}	STR-4-PS45-840-U-D	4000K	45	NO	SUSPENDED FROM STRUCTURE WITH AIR-CRAFT CABLES.			
	(NO EQUALS)		277	ON/OFF	_			
	-							
c }	EiKO LIGHTING	LED			8' LED STRIP FIXTURE, WHITE HOUSING, ROUND LENS.			
(STR-8-PS90-840-U-D	4000K	90	YES	SUSPENDED FROM STRUCTURE WITH AIR-CRAFT CABLES.			
ζ	(NO EQUALS)		277	0-10V	}			
	FIXO LIQUENIO	1.50			AVOLED LINEAR LIGHTAN FIVELING MULTE LIGHTANIA FLAT LENG			
D }	EIKO LIGHTING	LED	400	\/=0	1X2' LED LINEAR HIGH BAY FIXTURE, WHITE HOUSING, FLAT LENS			
	LLH-1E-130W-840-U-D-12391	4000K	130	YES	_ SUSPENDED FROM STRUCTURE			
	NO EQUALS)		277	0-10V				
\ E1	COPPER LIGHTING	- IFD	······································		LOW PROFILE EMERGENCY LIGHT, WHITE HOUSING, TWO HEADS			
_'	APEL-MINI		1.5	NO	25			
	(OR EQUAL)		277	-				
	,							
E2	COPPER LIGHTING	LED			EMERGENCY LIGHT, WHITE HOUSING, THREE HEADS			
	ATLE-MINI-3H		3	NO				
	(OR EQUAL)		277	-				
F	SPI LIGHTING - PAVO 4"	LED			4" DIA, 4' TALL DIA CYLINDER WITH BOTTOM 45-DEGREE OPTIC, MATTE ACRYLIC DIFFUSER,			
	SIP12125-4FT-CYL-LED-LOW	4000K	26	NO	POWER SUPPLY CANOPY WITH CORD SUSPENSION, AC1 TOP ACCENT			
	(OR EQUAL)		277	-	FOR AC1 OPTION PANIT MWSU GOLD.			
		1.50			AUDIA GITALI DIA OMINDED MITU DOTTOMAS DEODES ODTIO MATTE AODMI IO DISSUOSD			
G	SPI LIGHTING - PAVO 4" SIP12125-2FT-CYL-LED-LOW	LED 4000K	11	NO	4" DIA, 2' TALL DIA CYLINDER WITH BOTTOM 45-DEGREE OPTIC, MATTE ACRYLIC DIFFUSER,			
	(OR EQUAL)	4000K	<u>11</u> 277	NO	POWER SUPPLY CANOPY WITH CORD SUSPENSION, AC1 TOP ACCENT FOR AC1 OPTION PANIT MWSU GOLD.			
	(OR EQUAL)		211	-	TORACTOL HONT AND MINOUS GOLD.			
X1	SURE-LITES	LED			LED EXIT SIGN, WHITE HOUSING, RED LETTERS, 2-ADJUSTABLE EM. HEADS.			
	APC-H-7-R-SQ		3	NO				
	(OR EQUAL)		277	-				
XE	SURE-LITES	LED			WIRED AND POWERED FROM TYPE X1 FIXTURE.			
	SRM-M-13-S-BK			NO	_			
	(OR EQUAL)		-	-				
TERIOR								
ET1	SPI-LIGHTING	LED			2" DIA SURFACE MOUNTED LIGHT FIXTURE, MOUNTED VERTICAL, FROSTED			
	PAVO 2" - 3FT-L10W-UNV-40K-	4000K	10	NO	HOUSING (MOUNT POWER SUPPLY WITHIN MECH/IT ROOM AT 10' AFF)			
	MA01-MCS-W-AC1		277	PHOTO-CELL	FOR AC1 OPTION PANIT MWSU GOLD.			
((OREQUAL)		· · · · · · · · · · · · · · · · · · ·	^^^^				
ET2 (EIKO LIGHTING	LED	10	110	3" DIA CYLINDER, MOUNTED IN THE DOWN POSITION, (BRONZE)			
(CWSP-SA-10W-8CCT-UNV-X	4000K	10 	NO PHOTO-CELL	-			
((NO EQUALS)		211	PHOTO-CELL	₹			
ET3	EIKO LIGHTING	LED			LOW PROFILE EXTERIOR WALL PACK, BRONZE FINISH			
EI3	WPA-PS35/8CCT/HD	4000K	35	NO	}			
	(NO EQUALS)		277	PHOTO-CELL	-			
(, , , , , , , , , , , , , , , , , , ,				}			
ET4	EIKO LIGHTING	LED			LOW PROFILE EXTERIOR WALL PACK, BRONZE FINISH			
	WPA-PS75/8CCT/HD	4000K	75	NO	_			
	(NO EQUALS)		277	PHOTO-CELL	₹			
(be the second se		<u> </u>		<u></u>			
ST1	COOPER LIGHTING - GALLEON	LED			AREA SITE LED LIGHT FIXTURE, BRONZE FINISH, PHOTOCELL			
	NO.GLAN-SA1C-740-U-TE3-X-BZ	4000K	57	NO	INSTALL ON AN 18' TALL POLE, COOPER LTG NO.SSA.4.M.18.C.X.1			
	HSS-PR (OR EQUAL)		277	PHOTO-CELL				

SPECIFIC NOTES:

SUBSTITUTION NOTES:

THE LIGHTING DESIGN FOR THIS PROJECT IS BASED UPON THE MANUFACTURERS SPECIFIED. IF AN ADDITIONAL SUBSTITUTION IS DESIRED BY THE CONTRACTOR, A SUBSTITUTION REQUEST SUBMITTAL MUST BE PROVIDED AS FOLLOWS:


- S1. SUBSTITUTION REQUEST MUST BE RECEIVED BY THE ENGINEER IN WRITING 10 DAYS PRIOR TO BID. FAILURE TO SUBMIT CONSTITUTES A GUARANTEE TO SUPPLY THE SPECIFIED FIXTURES.
- S2. INFORMATION IS TO BE SUPPLIED COMPARING PHOTOMETRY, (WITH FLOOR PLANS INDICATING POINT BY POINT CALCULATIONS) DIMENSIONS, MATERIAL COMPOSITION, FINISH, VISUAL APPEARANCE AS WELL AS THE "CONTRACTOR NET" PRICING. SAMPLES ARE
- TO BE PROVIDED UPON REQUEST

S3. GREAT CARE, TIME AND EXPENSE HAVE BEEN USED TO PROVIDE OUR CLIENT WITH THE LIGHTING AND CONTROLS SYSTEM

- THEREFORE, FOR EACH AND EVERY TYPE OF FIXTURE OFFERED AS AN UNSOLICITED ALTERNATE, A \$500.00 FEE WILL BE CHARGED TO THE CONTRACTOR FOR REVIEW OF THE ALTERNATE FIXTURE. THIS CHARGE IS IN NO WAY A GUARANTEE OF APPROVAL, BUT IS SOLELY TO COMPENSATE THE ENGINEER FOR TIME SPENT VALIDATING EQUALITY AND COMPATIBILITY WITH THE PROJECT REQUIREMENTS. THIS REIMBURSEMENT MUST BE
- RECEIVED BY THE ENGINEER PRIOR TO ANY REVIEW COMMENCING.
- S4. PACKAGING OF LIGHT FIXTURES WILL NOT BE CONSIDERED OR APPROVED. S5. MANUFACTURER'S REPRESENTATIVE AGENTS SHALL BE ALLOWED TO OFFER MINI-LOT PRICING FOR SPECIFIED LIGHTING FIXTURES.
- S6. LIGHTING CONTROLS PRICING SHALL BE COMPLETELY SEPARATE OF ANY LIGHT FIXTURE PRICING. ANY LIGHTING CONTROLS PRICING THAT IS SUBMITTED WITH LIGHT FIXTURE PRICING (UNIT OR MINI-LOT) WILL BE IMMEDIATELY REJECTED IN ITS ENTIRETY.

GENERAL NOTE:

G1. ELECTRICAL CONTRACTOR SHALL VERIFY CEILING TYPE PRIOR TO ORDERING ANY LIGHT FIXTURES. G2. ELECTRICAL CONTRACTOR SHALL COORDINATE DIMMING DRIVERS/BALLASTS WITH DIMMING SWITCHES/SYSTEMS AND SHALL INCLUDE ALL REQUIRED CONTROL WIRING.

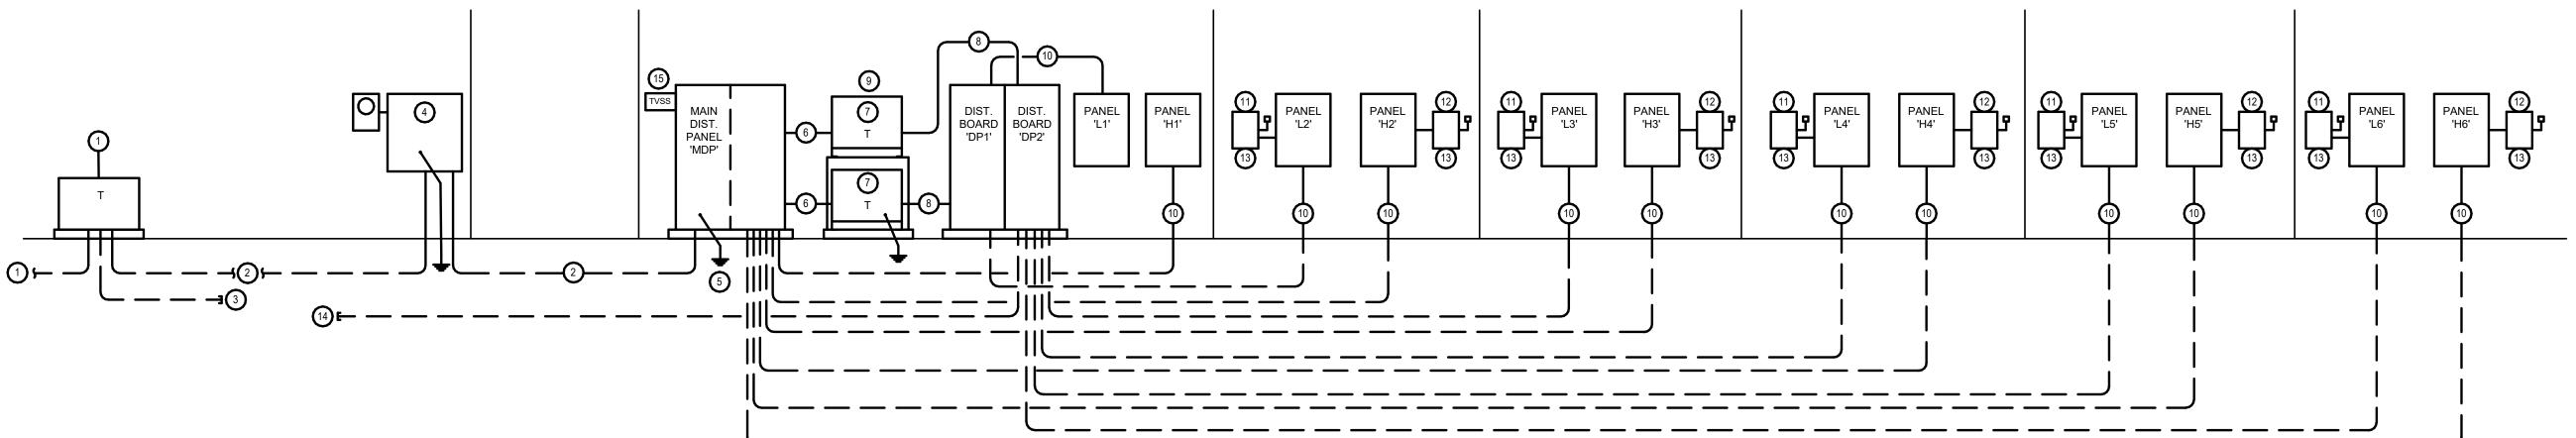

ELECTRICAL SYMBOLS

→ BRANCH CIRCUIT CONCEALED IN CEILING OR WALL, ARROWS INDICATED HOMERUNS TO PANEL, ALL CONDUCTORS ARE NOTED IN PANEL SCHEDULE - PHASE CONDUCTORS NEUTRAL CONDUCTORS - GROUND CONDUCTORS LP1-10 PANEL - BREAKER NUMBER (IDENTIFICATION) 1,3 OR 1,3,5 INDICATES X,X= 2-POLE C.B. OR X,X,X= 3-POLE C.B. HOMERUN INDICATED LIKE THIS INDICATES THREE SEPARATE CIRCUITS CONDUIT CONCEALED IN CEILING OR WALL WITH THREE CONDUCTORS: 1-PHASE, 1-NEUTRAL, 1-GROUND WIRE, MINIMUM NO.12 WIRE UNLESS OTHERWISE SPECIFIED ON PLANS - - - CONDUIT RUN UNDERGROUND OR CONCEALED IN FLOOR SLAB GROUNDING CONDUCTOR, MINIMUM NO. 12 WIRE EXCEPT AS NOTED TO OR TO OR THE EXIT SIGN, SINGLE FACED, ARROWS AS SHOW ON PLANS, SHADED SIDE(S) INDICATES FACE SIDE(S) OF EXIT EXIT SIGN, DOUBLE FACED, ARROWS AS SHOW ON DRAWING, SHADED SIDE(S) INDICATES FACE SIDE(S) OF EXIT COMBINATION EXIT SIGN/EMERGENCY LIGHTING UNIT. CEILING OR WALL MOUNTED, SHADED SIDE(S) INDICATES FACE SIDE(S) OF EXIT

OR OR CEILING OR WALL MOUNTED EMERGENCY LIGHTING UNIT WITH INTEGRAL BATTERY AND UNIT MOUNTED HEADS LIGHT FIXTURE; LETTER DENOTES FIXTURE TYPE

 $\vdash \bullet \vdash \vdash$ STRIP FIXTURE RECESSED CEILING LIGHT FIXTURE

WALL MOUNTED LIGHT FIXTURE, SIZE AND TYPE AS NOTED PENDANT MOUNTED LIGHT FIXTURE, SIZE AND TYPE AS NOTED 0 208Y/120V OR PANELBOARD (SURFACE), TOP MOUNTED 6'-0" AFF

480/277V PANELBOARD (SURFACE), TOP MOUNTED 6'-0" AFF DISTRIBUTION PANEL (SURFACE OR FLOOR MOUNTED) SURFACE MOUNTED EQUIPMENT, TYPE AS INDICATED ON PLANS GROUND

יי DISCONNECT SWITCH, SIZE AND TYPE AS NOTED, TOP MOUNTED 5'-0" AFF SINGLE POLE SWITCH, +3'-10" AFF TO CENTERLINE OF DEVICE BOX

LOW VOLTAGE SWITCH MOUNTING HEIGHT TO CENTERLINE OF DEVICE BOX; WATTAGE AS NOTED ON PLANS. D=DIMMING

MOTION SENSOR SWITCH, +3'-10" AFF TO CENTERLINE OF DEVICE BOX PHOTO CELL, SIZE AND TYPE AS NOTED

INDICATES RECEPTACLE ABOVE COUTERTOP. RE: PLANS

DUPLEX RECEPTACLE, +1'-6" AFF OR AS NOTED DUPLEX RECEPTACLE W/GROUND FAULT PROTECTION,+1'-6"

AFF OR AS NOTED GFI DUPLEX RECEPTACLE WITH WEATHERPROOF PLATE, HEIGHT AS NOTED DOUBLE DUPLEX RECEPTACLE, +1'-6" AFF OR AS NOTED USB DUPLEX RECEPTACLE, +1'-6" AFF OR AS NOTED HEAVY DUTY RECEPTACLE: VOLTAGE, PHASE, AND AMPS AS

NOTED, +1'-6" OR AS NOTED SQUARE RECESSED FLUSH FLOOR BOX WITH TYPE INDICATED, SEE SPECS. ⊢(J) OR (J) WALL OR CEILING MOUNTED JUNCTION BOX

CATV JUNCTION BOX WITH 3/4" CONDUIT STUBBED UP OUT OF BOX \vdash T \lor TO ABOVE ACCESSIBLE CEILING, +1'-6" AFF OR AS NOTED LOW VOLTAGE OUTLET WITH 3/4" CONDUIT STUBBED UP OUT OF BOX TO ABOVE ACCESSIBLE CEILING, +1'-6" AFF OR AS NOTED LOW/VOLTAGE OUTLET WITH 3/4" CONDUIT STUBBED UP OUT OF BOX

TO ABOVE ACCESSIBLE CEILING, INSTALLED ABOVE COUNTERTOP CEILING MOUNTED PHOTO-ELECTRIC SMOKE DETECTOR DUCT MOUNTED PHOTO-ELECTRIC SMOKE DETECTOR FIRE ALARM STROBE LIGHT, +6'-8" AFF

FIRE ALARM STROBE LIGHT, CEILING MOUNTED FIRE ALARM COMBINATION AUDIBLE/VISUAL WALL MOUNTED, +6'-8" AFF FIRE ALARM COMBINATION AUDIBLE/VISUAL CEILING MOUNTED (FLUSH) FIRE ALARM MANUAL PULL STATION, +3'-10" AFF

SPRINKLER ALARM SYSTEM TAMPER SWITCH FIRE AND SMOKE DAMPER; 120V, 1PH CARD READER; PROVIDE DOUBLE-GANG J-BOX WITH SINGLE GANG

FA CARBON MONOXIDE DETECTOR

PLASTER RING WITH 3/4"C STUBBED UP INSIDE WALL AND OUT TO ACCESSIBLE CEILING WITH BUSHING ON THE END,+3'-10" AFF OR AS NOTED INDOOR DOOR CONTACT (FLUSH MOUNTED) \square CAMERA

INDICATES WIRING DEVICE ABOVE, RE: DRAWING AHU-1 MECHANICAL EQUIPMENT CALL OUT HEIGHT TO CENTERLINE OF OUTLET BOX ABOVE FINISHED FLOOR +3'-10"

ABOVE FINISHED FLOOR FIRE ALARM FA CARBON MONOXIDE DETECTOR

A. REFER TO ARCHITECTS REFLECTED CEILING PLANS FOR EXACT PLACEMENT OF LIGHT FIXTURES, SPEAKER AND F.A. DEVICES IN THE CEILING SYSTEM.

GENERAL NOTES (TYPICAL ALL SHEETS)

- B. REFER TO ARCHITECTURAL DETAILS AND ELEVATIONS FOR COORDINATION OF LOCATION OF ALL WIRING DEVICES BEFORE ROUGH-IN OF J-BOXES.
- C. REFER TO ARCHITECTURAL PLANS FOR DETAIL OF ALL CONDUIT THRU ROOF
- PENETRATIONS. D. SUPPORT ALL LIGHT FIXTURES WITH A MINIMUM OF (2) 12 GA. HANGER WIRES TO
- STRUCTURE ABOVE. E. CONNECT EXIT AND EMERGENCY LIGHTS TO HOT LEG, NOT SWITCH LEG.
- F. ALIGN ALL WIRING DEVICES IN VERTICAL ALIGNMENT. IF ANY DEVICE(S) ARE FOUND NOT TO BE INSTALLED PER DETAIL CONTRACTOR SHALL RELOCATE AND PAY ALL ASSOCIATED COSTS ASSOCIATED WITH THE RELOCATION(S).
- G. LIGHTING INDICATED ABOVE EXIT DISCHARGE DOOR IS FOR MEANS OF EGRESS ILLUMINATION PER IBC 1006.1.

I. OUTLETS INSTALLED IN FIRE RATED ASSEMBLES SHALL BE SEPARATED BY A

- H. CONDUIT SHALL BE USED FOR CONDUCTORS WHERE REQUIRED BY N.E.C.
- HORIZONTAL DISTANCE OF NOT LESS THAN 24".
- J. CONTRACTOR SHALL CALCULATE VOLTAGE DROP AND SIZE WIRE ACCORDINGLY. PER
- K. PROVIDE 3'-0" CLEARANCE IN FRONT OF DISCONNECTS TO CONDENSING UNITS.

BOXES, PANELS ETC. THAT ARE LOCATED IN FIRE RATED WALLS AND SHALL FIRE CAULK

- . CONTRACTOR SHALL PROVIDE FIRE RATED ENCLOSURES AROUND ALL ROUGH-IN
- ALL OPENING IN RATED ASSEMBLES PER MANUFACTURERS RECOMMENDATIONS PER FIRE RATED ASSEMBLES.

M. PROVIDE HOUSE KEEPING PAD FOR ALL FLOOR MOUNTED EQUIPMENT.

- N. INSTALL FIRE ALARM DEVICES THAT COMPLY WITH APPLICABLE CODES. INCLUDING BUT NOT LIMITED TO THE FAIR HOUSING ACT, NFPA, UL, ADA, IBC OR ANY OTHER AUTHORITIES HAVING JURISDICTION.
- O. WHERE MORE THAN ONE SWITCH IS INDICATED ON DRAWINGS SIDE BY SIDE,
- CONTRACTOR SHALL INSTALL SWITCHES UNDER ONE COMMON FACE PLATE. P. CONTRACTOR MAY WIRE SO FIRST GFI OUTLET PROTECTS ALL DOWN STREAM OUTLETS.
- Q. REFERENCE EQUIPMENT CONNECTION SCHEDULE FOR CONNECTION REQUIREMENTS TO
- ALL EQUIPMENT LISTED ON THIS SHEET.
- R. WHERE THE DRAWINGS INDICATE DEDICATED CIRCUITRY WITH NO SHARED NEUTRALS, THE CONTRACTOR SHALL NOT INSTALL MULTI-WIRE BRANCH CIRCUITS WITH A COMMON NEUTRAL.



COMcheck Software Version COMcheckWeb

Interior Lighting Compliance Certificate

Project Information

2018 IECC Energy Code: MWSU - CTAC BLDG Project Title: Project Type: New Construction

Construction Site: Owner/Agent: 4525 Downs Drive Missouri Western State University St.Joseph, Missouri 64501 Additional Efficiency Package(s)

Lankford | Fendler + associates 1730 Walnut St. LIBERTY, Missouri 64108 8162211411 Brian@lankfordfendler.com

Designer/Contractor:

Credits: 1.0 Required 0.0 Proposed

Area Category 1-Common Space Types:Workshop

Proposed Interior Lighting Power # of Fixture (C X D) Fixture Fixture Watt. 1-Common Space Types:Workshop LED: A: 2x2: Other: LED: B: 4' STRIP: Other: LED: C: 8' STRIP: Other: LED: D: 8' STRIP: Other: 130 3120 LED: F: 4' LONG PENDANT: Other:

Statement

LED: G: 2' LONG PENDANT: Other:

Compliance Statement: The proposed interior lighting design represented in this document is consistent with the building plans, specifications, and other calculations submitted with this permit application. The proposed interior lighting systems have been designed to meet the 2018 IECC requirements in COMcheck Version COMcheckWeb and to comply with any applicable mandatory requirements listed in the Inspection Checklist. Brian Day, Electrical Designer

Project Title: MWSU - CTAC BLDG

Data filename:

Report date: 05/24/23

NO. REVISION DESCRIPTION

DATE

05.23.2023

ALAN W. LANKFORD

NUMBER

ELLISON - AUXIER

924 FRANCIS ST.

ST. JOSEPH, MO 64501

P: 816-233-8003 F: 816-233-7793

www.ellison-auxier.com

CONSULTANTS

ARCHITECTS

NO. ISSUE DESCRIPTION

ADDENDUM #3

ELECTRICAL SCHEDULES,

GENERAL NOTES & SYMBOLS. & RISER SHEET:

1730 Walnut Street Kansas City, Missouri 64108 Fax: 816.221.1429 L|F+a Project No. 22.7184.00

13. PROVIDE WITH CAM LOCK PROTECTIVE CAPS. CAPS TO BE SECURED TO THE DISCONNECT WITH PROTECTIVE CORD ATTACHMENT. 14. INSTALL 2" PVC CONDUIT STUBBED OUT WEST 5' FROM THE BUILDING AND CAPPED. INSTALL GROUND WIRE FOR FUTURE TRACING.

15. PROVIDE TVSS UNIT FOR MAIN DISTRIBUTION PANEL.

® RISER PLAN NOTES

1. REFERENCE CIVIL PLAN FOR TRANSFORMER LOCATION AND PRIOR FEED.

2. INSTALL (4) SETS OF 4-#350 (75-DEGREE CU) CONDUCTORS IN 4"C.

REFERENCE MAIN SERVICE ENTRANCE GROUNDING DETAIL.

4. INSTALL C.T. CABINET, METER, AND GROUNDING PER EVERGY STANDARDS.

6. INSTALL 3-#4/0 (75-DEGREE CU) & 1-#3 (75-DEGREE CU) GROUND WIRE. 2"C.

7. INSTALL 150 KVA, 480-208/120V TRANSFORMER AND GROUND PER NEC.250 WITH #8 GROUND WIRE.

8. INSTALL (2) SETS OF 4-#250 (75-DEGREE CU) & 1-#3 (75-DEGREE CU) GROUND WIRE IN 3"C.

9. STACK TRANSFORMERS. CONSULATE WITH A STRUCTURAL ENGINEER AND PROVIDE STRUCTURE TO SUPPORT TRANSFORMER.

10. INSTALL 4-#1/0 (75-DEGREE CU) & 1-#8 (75-DEGREE CU) GROUND WIRE IN 2" PVC CONDUIT. 11. INSTALL 250V RATED, 100A/3P FUSED SAFETY SWITCH IN A NEMA TYPE 1 ENCLOSURE. FROM PANEL, INSTALL 4-#3 (75-DEGREE CU) & 1-#8 (75-DEGREE CU) GROUND WIRE IN 2" CONDUIT. ON THE BOTTOM OF THE DISCONNECT INSTALL 208/120V CAM LOCK COLOR-CODED RECEPTACLES WITH PROTECTIVE

3. PROVIDE 4-4" PVC CONDUITS STUBBED OUT 5' FROM TRANSFORMERS TO THE WEST CAN CAP FOR FUTURE USAGE. INSTALL #6 GROUND WIRE FOR FUTURE TRACING.

12. INSTALL 600V RATED, 100A/3P FUSED SAFETY SWITCH IN A NEMA TYPE 1 ENCLOSURE. FROM PANEL, INSTALL 4-#3 (75-DEGREE CU) & 1-#8 (75-DEGREE CU) GROUND WIRE IN 2" CONDUIT. ON THE BOTTOM OF THE DISCONNECT INSTALL 480/277V CAM LOCK COLOR-CODED RECEPTACLES WITH PROTECTIVE

ELECTRICAL RISER DIAGRAM